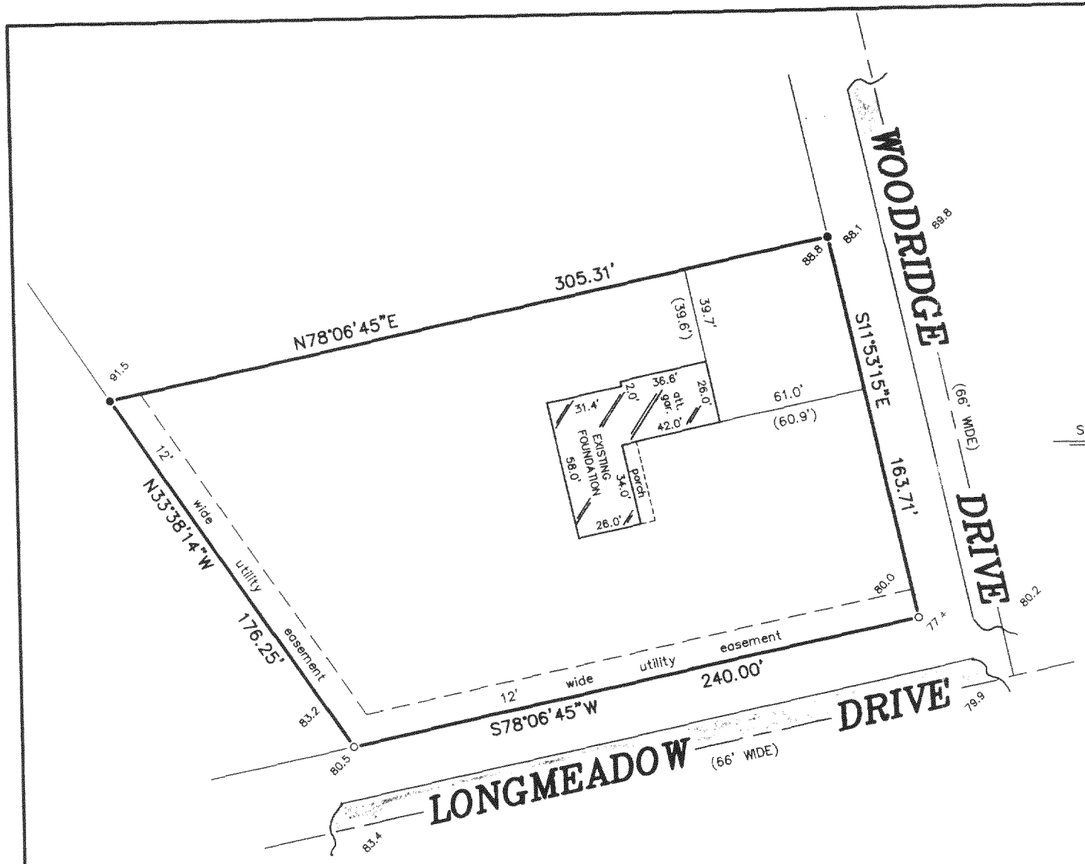


SCALE: 1" = 60'

PLAT OF SURVEY
-OF-

LOT 7, BLOCK 3, ALPINE TOWER ESTATES, A SUBDIVISION LOCATED IN THE NORTHEAST 1/4 OF SECTION 13, TOWN 3 NORTH, RANGE 17 EAST, TOWN OF LAFAYETTE, COUNTY OF WALWORTH, STATE OF WISCONSIN.

SURVEY FOR: DUANE GOETSCH

PROPOSED ADDRESS: _____ WOODRIDGE DRIVE

EXISTING TOP OF FOUNDATION: ELEV. = 88.0

I HEREBY CERTIFY THAT THE EXISTING FOUNDATION SHOWN ON THIS PLAT OF SURVEY IS LOCATED AS SHOWN THUS ( ), DATED THIS 25TH DAY OF AUGUST, 2004.

Franklin J. Lehman

FRANKLIN J. LEHMAN S-2211

WISCONSIN
FRANKLIN J. LEHMAN S-2211 BURLINGTON WIS.
LAND SURVEYOR

RECEIVED MAR 3 1 2005

THIS IS NOT AN ORIGINAL PRINT UNLESS THIS SEAL IS RED.

Franklin J. Lehman

FRANKLIN J. LEHMAN S-2211

JULY 28, 2004 DATE

6489 JOB NUMBER

LEGEND

- o FOUND IRON PIPE
- ● SET IRON PIPE
- 100.0 EXISTING ELEVATION

B.W. SURVEYING, INC.

412 N. PINE STREET
BURLINGTON, WI 53105
(262)-767-0225

"I hereby certify that I have surveyed the above described property and that the above map is a correct representation thereof and shows the size and location of the property, its exterior boundaries, the location of all visible structures and dimensions of all principal buildings thereon, boundary fences, apparent easements, roadways and encroachments, if any."

"This survey is made for the use of the present owners of the property, and those who purchase, mortgage, or guarantee the title thereto within one year from date hereof."

317-78

CAT 0661