LAND-MARK SURVEYING
Mark L. Miritz
Wisconsin Registered Land Surveyor S-2582


N9330 Knuteson Drive
Whitewater, WI 53190
Phone:(262)495-3284
FAX : (262) 495-8421
LAND-MARKSURVEYING.COM

PLAT OF SURVEY

LOT 2 CERTIFIED SURVEY MAP NO. 2068, LOCATED IN THE NORTHEAST 1/4 OF THE SOUTHWEST 1/4 OF SECTION 19, TOWN 3 NORTH, RANGE 17 EAST, WALWORTH COUNTY, WISCONSIN.

ORDERED BY: SUE MILLER
WHISPERING OAKS REALTY
P.O. BOX 961
EAST TROY, WI. 53120

OWNERS: MARSHALL B. KETCHPAW
SUSAN L. KETCHPAW
W4715 POTTER RD.
ELKHORN, WI. 53121

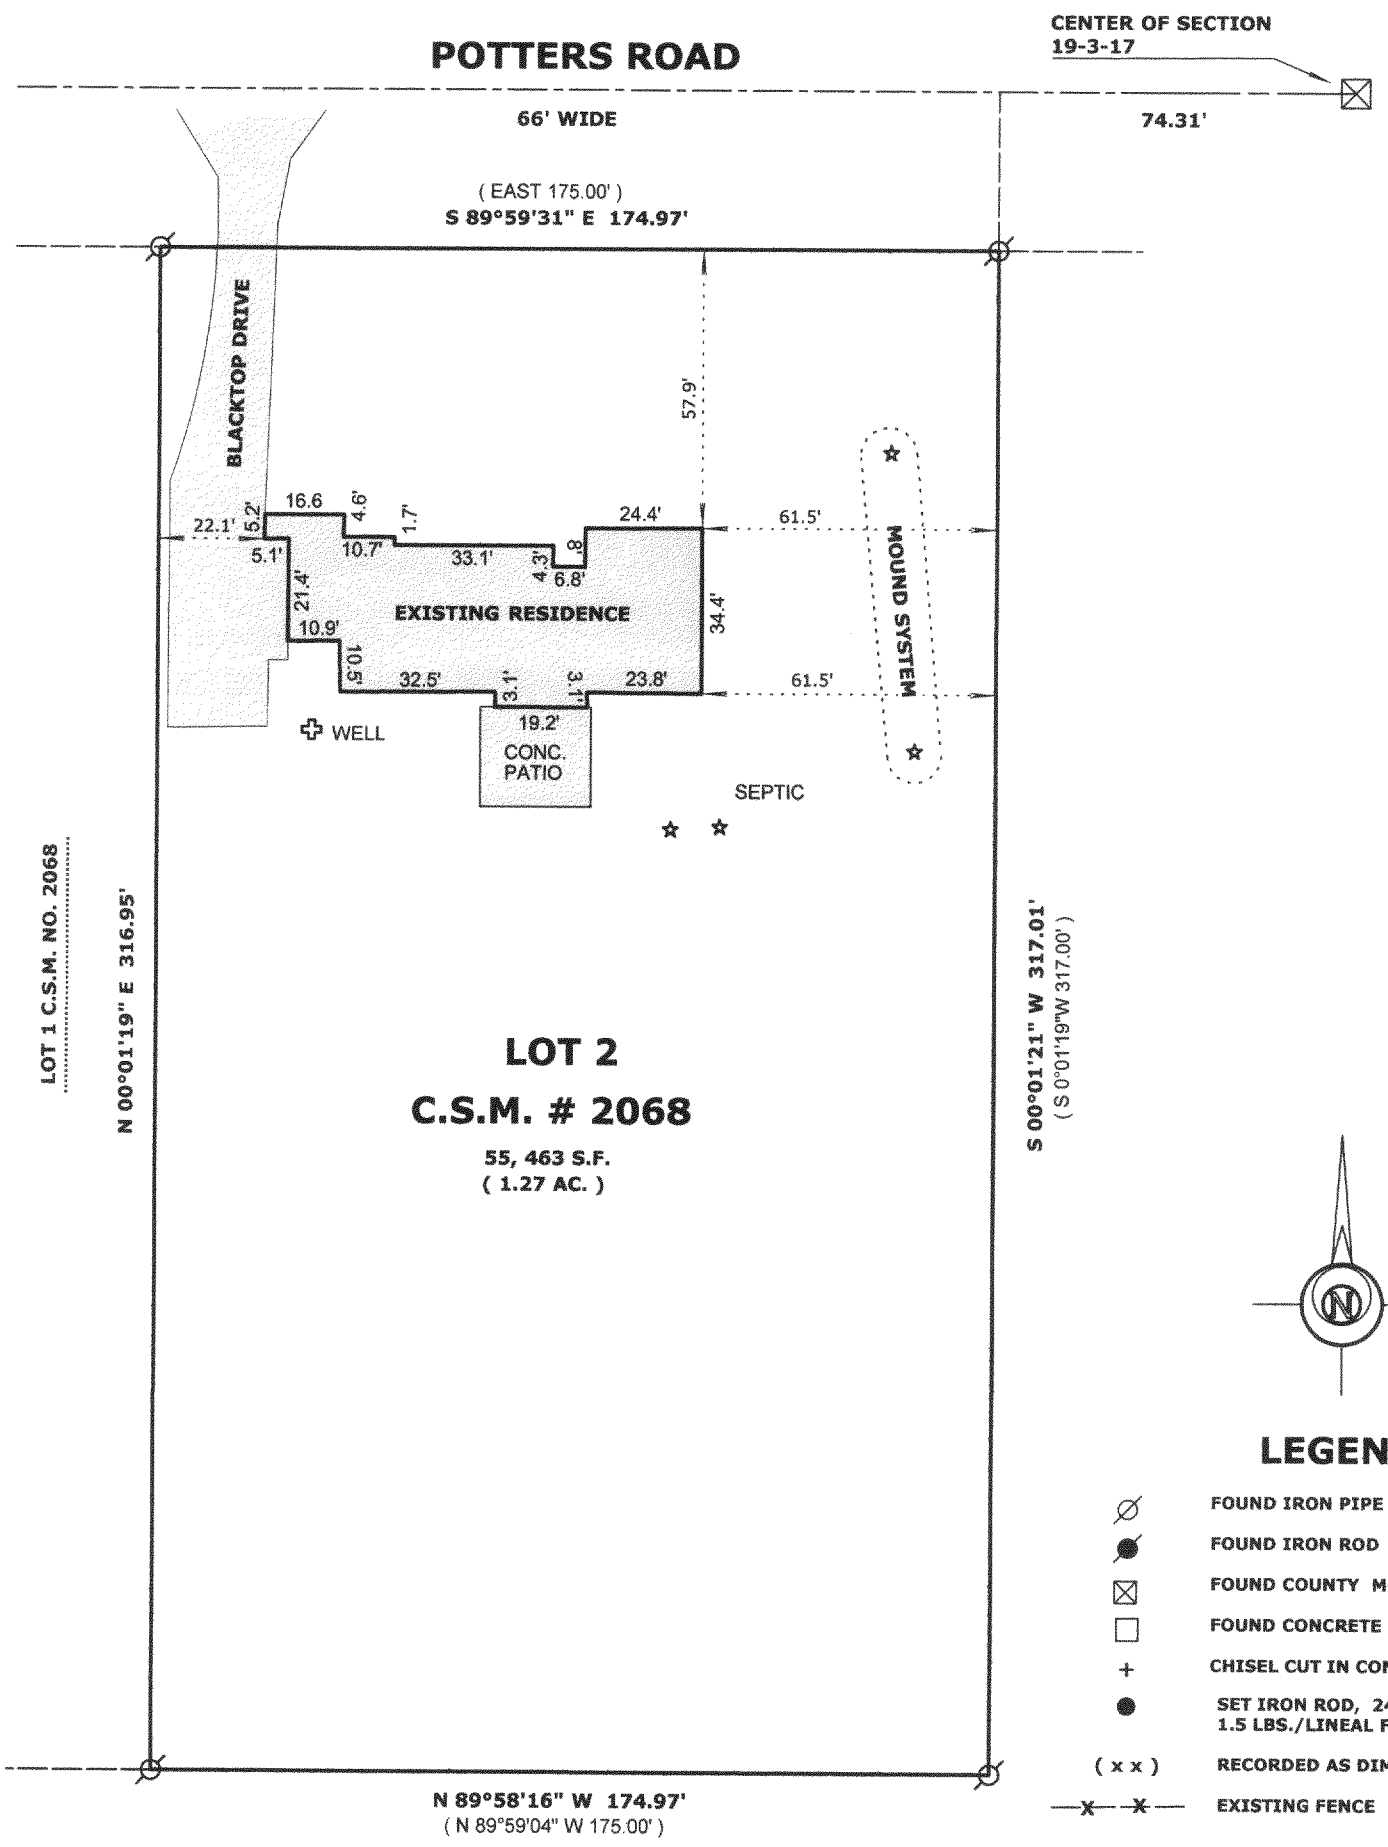

LEGEND

⌀	FOUND IRON PIPE
●	FOUND IRON ROD
⊠	FOUND COUNTY MONUMENT
□	FOUND CONCRETE MONUMENT
+	CHISEL CUT IN CONCRETE
●	SET IRON ROD, 24" LONG, WEIGHING 1.5 LBS./LINEAL FT., 3/4" DIA.
(x x)	RECORDED AS DIMENSION
—x—x—	EXISTING FENCE

SCALE: 1" = 40 FEET

"I hereby certify that the above described property has been surveyed by me or under my direction and that the above map is a true representation thereof and shows the size and location of the property, its exterior boundaries, the location of all visible structures and dimensions of all principal buildings thereon, boundary fences, apparent easements, roadways and visible encroachments, if any."
"This survey is made for the use of the present owners of the property, and also those who purchase, mortgage, or guarantee the title thereto within one year from date hereof."

Mark L. Miritz

MARK L. MIRITZ
WISCONSIN REGISTERED
LAND SURVEYOR S-2582

JUL 26 2005

WISCONSIN
MARK L. MIRITZ
S-2582
WHITEWATER, WI
LAND SURVEYOR

DATE: JUNE 9, 2005 **JOB NO.** 05.603

KA2068-2

317-806