
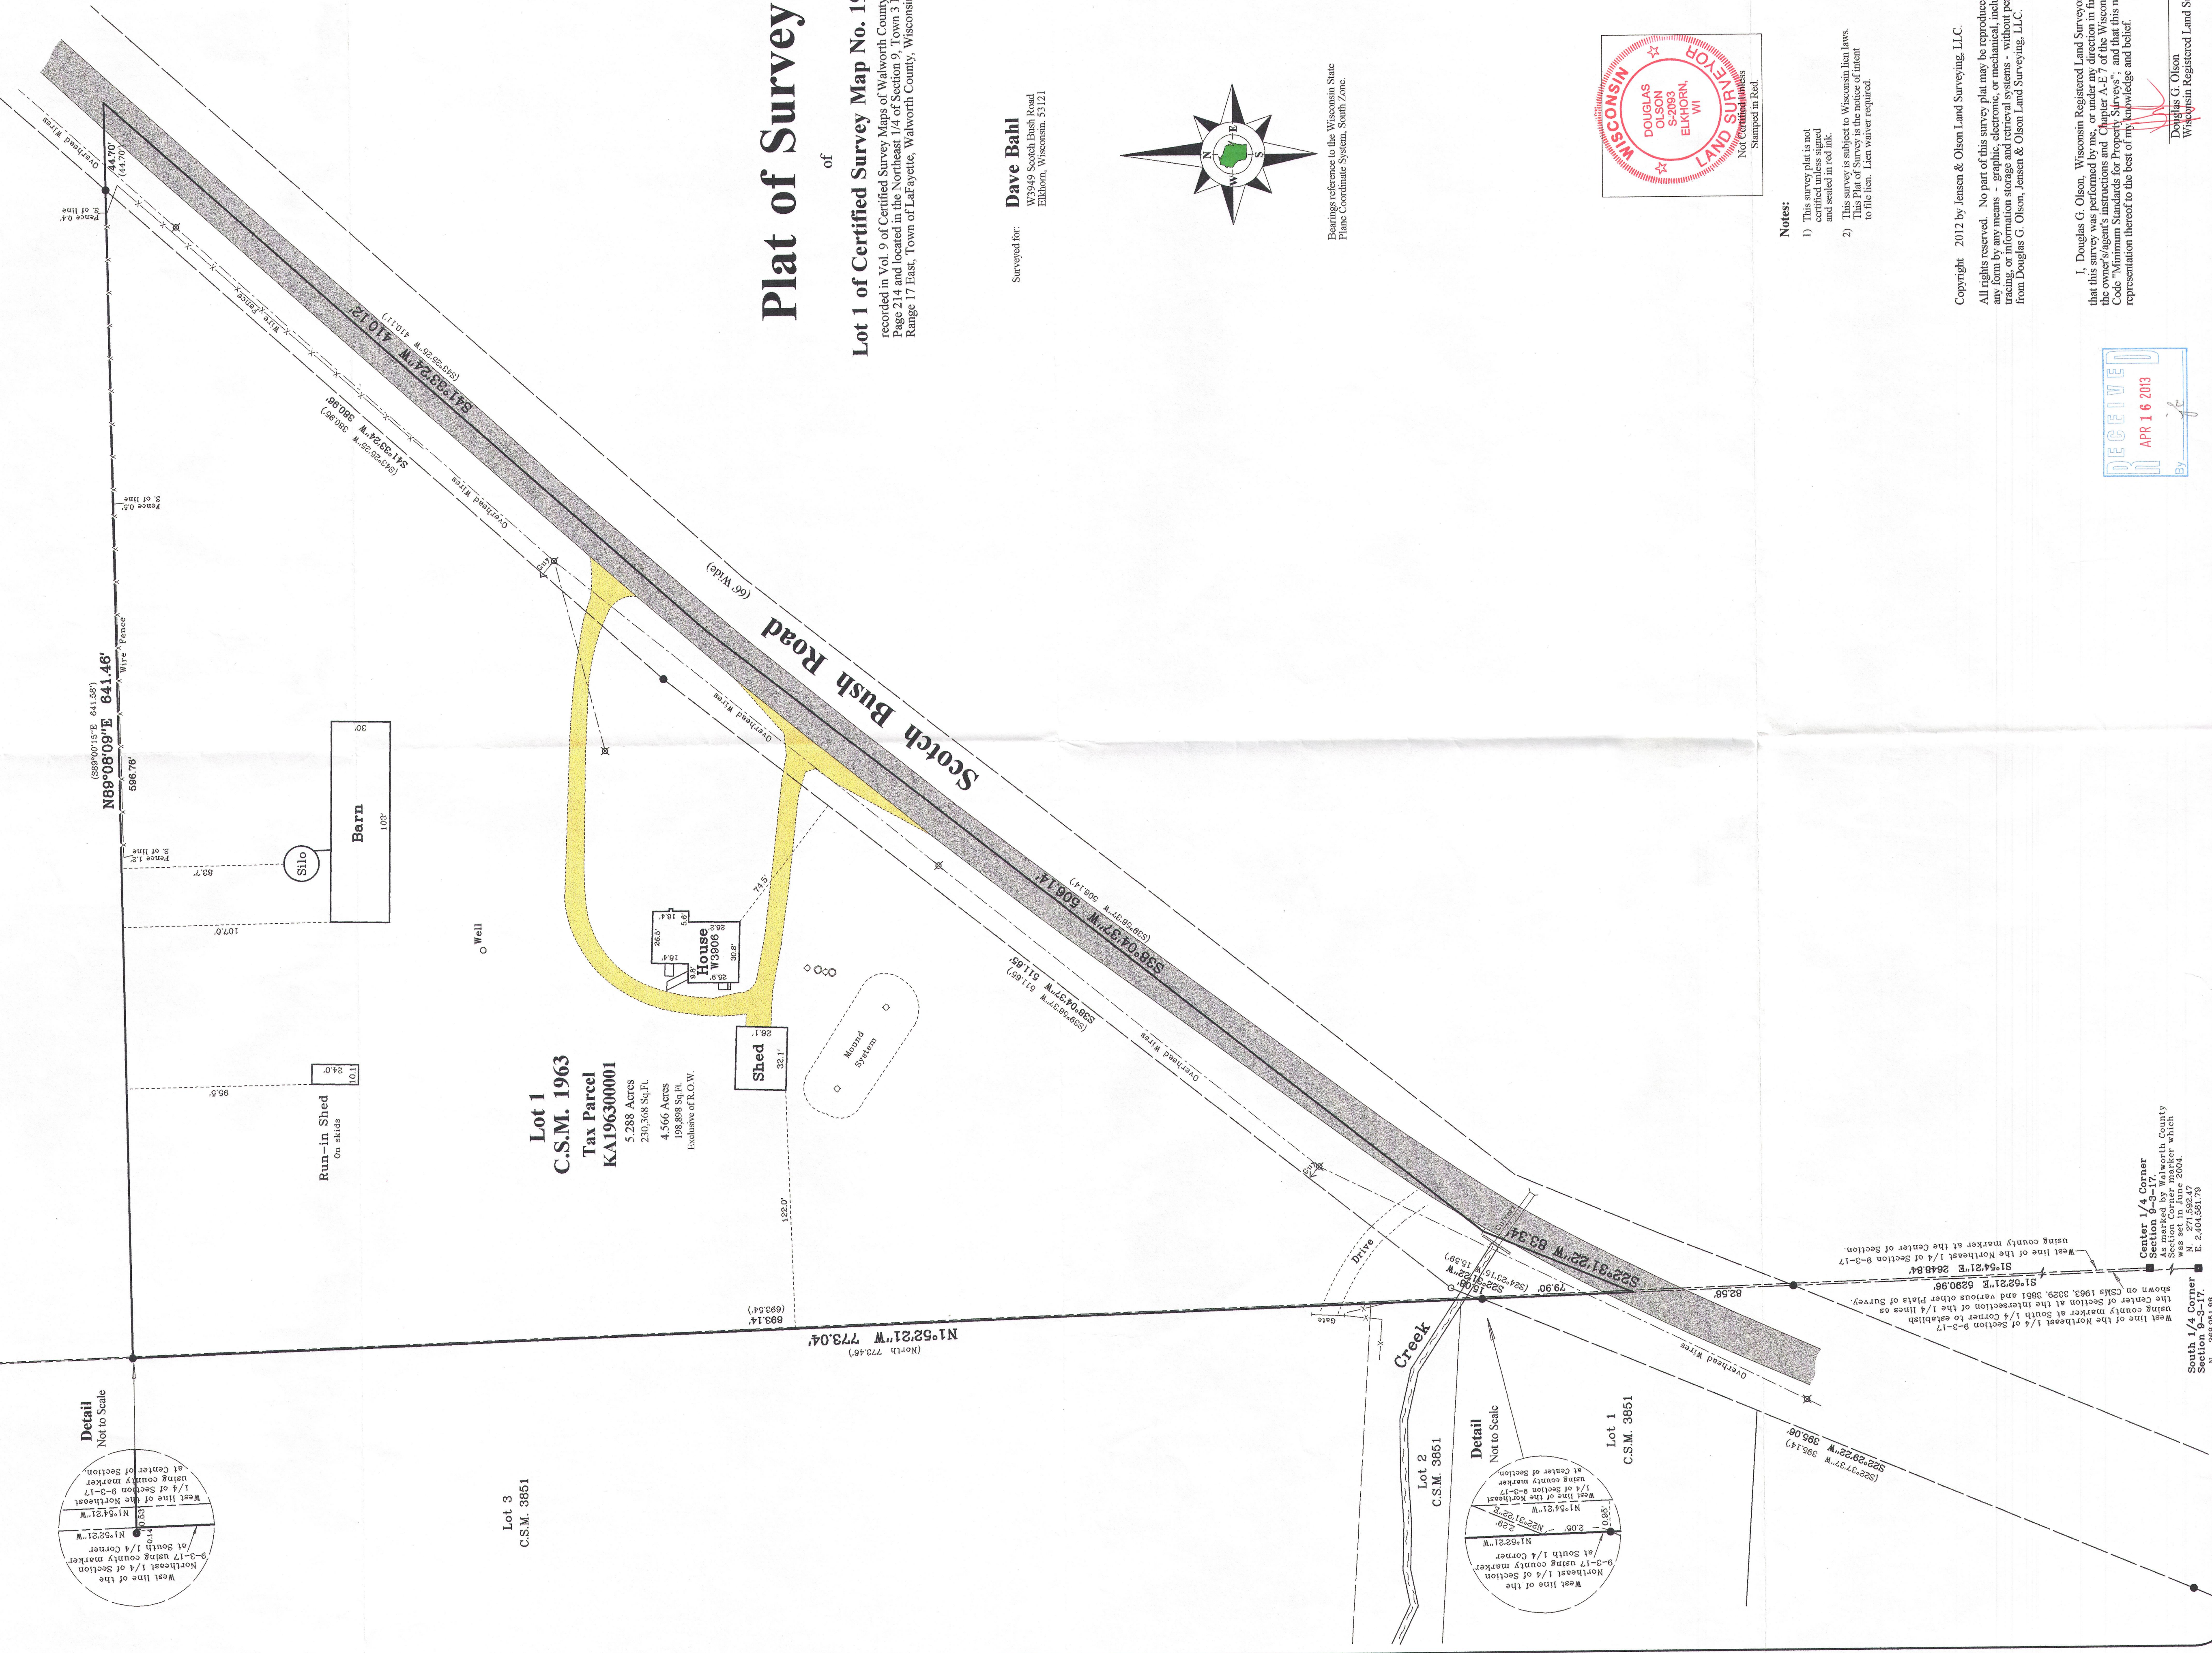


Northwest Corner
Section 9-3-17,
E. 2, 401,823.53
N. 89°57'30" W. 2869.88'


Tax Parcel
KLF 900002

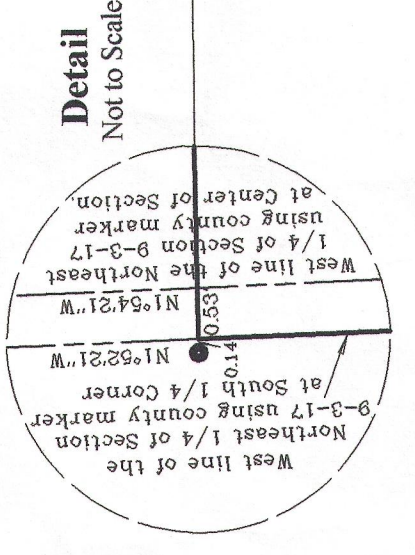


Lot 1
C.S.M. 1963
Tax Parcel
KA196300001
5.288 Acres
230,368 Sq. Ft.
4.566 Acres
198,898 Sq. Ft.
Exclusive of E.O.W.

Scotch Bush Road
(66' Wide)

Surveyed for:
Dave Bahl
W3949 Scotch Bush Road
Elkhorn, Wisconsin 53121

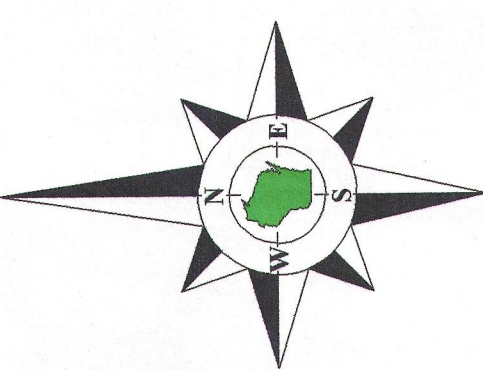

Based on reference to the Wisconsin State
Plane Coordinate System, South Zone.

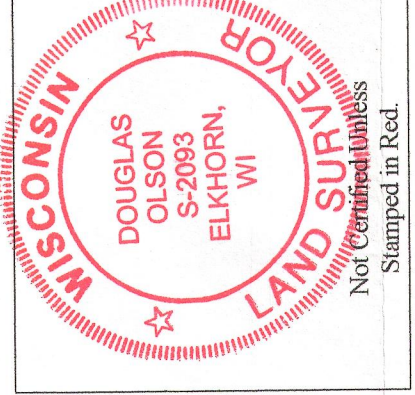

Notes:
1) This survey plat is not
2) This survey is subject to Wisconsin lien laws.
This Plat of Survey is the notice of intent
to file lien. Lien waiver required.

Copyright 2012 by Jensen & Olson Land Surveying, LLC.
All rights reserved. No part of this survey plat may be reproduced or transmitted in
any form by any means - graphic, electronic, or mechanical, including photocopying,
recording, or by any information storage and retrieval system, without permission in writing
from Douglas G. Olson, Jensen & Olson Land Surveying, LLC.

I, Douglas G. Olson, Wisconsin Registered Land Surveyor, do hereby certify
that this survey was performed by me, or under my direction in full compliance with
the owner's agent's instructions and Chapter A-E 7 of the Wisconsin Administrative
Code "Minimum Standards for Property Surveys", and that this map is an accurate
representation thereof to the best of my knowledge and belief.

Douglas G. Olson
Wisconsin Registered Land Surveyor - 2093



Jensen & Olson Land Surveying, LLC

45 South Wisconsin Street * P.O. Box 322 * Elkhorn, Wisconsin. 53121
Telephone: (262) 723-3434 * Facsimile: (262) 723-8044
Email: jensen.olson@elknet.net

Legend

- Found County Section Corner
- Found Iron Pipe
- Set Iron Pipe, 1" dia.
- Recorded Information
- Concrete Corner
- Septic Vent
- Concrete Surface
- Gravel Surface

Sheet 1 of 1 Sheets


Job Reference Number

2012.116

2012.116

Survey date: November 6, 2012.
Revisions:

Scale in Feet
1" = 40'

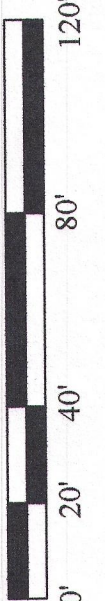

KA196300001 317-964
KA444700001