

Property Exhibit

of

Lot 1 of Certified Survey Map No. 4574,


recorded in Vol. 30 of Certified Survey Maps of Walworth County on Page 67 and located in the Southwest 1/4 of Section 21, Town 3 North, Range 17 East, Town of LaFayette, Walworth County, Wisconsin.

and


A Portion of Tax Parcel KLF 2100007,

located in the Northwest 1/4 of the Southwest 1/4 of Section 21, Town 3 North, Range 17 East, Town of LaFayette, Walworth County, Wisconsin.

Surveyed for: **Kevin Robers**
W4050 State Highway 11
Elkhorn, Wisconsin. 53121

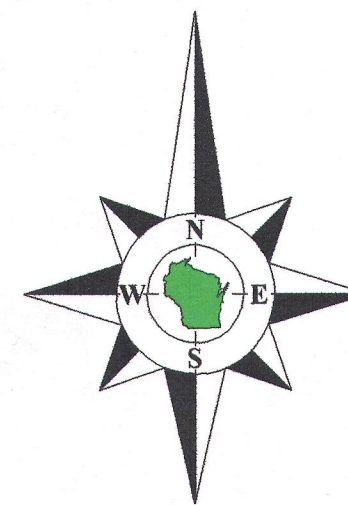

Bearings reference to the Wisconsin State Plane Coordinate System, South Zone.

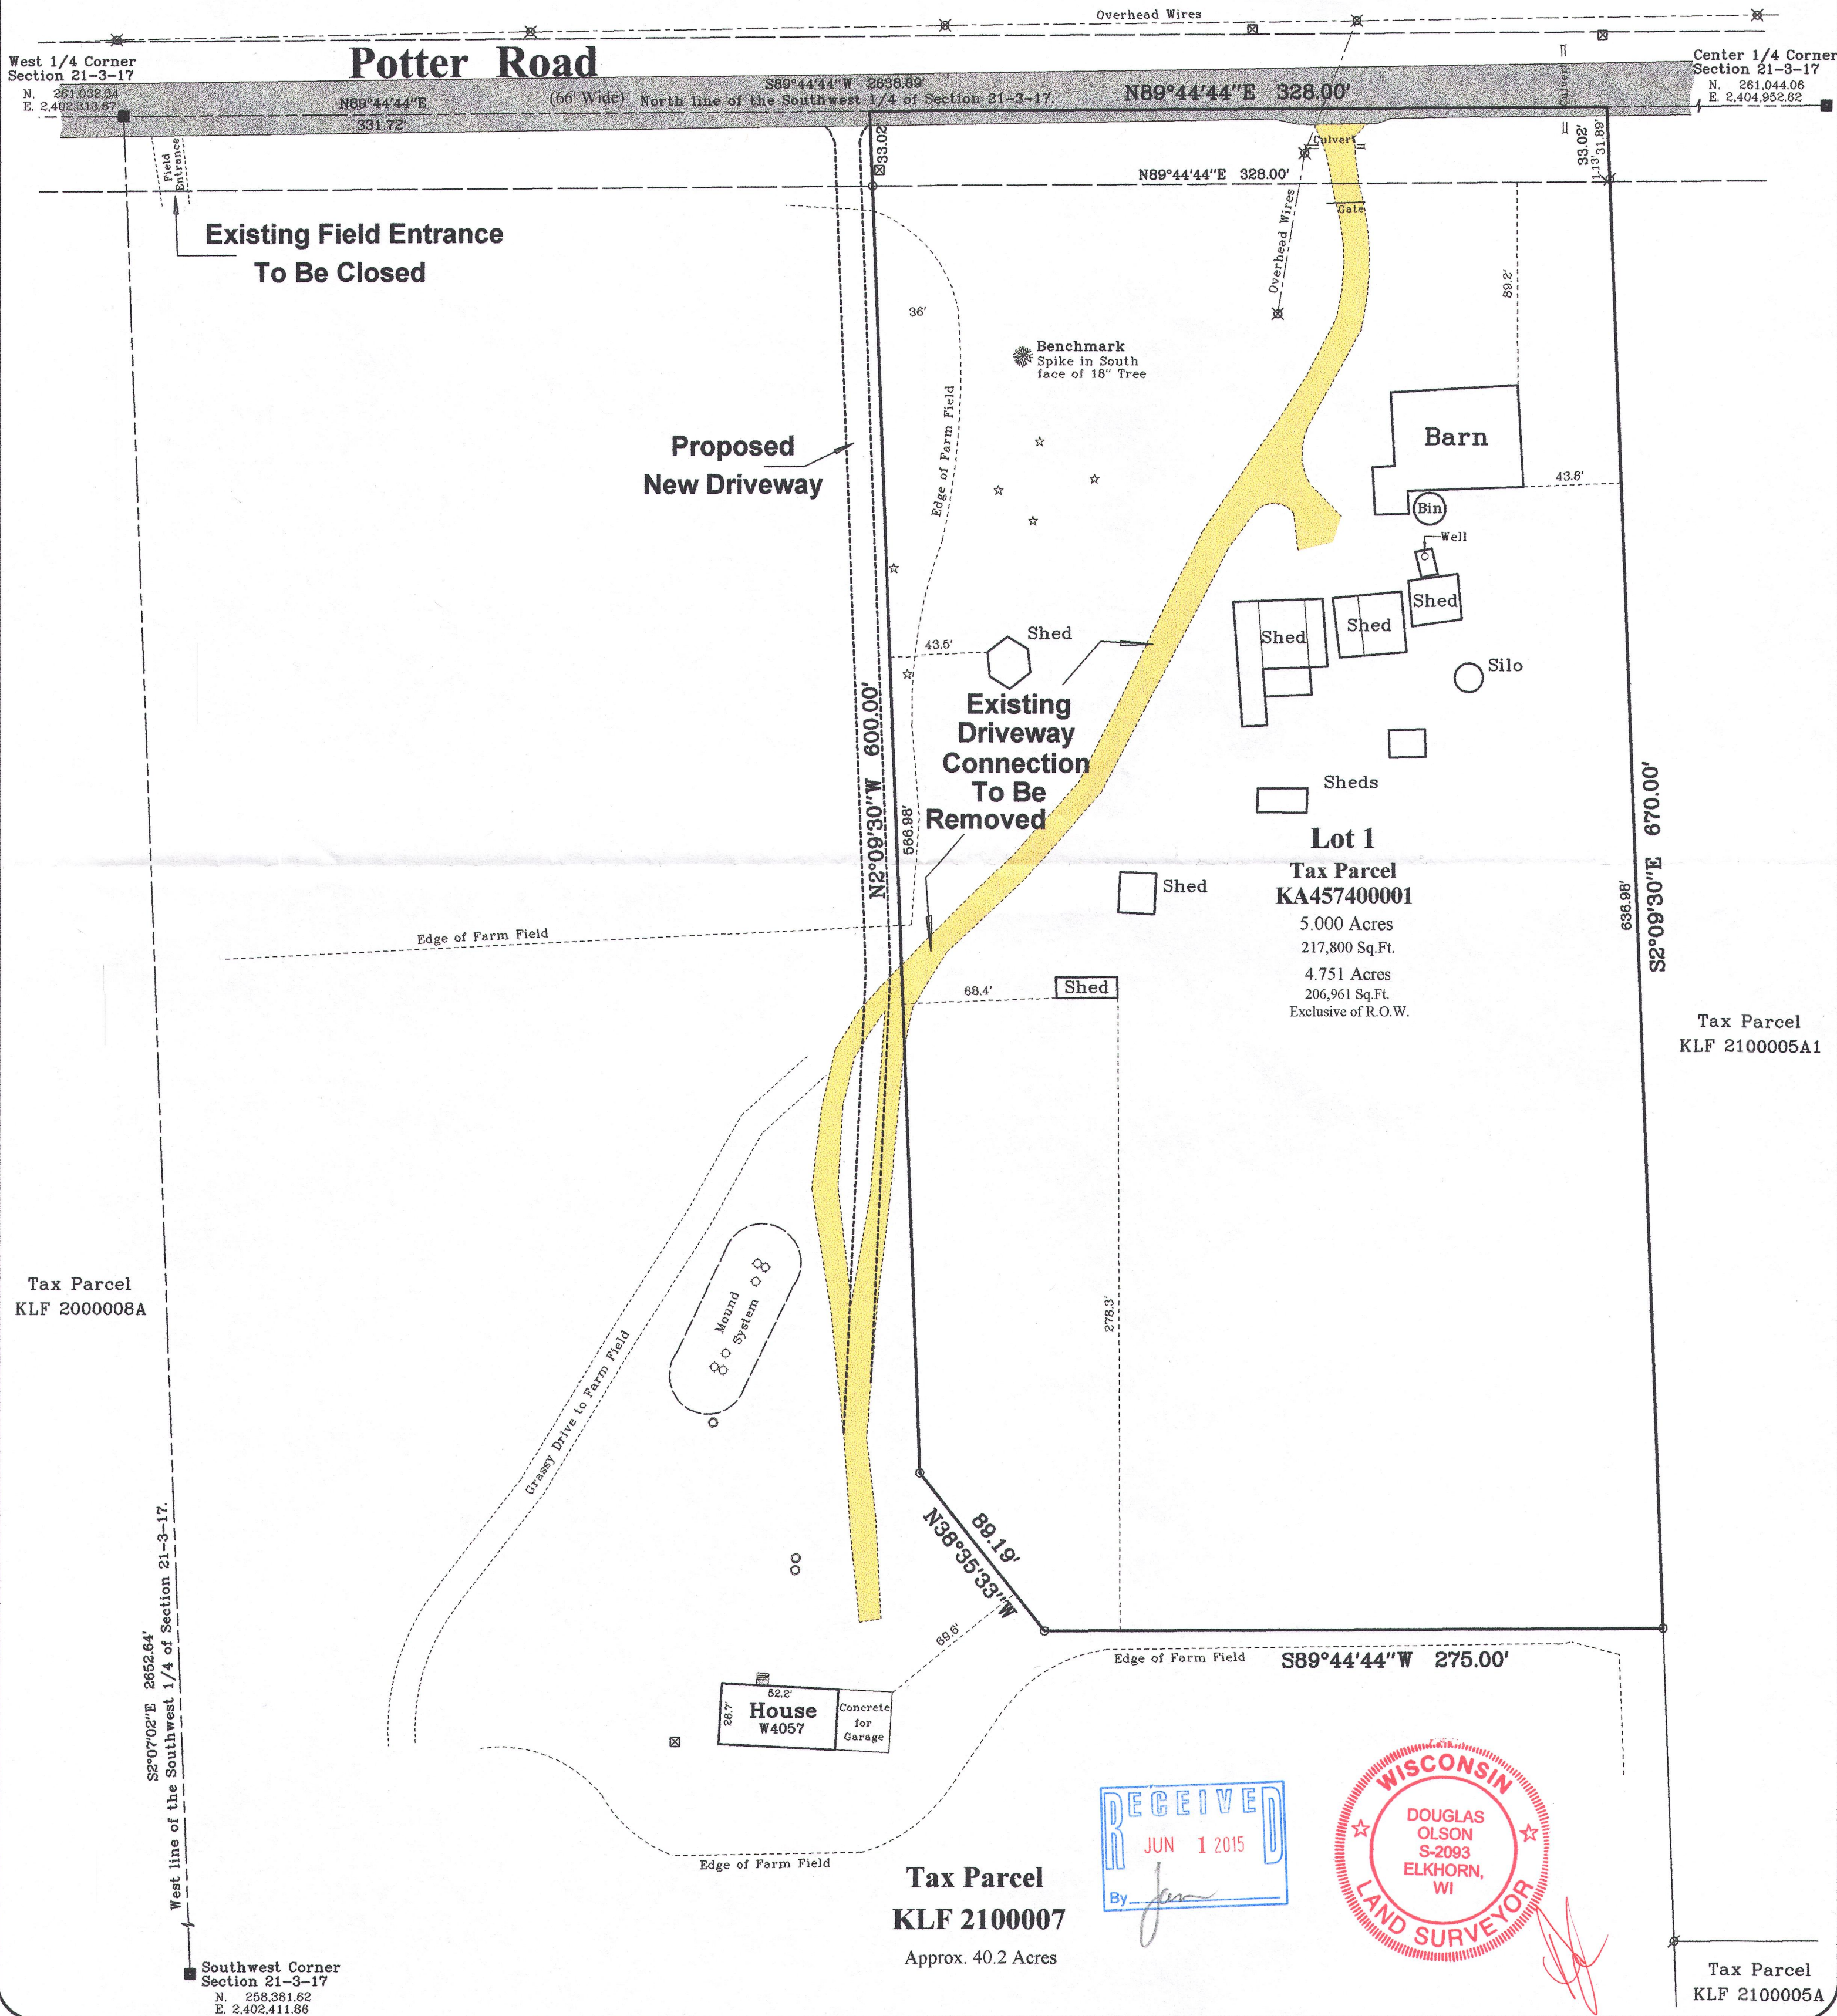

Tax Parcel
KLF 2000008A

Lot 1
Tax Parcel
KA457400001
5.000 Acres
217,800 Sq.Ft.
4.751 Acres
206,961 Sq.Ft.
Exclusive of R.O.W.

Tax Parcel
KLF 2100005A1

Tax Parcel
KLF 2100007
Approx. 40.2 Acres

Tax Parcel

2014.059	Sheet 1 of 1 Sheets	Legend - Found County Section Corner - Found Iron Pipe - Set Iron Pipe, 1" dia. - Recorded Information - Utility Pole - Soil Boring - Utility Box or Pedestal - Concrete Cover - Septic Vent - Asphalt Surface - Concrete Surface - Gravel	Jensen & Olson Land Surveying, LLC 45 South Wisconsin Street * P.O. Box 322 * Elkhorn, Wisconsin. 53121 Telephone: (262) 723-3434 * Facsimile: (262) 723-8044 Email: jensen.olson@elknet.net	Scale in Feet 1" = 50' 0' 25' 50' 100'	Survey Date: July 31, 2014. Revisions: No. 1 - Proposed Driveway No. 2 - Soil Borings No. 3 - Recorded CSM
	Drawing Name:				
	Job Reference Number 2014.059				

KLF21-7

KA4574-1

312-994