
42 & 69

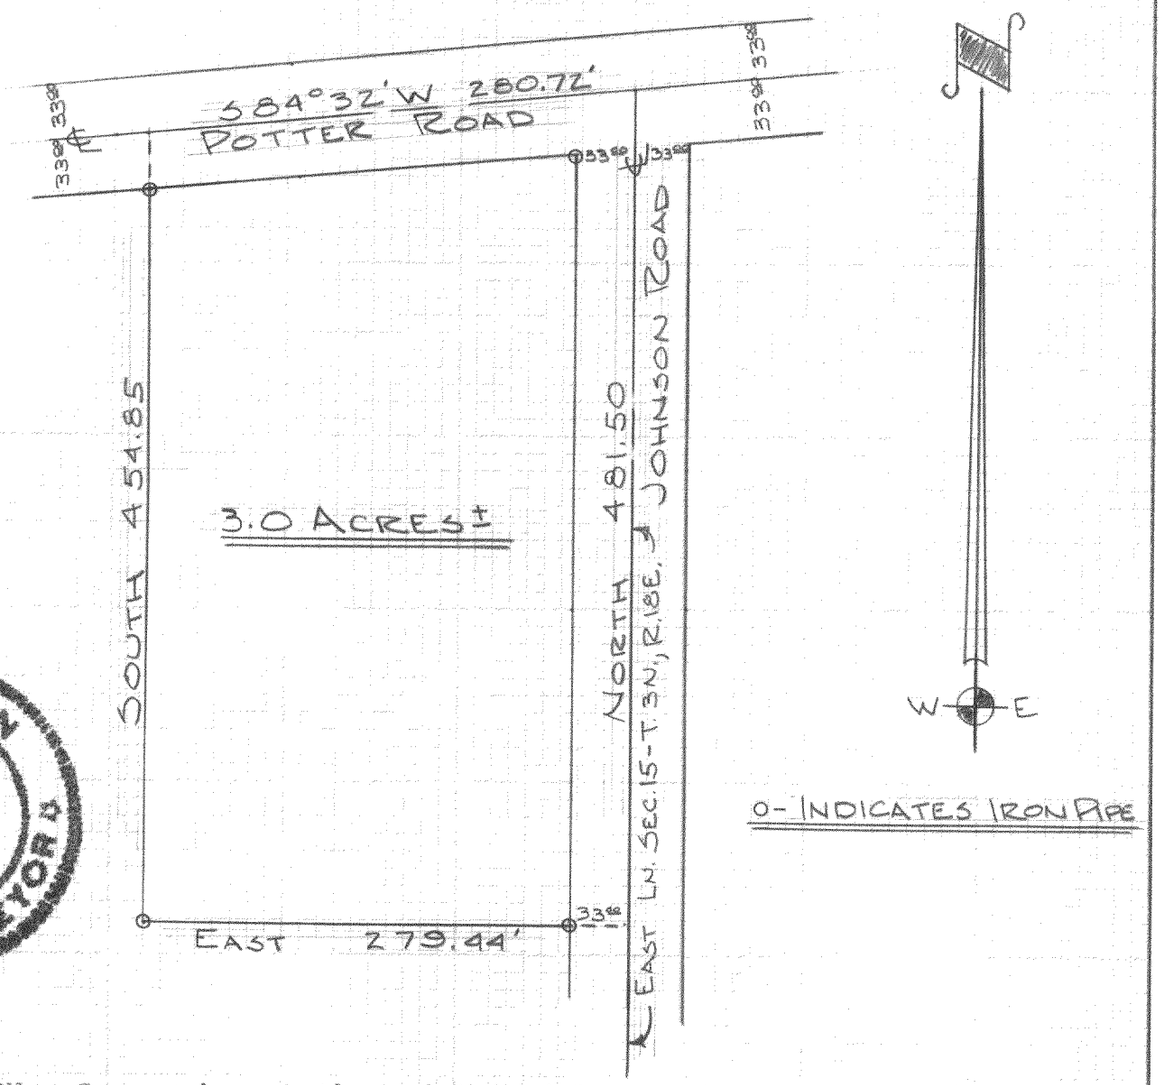


WISCONSIN
JAMES F. BIAGI
WALWORTH WIS.
LAND SURVEYOR

o- INDICATES IRON PIPE

DESCRIPTION: Commencing at the point in intersection of the center line of Potter Road and the East line of Section 15, T. 3 N., R. 18 E., Walworth County, Wisconsin; thence S. 84° 32' W. along the center line of Potter Road, 280.72 feet, thence South parallel to the East line of said section 454.85 feet to the South line of said section, thence East along the south line of said section 279.44 feet, to the East line of said section, (the center line of Johnson Road) thence North along the East line of section 15, 481.50 feet to the place of beginning, containing 3.0 acres of land more of less.

CERTIFICATE: I, James F. Biagi, surveyor, do hereby certify that I have surveyed the property hereon described.

October 28, 1969

James F. Biagi, R.L.S. 272

A91-813

SR-15-10-(part of) T.C.L. 280

318-10A