

PLAT OF SURVEY

LEGEND

- IRON PIPE FOUND
- ▲ TRAVERSE POINT
- UTILITY POLE
- WELL
- ⊕ SEPTIC VENT
- ⊗ SPOT ELEVATION
- DECIDUOUS TREE
- ⊗ CONIFEROUS TREE

ZONING LINE ————
FLOOD HAZARD ————


AS PRINTED IN FEMA FIRM
COMMUNITY PANEL NO.
550462 0085 B, DATED
AUGUST 15, 1983
PER CSM 3796

W677 POTTER ROAD, BURLINGTON, WISCONSIN.


LOT 1 OF CERTIFIED SURVEY MAP NUMBER 3796, BEING
A DIVISION OF PART OF THE SOUTHWEST 1/4 OF THE SOUTHEAST
1/4 OF SECTION 14, TOWN 3 NORTH, RANGE 18 EAST, IN THE
TOWN OF SPRING PRAIRIE, WALWORTH COUNTY, WISCONSIN.

SAID LANDS CONTAIN 221,344 SQUARE FEET OR 5.0814 ACRES.

CLIENT: LUCAS & KINSEY QUERNEMOEN

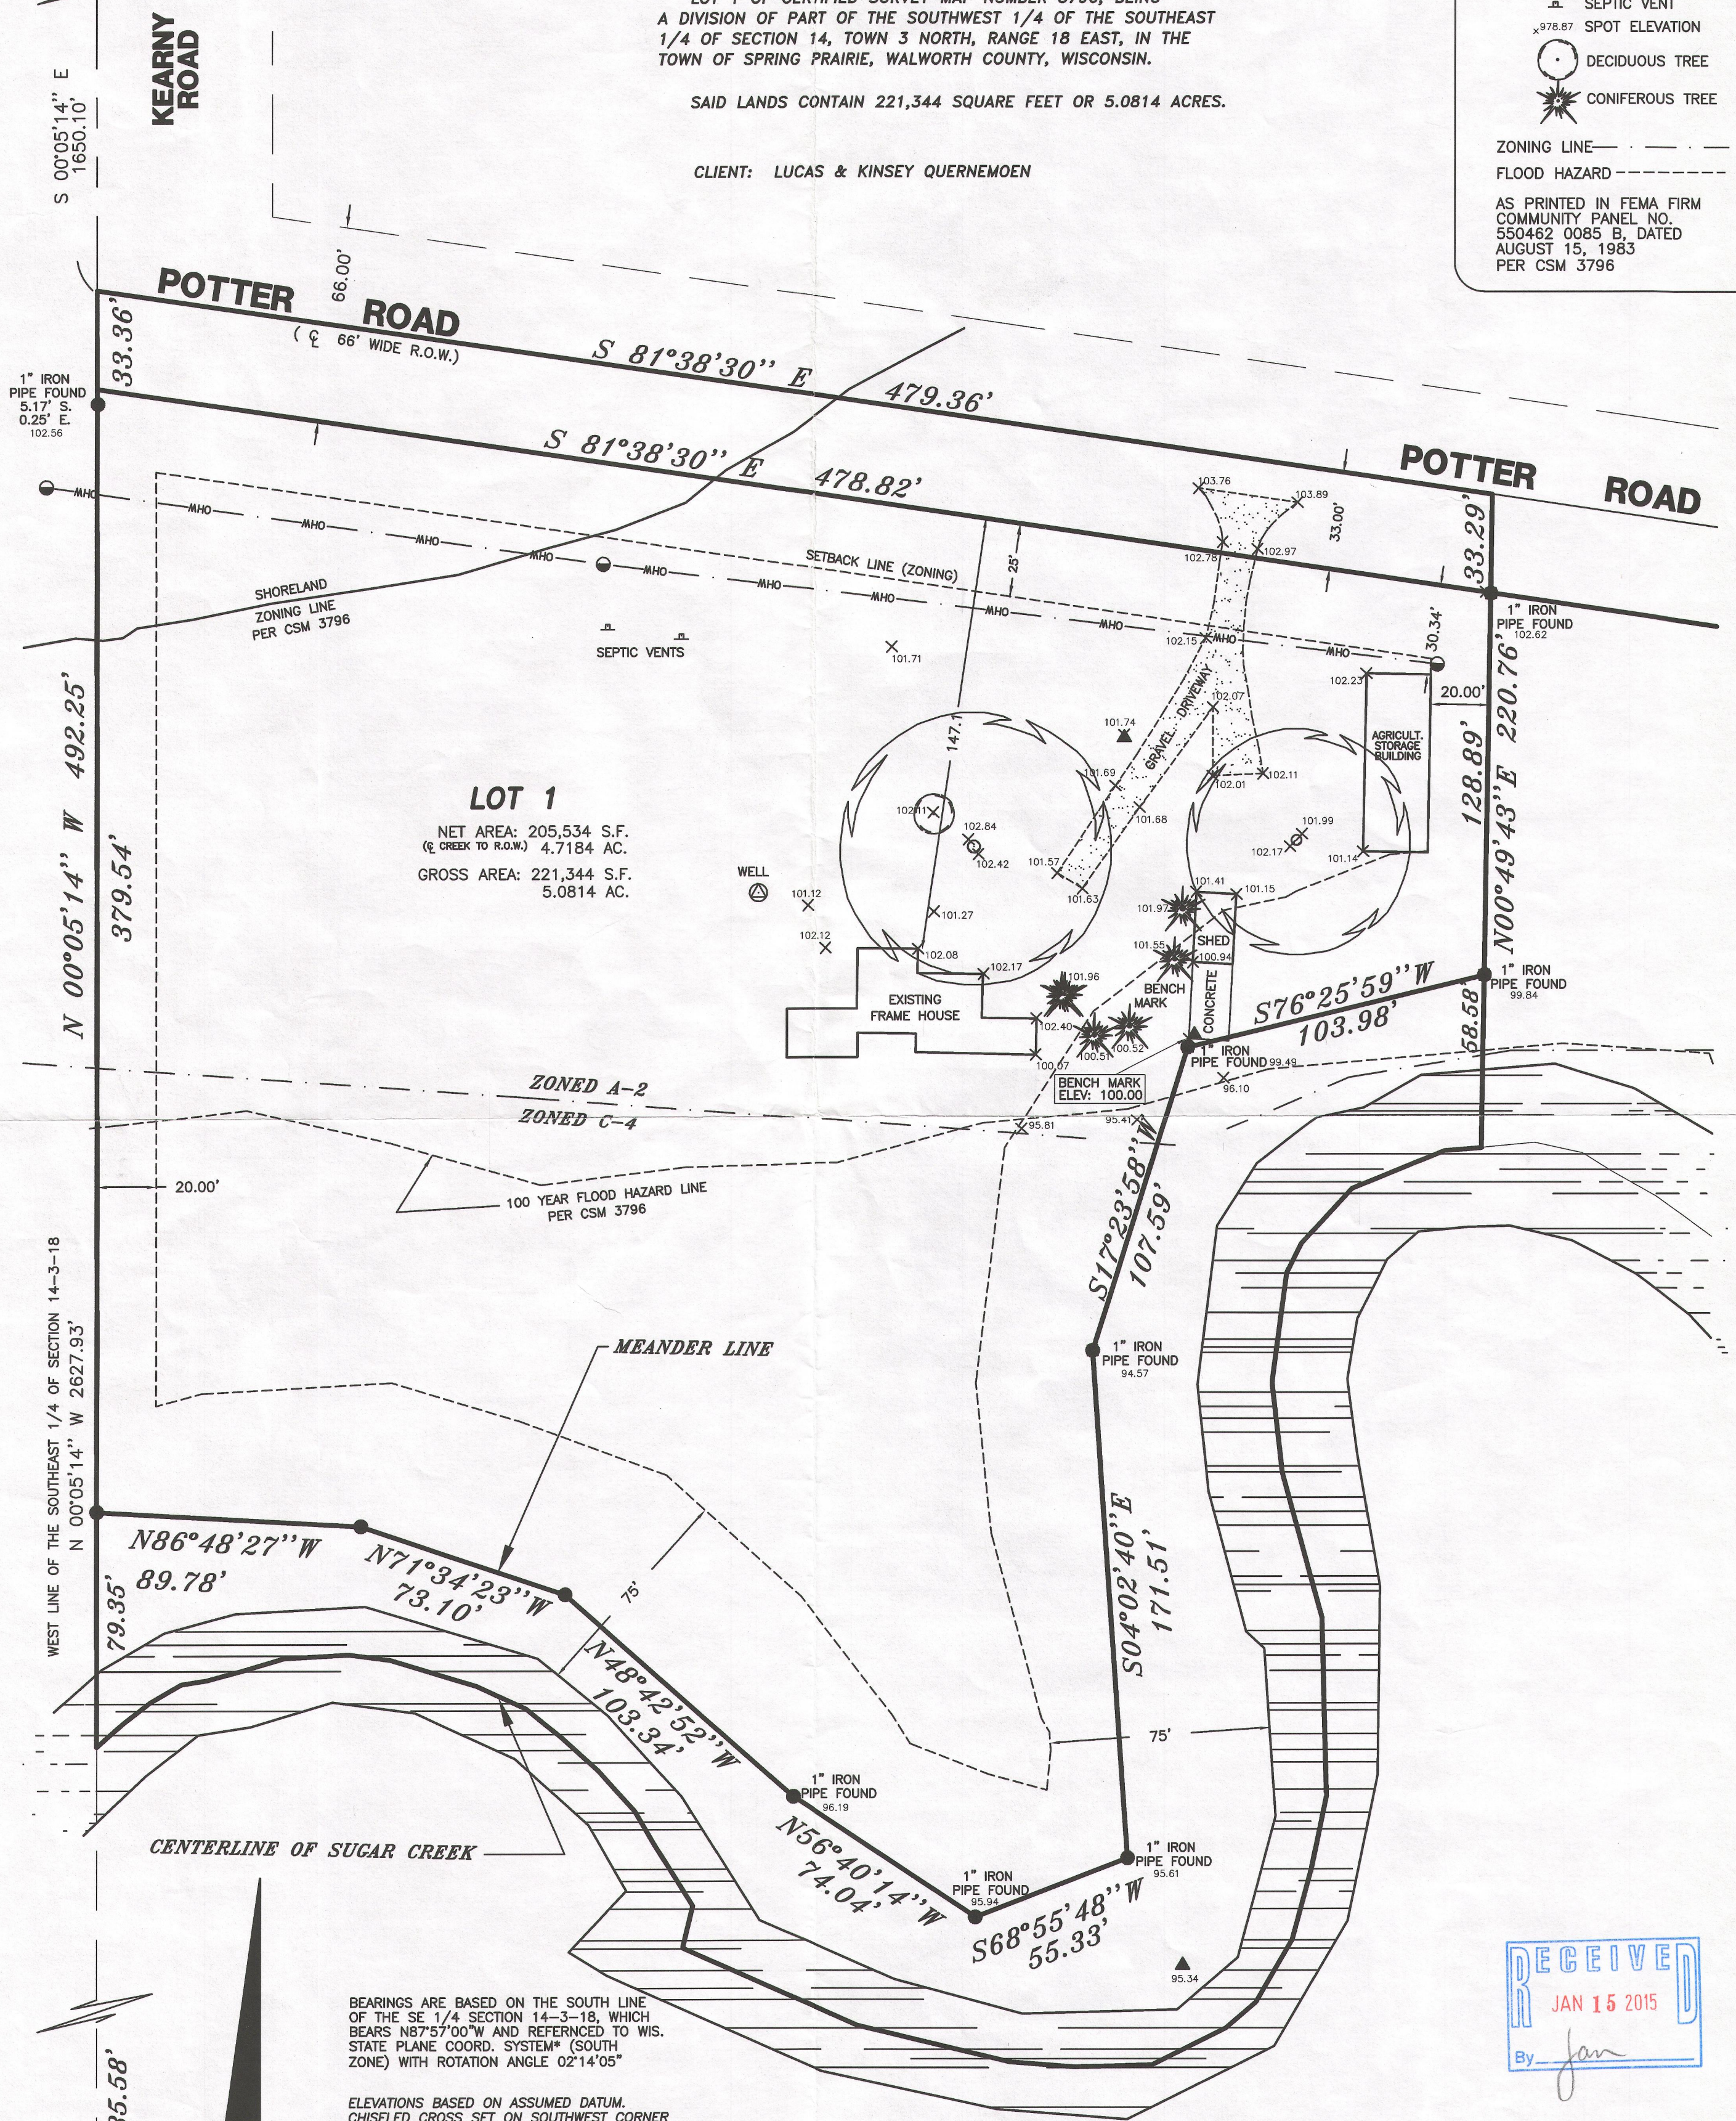


I Certify that I have surveyed the above described property (Property), and the above map is correct to the best of my professional knowledge and belief and shows the size and location of the Property, its exterior boundaries, the location and dimensions of all visible structures thereon, boundary fences, apparent easements and roadways and visible encroachments, if any. This survey is made for the exclusive use of the present owners of the Property, and also those who purchase, mortgage, or guarantee the title thereto, within one (1) year from date hereof.

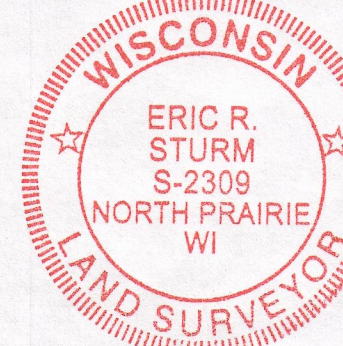

July 20, 2014
ERIC R. STURM, RLS, PLS
MEMBER OF:
EASTERN SURVEYING & MAPPING, LLC
REGISTERED WISCONSIN LAND SURVEYOR S-2309

SOUTHWEST CORNER OF THE SOUTHEAST 1/4 OF SECTION 14-3-18
CONC. MONUMENT
W/BRASS CAP FOUND

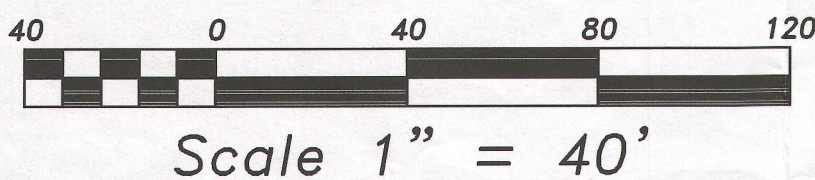

THIS IS AN ORIGINAL PRINT
ONLY IF THE STAMP AND
SIGNATURE ARE CONTRASTING
COLORS.