


Plat of Survey

of



Lot 1 of Certified Survey Map No. 4854,

recorded in Vol. 32 of Certified Survey Maps of Walworth County on Page 218
and located in the Northwest 1/4 of the Northwest 1/4 of Section 33, Town 3
North, Range 18 East, Town of Spring Praire, Walworth County, Wisconsin.

Surveyed for: **John Finke**
W1649 State Road 11
Burlington, Wisconsin. 53105-3067

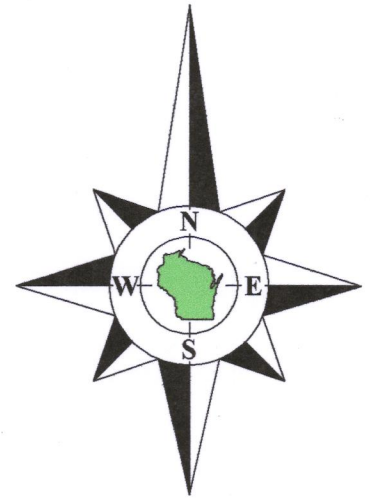

Bearings referenced to the North line of the Northwest 1/4 of Section 33-3-18,
recorded as N89°42'02"E in the Wisconsin State Plane Coordinate System,
South Zone, (NAD-27).

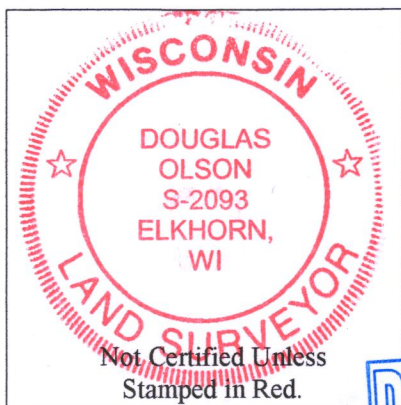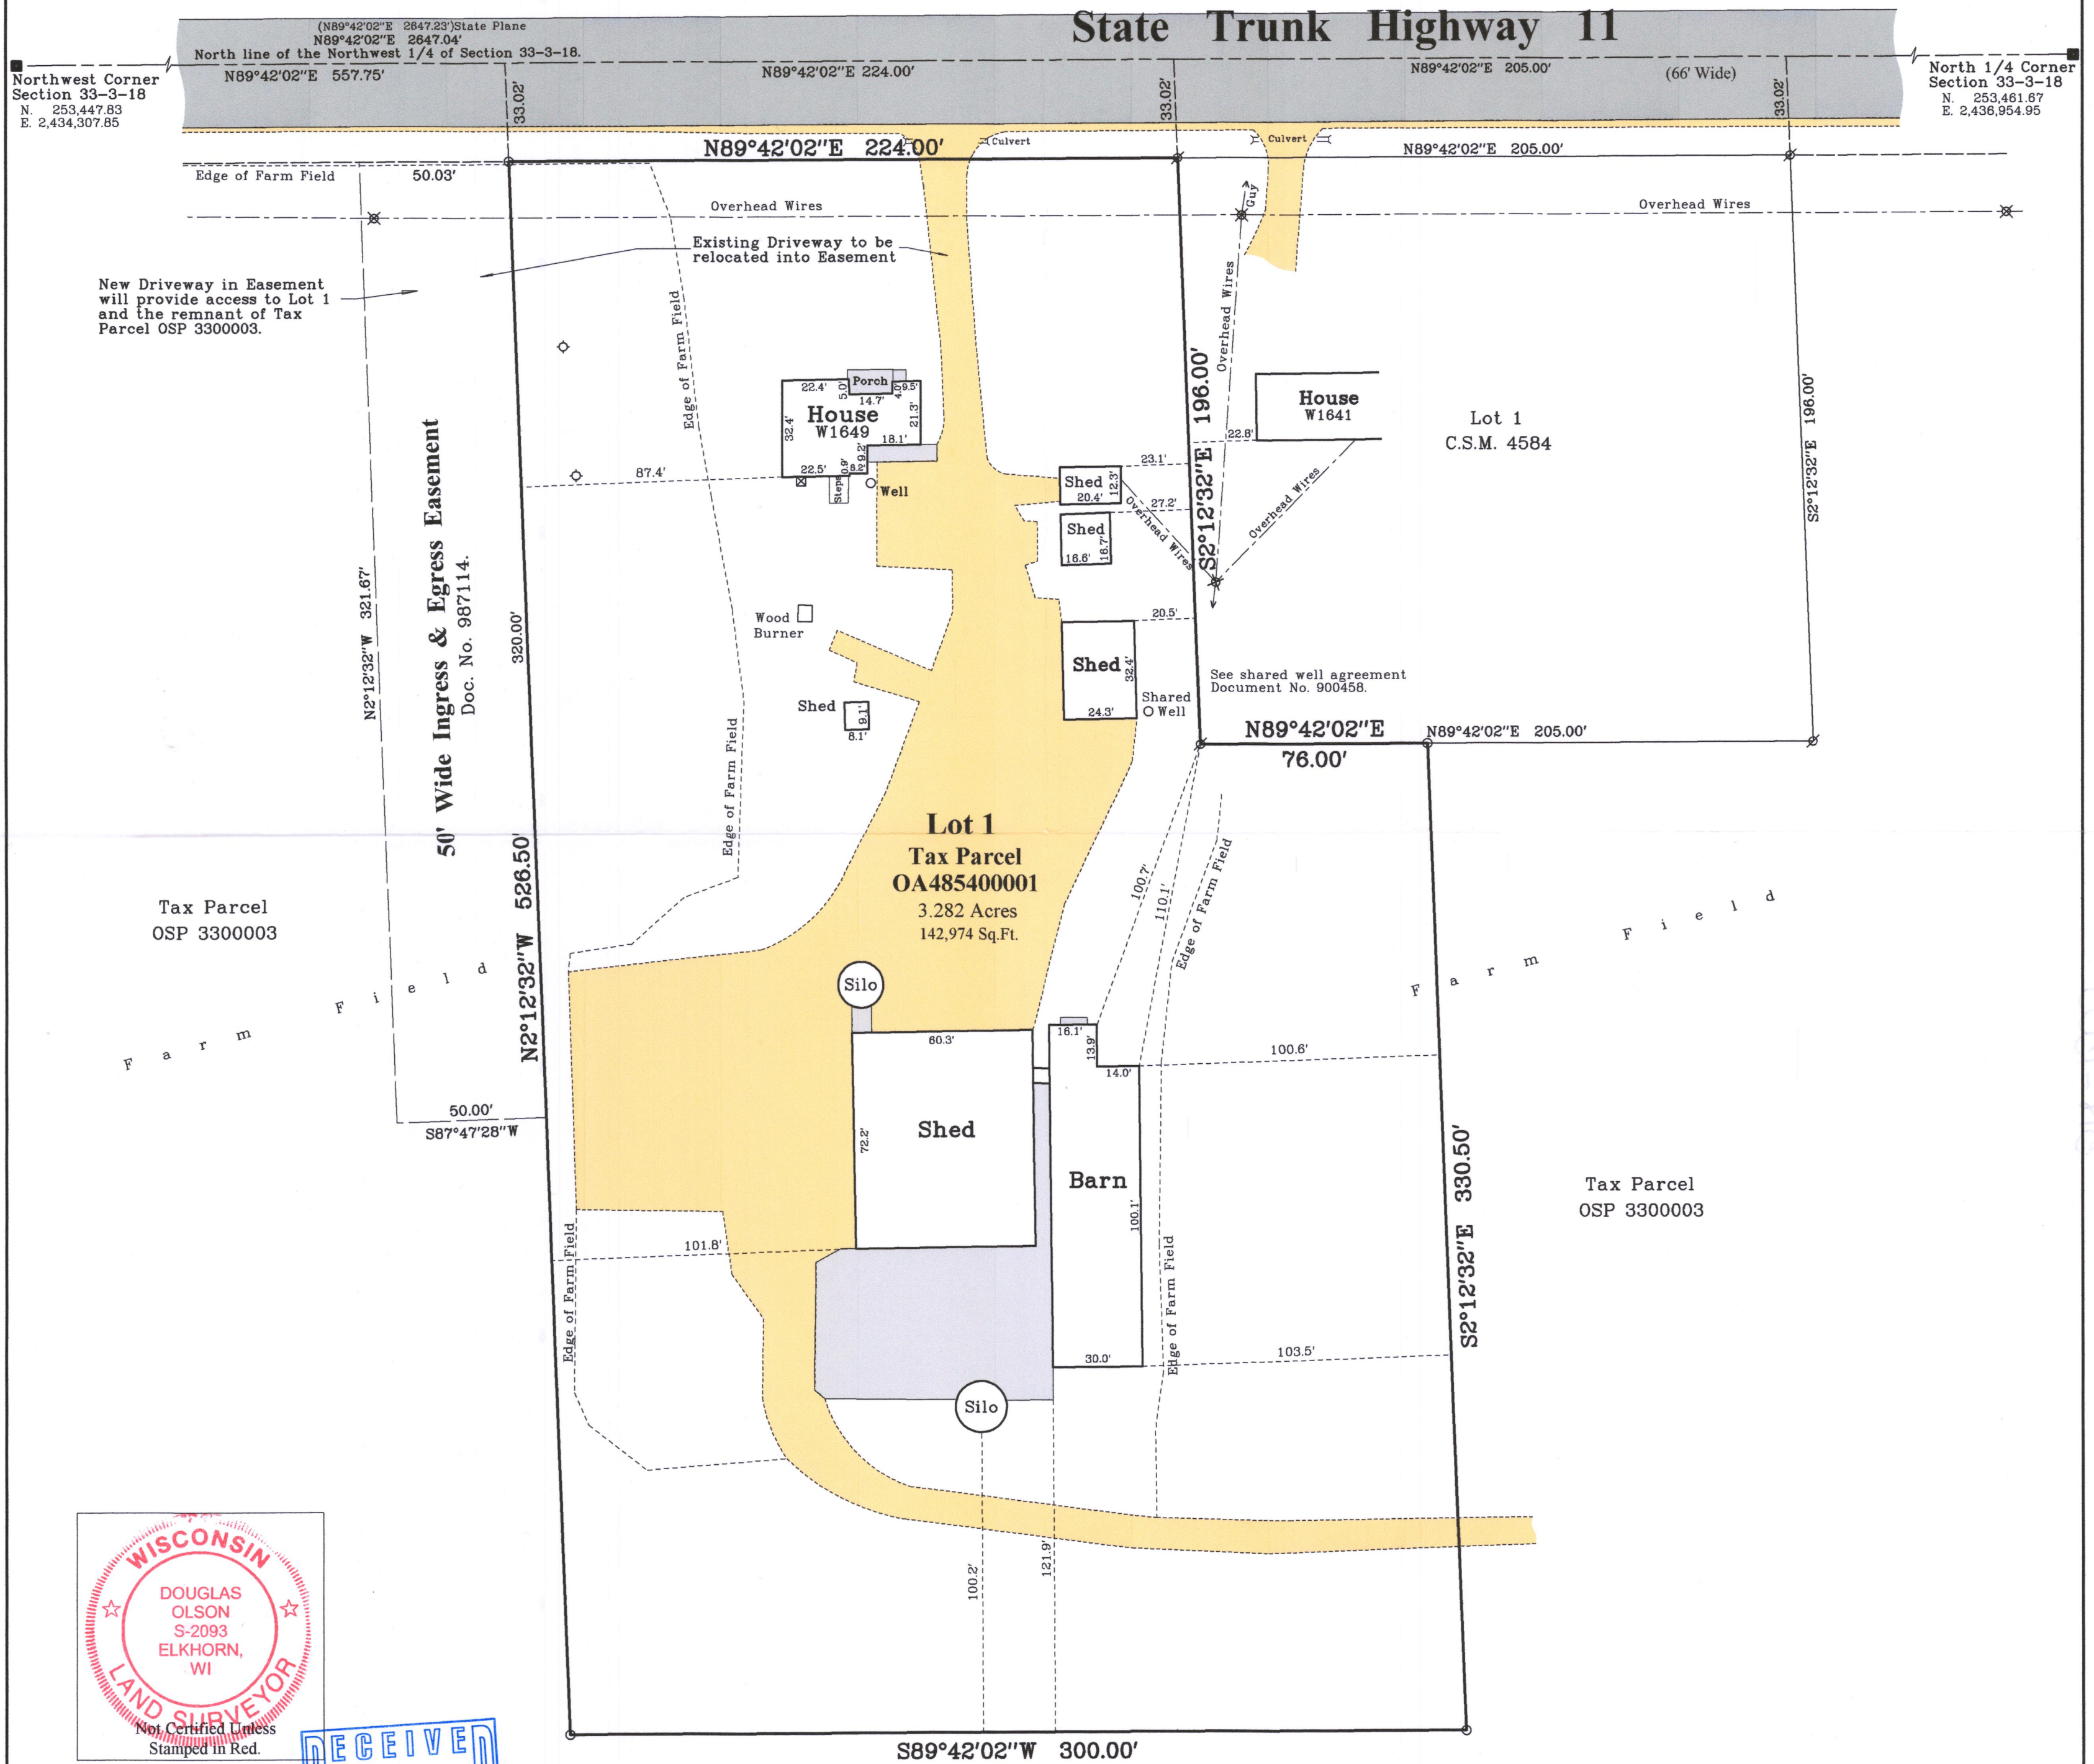

Notes:

- 1) This Plat of Survey is not certified unless signed and sealed in red ink.
- 2) This survey is subject to Wisconsin lien laws. This Plat of Survey is the notice of intent to file lien. Lien waiver required.
- 3) The Survey Date shown on this Plat of Survey is the completion date of the field work.

Copyright © 2017 by Olson Land Surveying, LLC.

All rights reserved. No part of this survey plat may be reproduced or transmitted in any form by any means - graphic, electronic, or mechanical, including photocopying, tracing, or information storage and retrieval systems - without permission in writing from Douglas G. Olson, Olson Land Surveying, LLC.

I hereby certify that I have surveyed the above described property in compliance with Chapter A-E 7 of the Wisconsin Administrative Code and that the map hereon is correct to the best of my professional knowledge and belief and shows the size and location of the property, its exterior boundaries, the location and dimensions of all visible structures thereon, boundary fences, apparent easements and roadways and visible encroachments, if any.

This survey is made for the exclusive use of the present owners of the property, and also those who purchase, mortgage or guarantee title thereto, within one year from the date hereof.

Douglas G. Olson
Wisconsin Professional Land Surveyor - 2093

Sheet 1 of 1 Sheets

Drawing Name:

Job Reference Number
2017.002

Legend of Symbols & Abbreviations

- Found County Section Corner
- Found Iron Pipe
- Set Iron Pipe, 1" dia.
- Recorded Information
- Utility Pole
- Utility Pedestal
- Asphalt Surface
- Concrete Surface
- Gravel Surface
- North
- South
- East
- West
- In Bearings
- Degrees
- Minutes
- Seconds
- In Distances
- Feet
- Inches
- Septic Vent



45 South Wisconsin Street | P.O. Box 322
Elkhorn, Wisconsin. 53121
Telephone: (262) 723-3434
Facsimile: (262) 723-8044
Email: doug@olsonsurveying.com
Website: www.olsonsurveying.com

Scale in Feet
1" = 40'



Survey Date: March 28, 2017.

Revisions: No. 1 - Smaller Parcel
No. 2 - Smaller Parcel
No. 3 - Proposed Easement
No. 4 - Larger Parcel
No. 5 - Move South line 100' from Silo
No. 6 - Recorded CSM & Easement.

OA4854-1

318-1305