DESCRIPTION OF LYONS ROAD

[illegible] PARCELS LOCATED [illegible] 1/4 [illegible] 27, T.3[illegible], R.18[illegible], TOWN OF SPRING PRAIRIE, [illegible] MORE PARTICULARLY DESCRIBED [illegible] SOUTHERLY [illegible] OF LYONS ROAD, SECTION 27, [illegible] LONG [illegible] OF [illegible] SECTION 192.35 FEET, THENCE [illegible] FEET TO THE POINT OF BEGINNING [illegible] THENCE [illegible] ALONG THE ARC OF A CURVE TO THE [illegible] HAVING A RADIUS OF 882.[illegible] FEET, LONG CHORD BEARING [illegible] FEET [illegible] LINE OF CERTIFIED SURVEY NO. 133, [illegible] THENCE [illegible] 248.33 FEET, THENCE [illegible] 69.06 FEET [illegible] OF THIS DESCRIPTION.

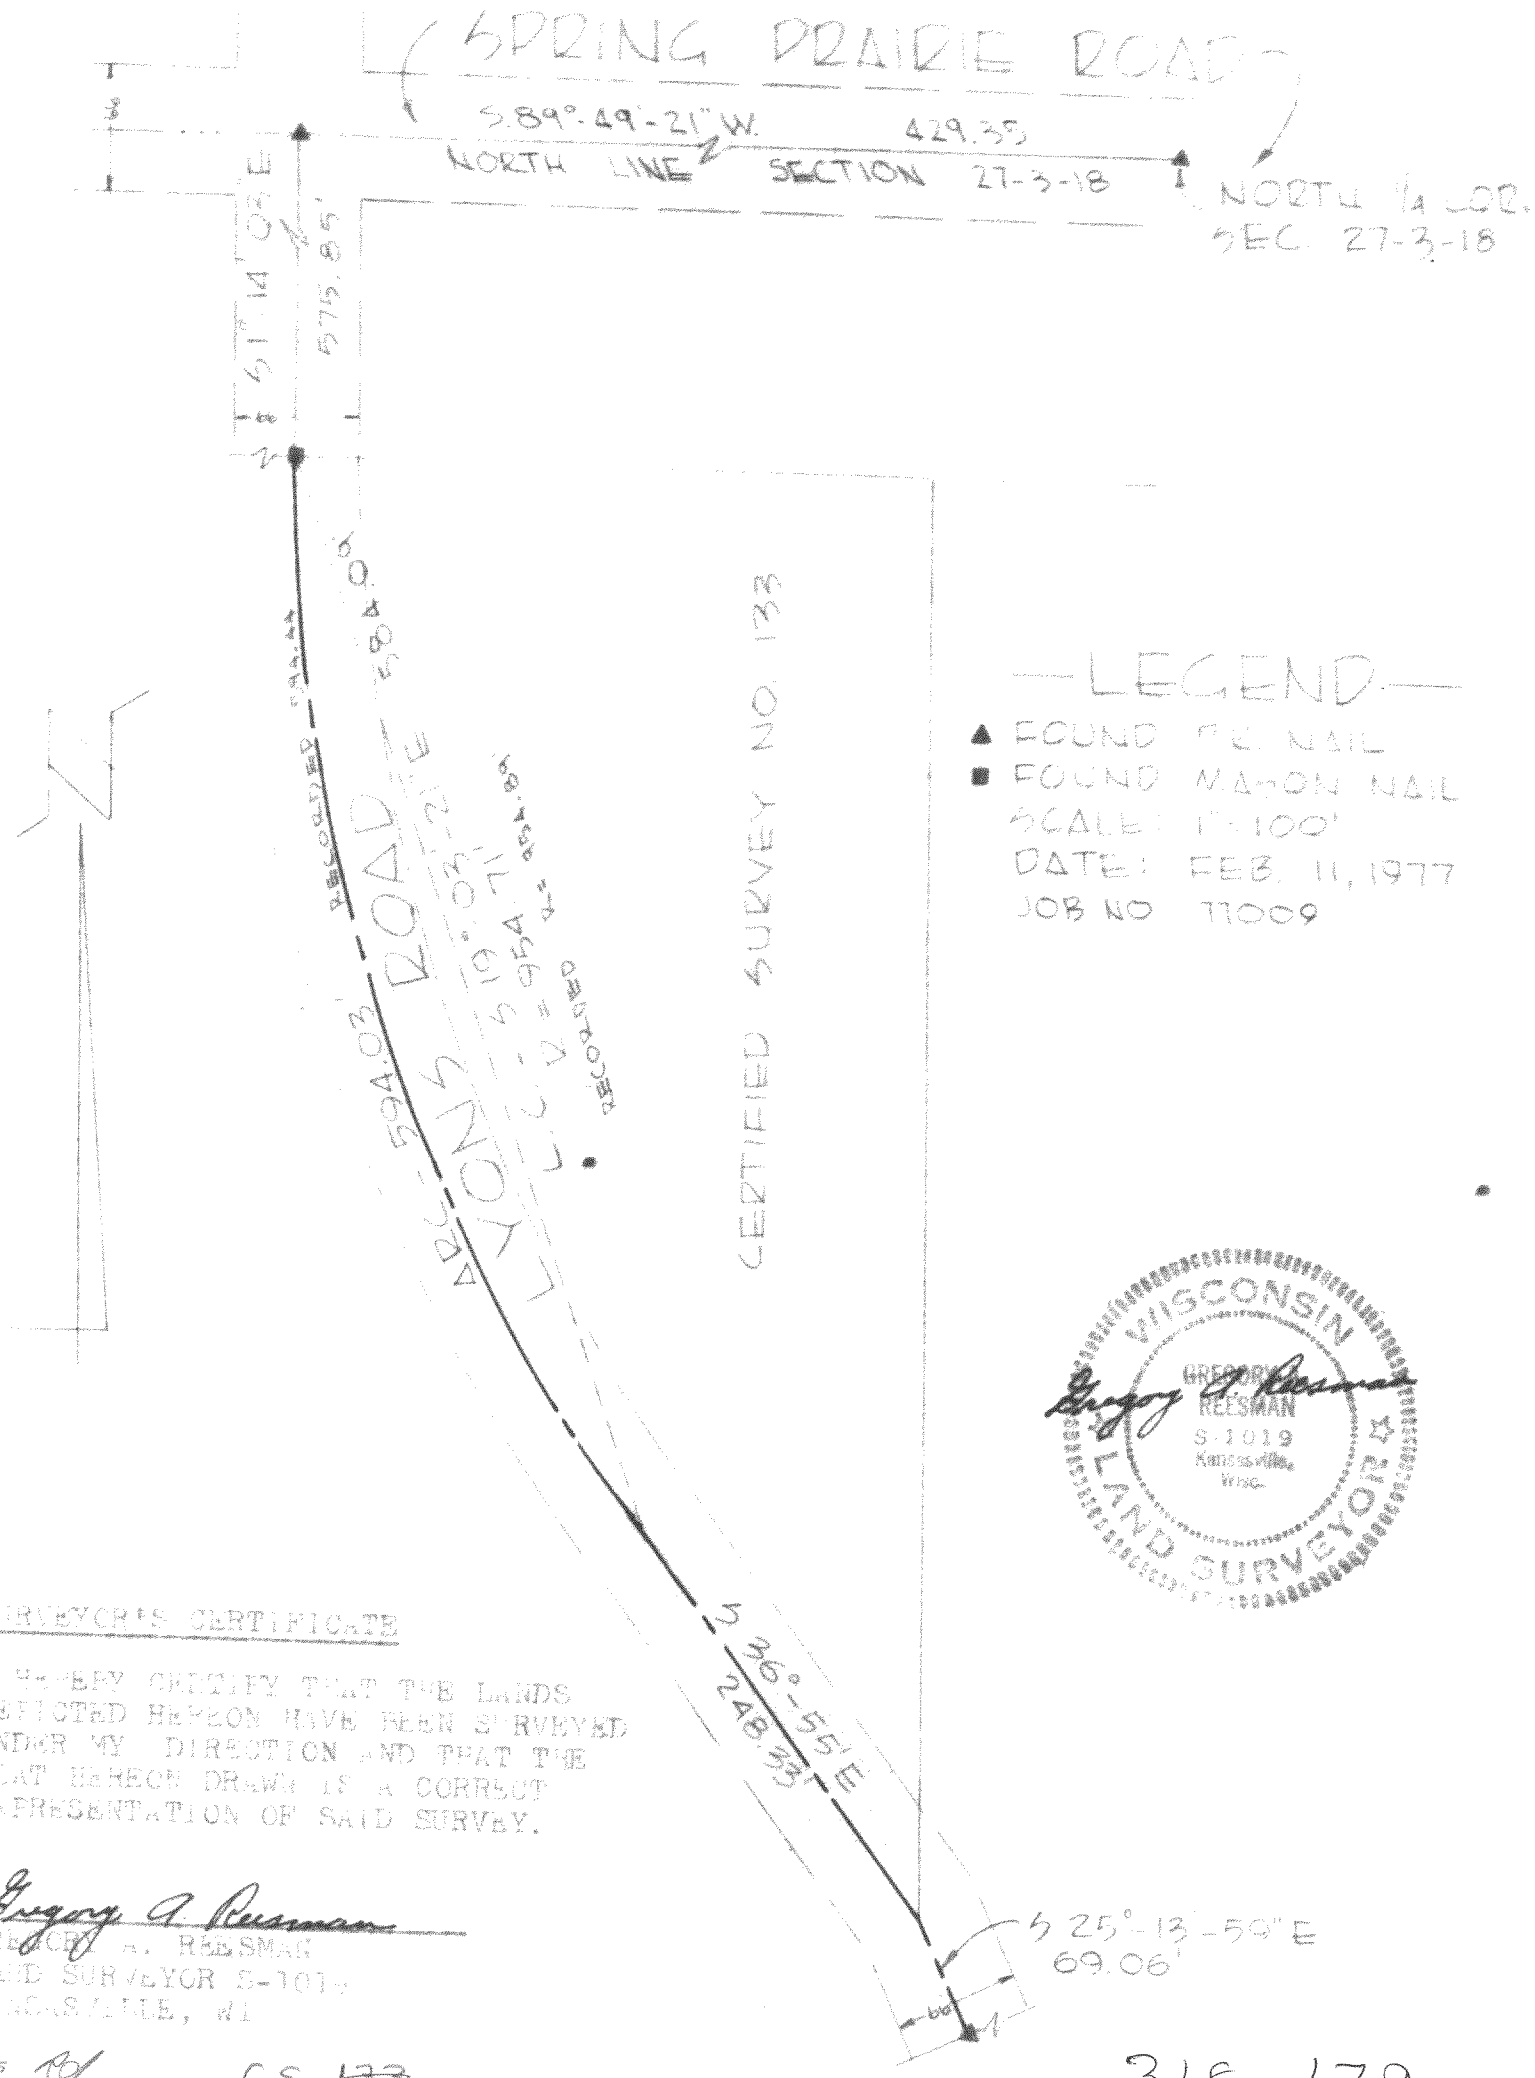

SURVEYOR'S CERTIFICATE

I HEREBY CERTIFY THAT THE LANDS DEPICTED HEREON HAVE BEEN SURVEYED UNDER MY DIRECTION AND THAT THE PLAT HEREON DRAWN IS A CORRECT REPRESENTATION OF SAID SURVEY.

Gregory A. Reesman
GREGORY A. REESMAN
LAND SURVEYOR S-1019
KANSASVILLE, WI

Lyons Rd CS ~~133~~

318-172