



LANDS LOCATED IN PART OF THE WEST $\frac{1}{2}$ OF
THE NE $\frac{1}{4}$ AND THE EAST $\frac{1}{2}$ OF THE NW $\frac{1}{4}$
OF SECTION 27, T.3N., R.18E., TOWN OF
SPRING PRAIRIE, WALWORTH COUNTY, WISCONSIN.

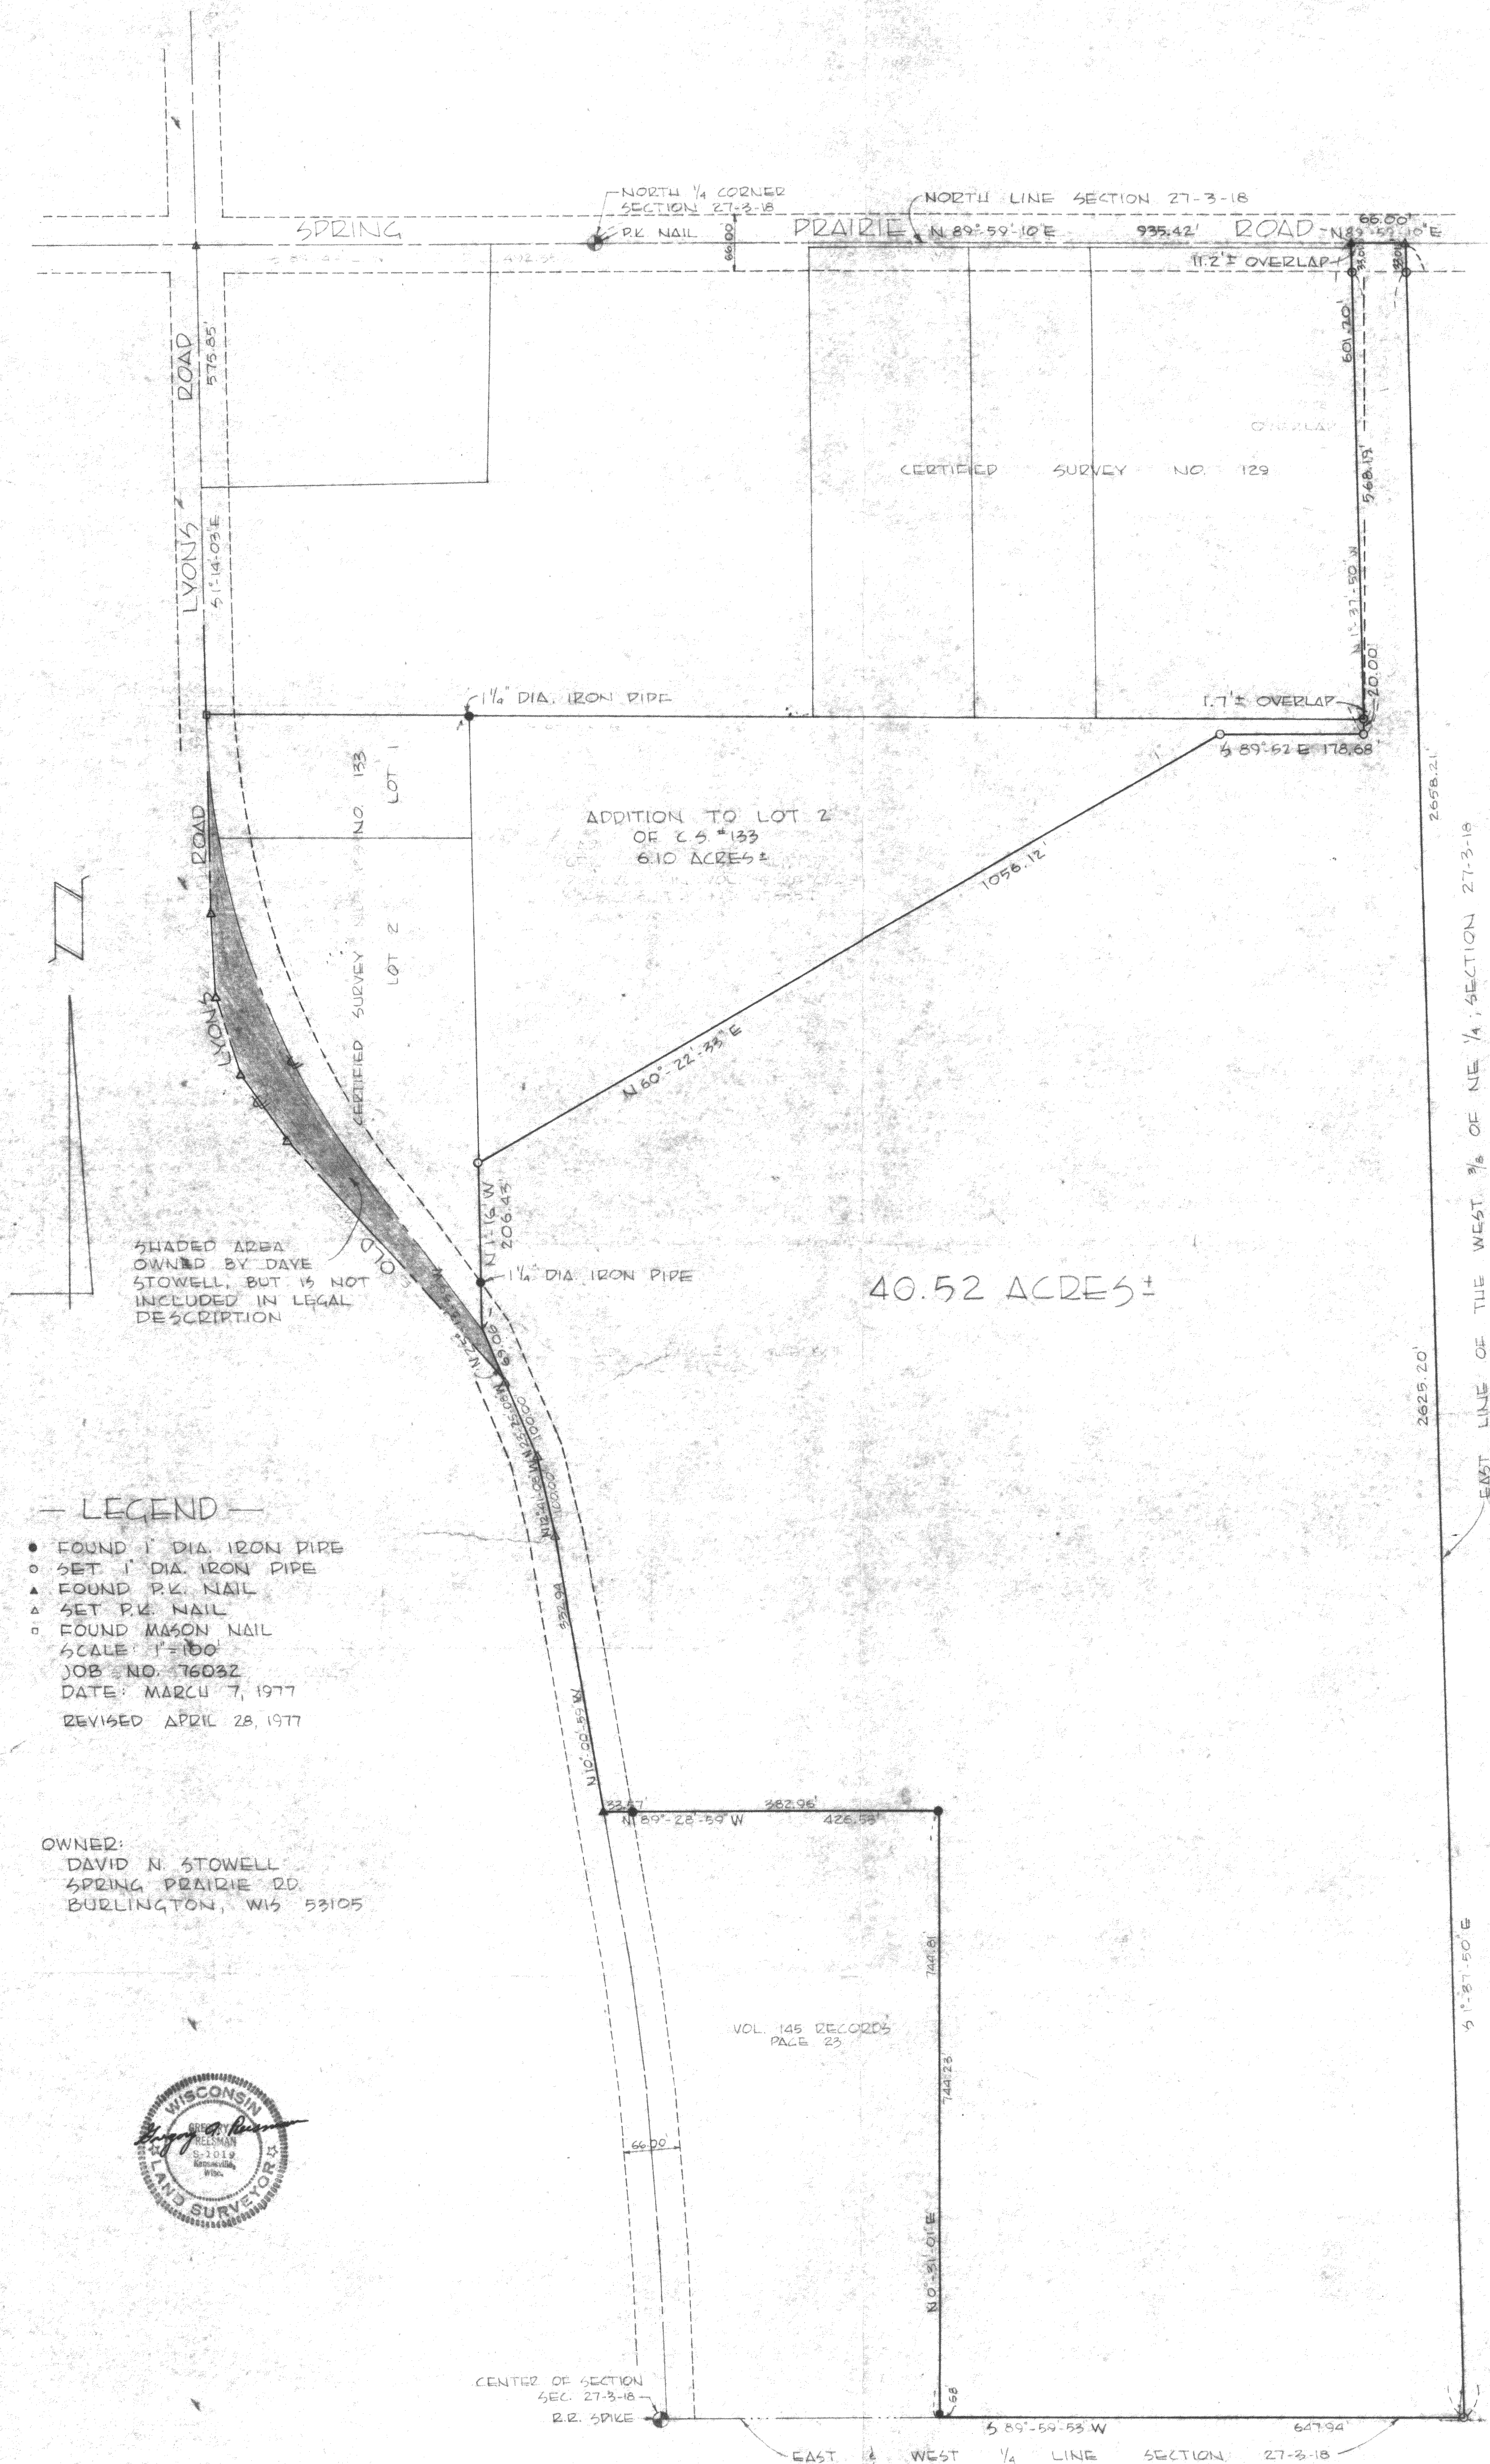

CS 1743
27-2, 2C

PLAT OF SURVEY

PART OF THE WEST 1/2 OF THE NE 1/4 AND THE EAST 1/2 OF THE NW 1/4 OF SECTION 27, T.3N., R.18E., TOWN OF SPRING PRAIRIE, COUNTY OF WALWORTH, STATE OF WISCONSIN AND MORE PARTICULARLY DESCRIBED AS FOLLOWS: COMMENCE AT THE NORTH 1/4 CORNER OF SAID SECTION 27, RUN THENCE E.89°-59'-10"E. ALONG THE NORTH LINE OF SAID SECTION 935.42 FEET TO A P.K. NAIL WHICH IS THE POINT OF BEGINNING OF THE FOLLOWING DESCRIBED PARCEL, THENCE CONTINUE N.89°-59'-10"E. ALONG SAID NORTH LINE 66.00 FEET TO A P.K. NAIL, THENCE S.10°-37'-50"E. ALONG THE EAST LINE OF THE WEST 3/8 OF THE NE 1/4 OF SAID SECTION 2658.21 FEET TO AN IRON PIPE, THENCE S.89°-59'-53"W. ALONG THE EAST AND WEST 1/4 LINE OF SAID SECTION 647.94 FEET TO A POINT, THENCE N.0°-31'-01"E 741.81 FEET TO AN IRON PIPE, THENCE N.89°-28'-59"W. 426.53 FEET TO A P.K. NAIL, THENCE N.10°-00'-59"W. ALONG THE CENTERLINE OF LYONS ROAD 332.94 FEET TO A P.K. NAIL, THENCE N.12°-41'-08"W. ALONG SAID CENTERLINE 100.00 FEET TO A P.K. NAIL, THENCE N.23°-25'-08"W. ALONG SAID CENTERLINE 100.00 FEET TO A P.K. NAIL, THENCE N.25°-13'-59"W. ALONG SAID CENTERLINE 69.06 FEET TO A POINT, THENCE N.1°-16'W. ALONG THE EAST LINE OF CERTIFIED SURVEY NO. 133, RECORDED IN THE WALWORTH COUNTY REGISTER OF DEEDS OFFICE, 206.13 FEET TO AN IRON PIPE, THENCE N.60°-22'-33"E. 1056.12 FEET TO AN IRON PIPE, THENCE S.90°-52'E. TO AN IRON PIPE, THENCE N.1°-37'-50"W. PARALLEL TO SAID EAST LINE OF THE WEST 3/8th 601.20 FEET TO THE POINT OF BEGINNING. SAID PARCEL CONTAINS 40.52 ACRES OF LAND MORE OR LESS. SAID PARCEL IS SUBJECT TO SPRING PRAIRIE ROAD AND LYONS ROAD RIGHT OF WAY.

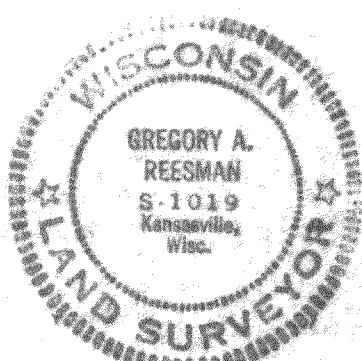

Gregory A. Reisman
 GREGORY A. REISMAN
 LAND SURVEYOR S - 1019
 KANSASVILLE, WIS. 318-176
 REVISED APRIL 20, 1977