PLAT OF SURVEY
OF

LOT 1 OF CERTIFIED SURVEY MAP NO. 403, RECORDED IN VOLUME 2 OF CERTIFIED SURVEY MAPS ON PAGE 200 AS DOCUMENT NO. 682381, FOR LANDS LOCATED IN THE SOUTHEAST 1/4 OF SECTION 14, T. 3 N., R. 18 E. OF THE 4TH P.M., TOWNSHIP OF SPRING PRAIRIE, WALWORTH COUNTY, WI.

FOR: PHILIP AND DEBRA SPENCER
699 KEARNY ROAD
BURLINGTON, WI. 53105

SCALE 1" = 60'
ø = IRON PIPE STAKE FOUND.
o = IRON PIPE STAKE SET.
BEARING DATUM IS THAT OF RECORDED CSM.

RECEIVED
SEP 16 1985

WISCONSIN
JOHN F. DEGEN
BURLINGTON, WIS.
LAND SURVEYOR


I have surveyed the above-described property and the map hereon is a true representation thereof and shows the size and location of the property, its exterior boundaries, the location and dimensions of all visible structures thereon, fences, apparent easements and roadways and visible encroachments, if any.

This survey is made for the exclusive use of the present owners of the property, and also those who purchase, mortgage, or guarantee the title thereto, within one year from date hereof.

Dated at Burlington, this 22ND day of JULY 1985

John F Degen

John F. Degen, Land Surveyor S 242

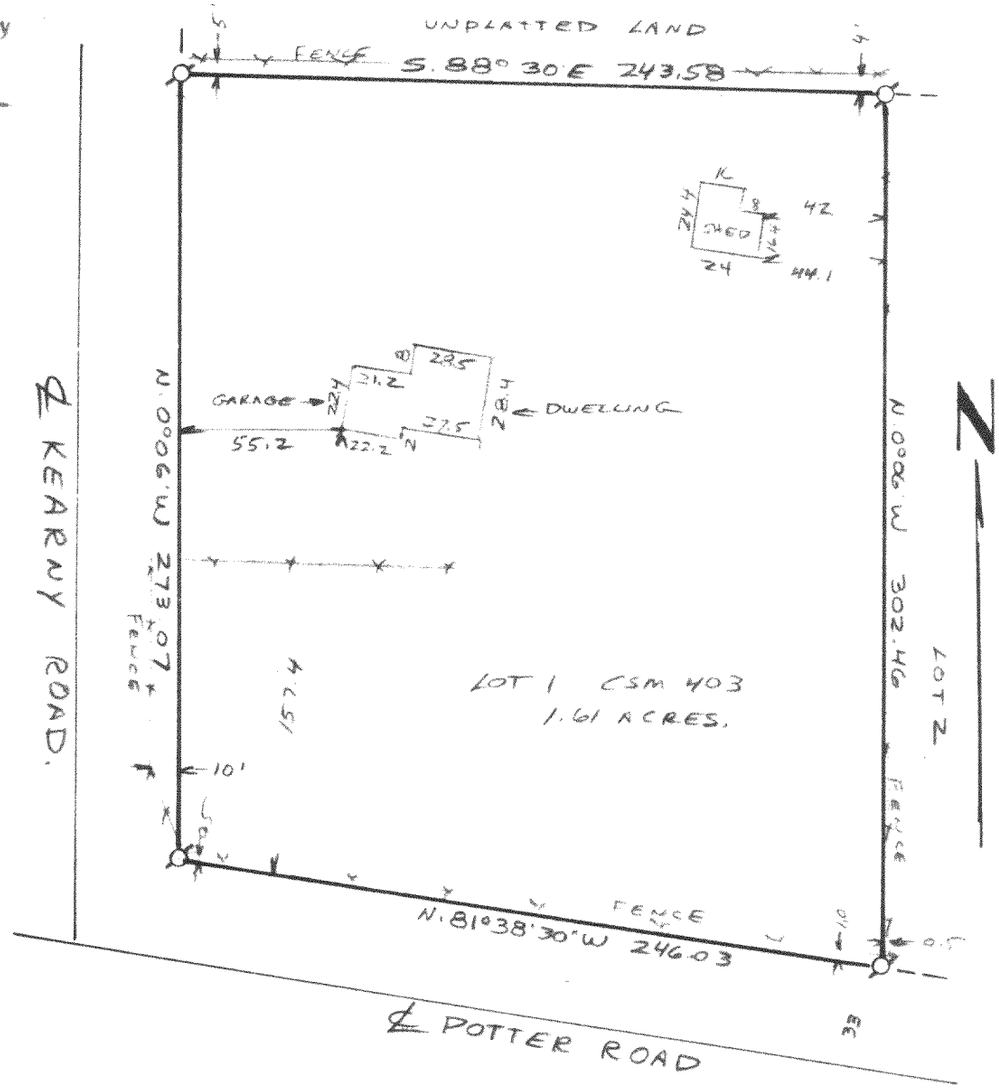

OA403-1

318-257 11-13-3 #39