
PLAT OF SURVEY
-OF-

LOTS 21, 22 and 23, BLOCK 9, HONEY LAKE SUBDIVISION FIRST ADDITION, being a part of the Southeast 1/4 of Section 13, Township 3 North, Range 18 East in the Town of Spring Prairie, Walworth County, Wisconsin.

Survey For: Bill Tigges

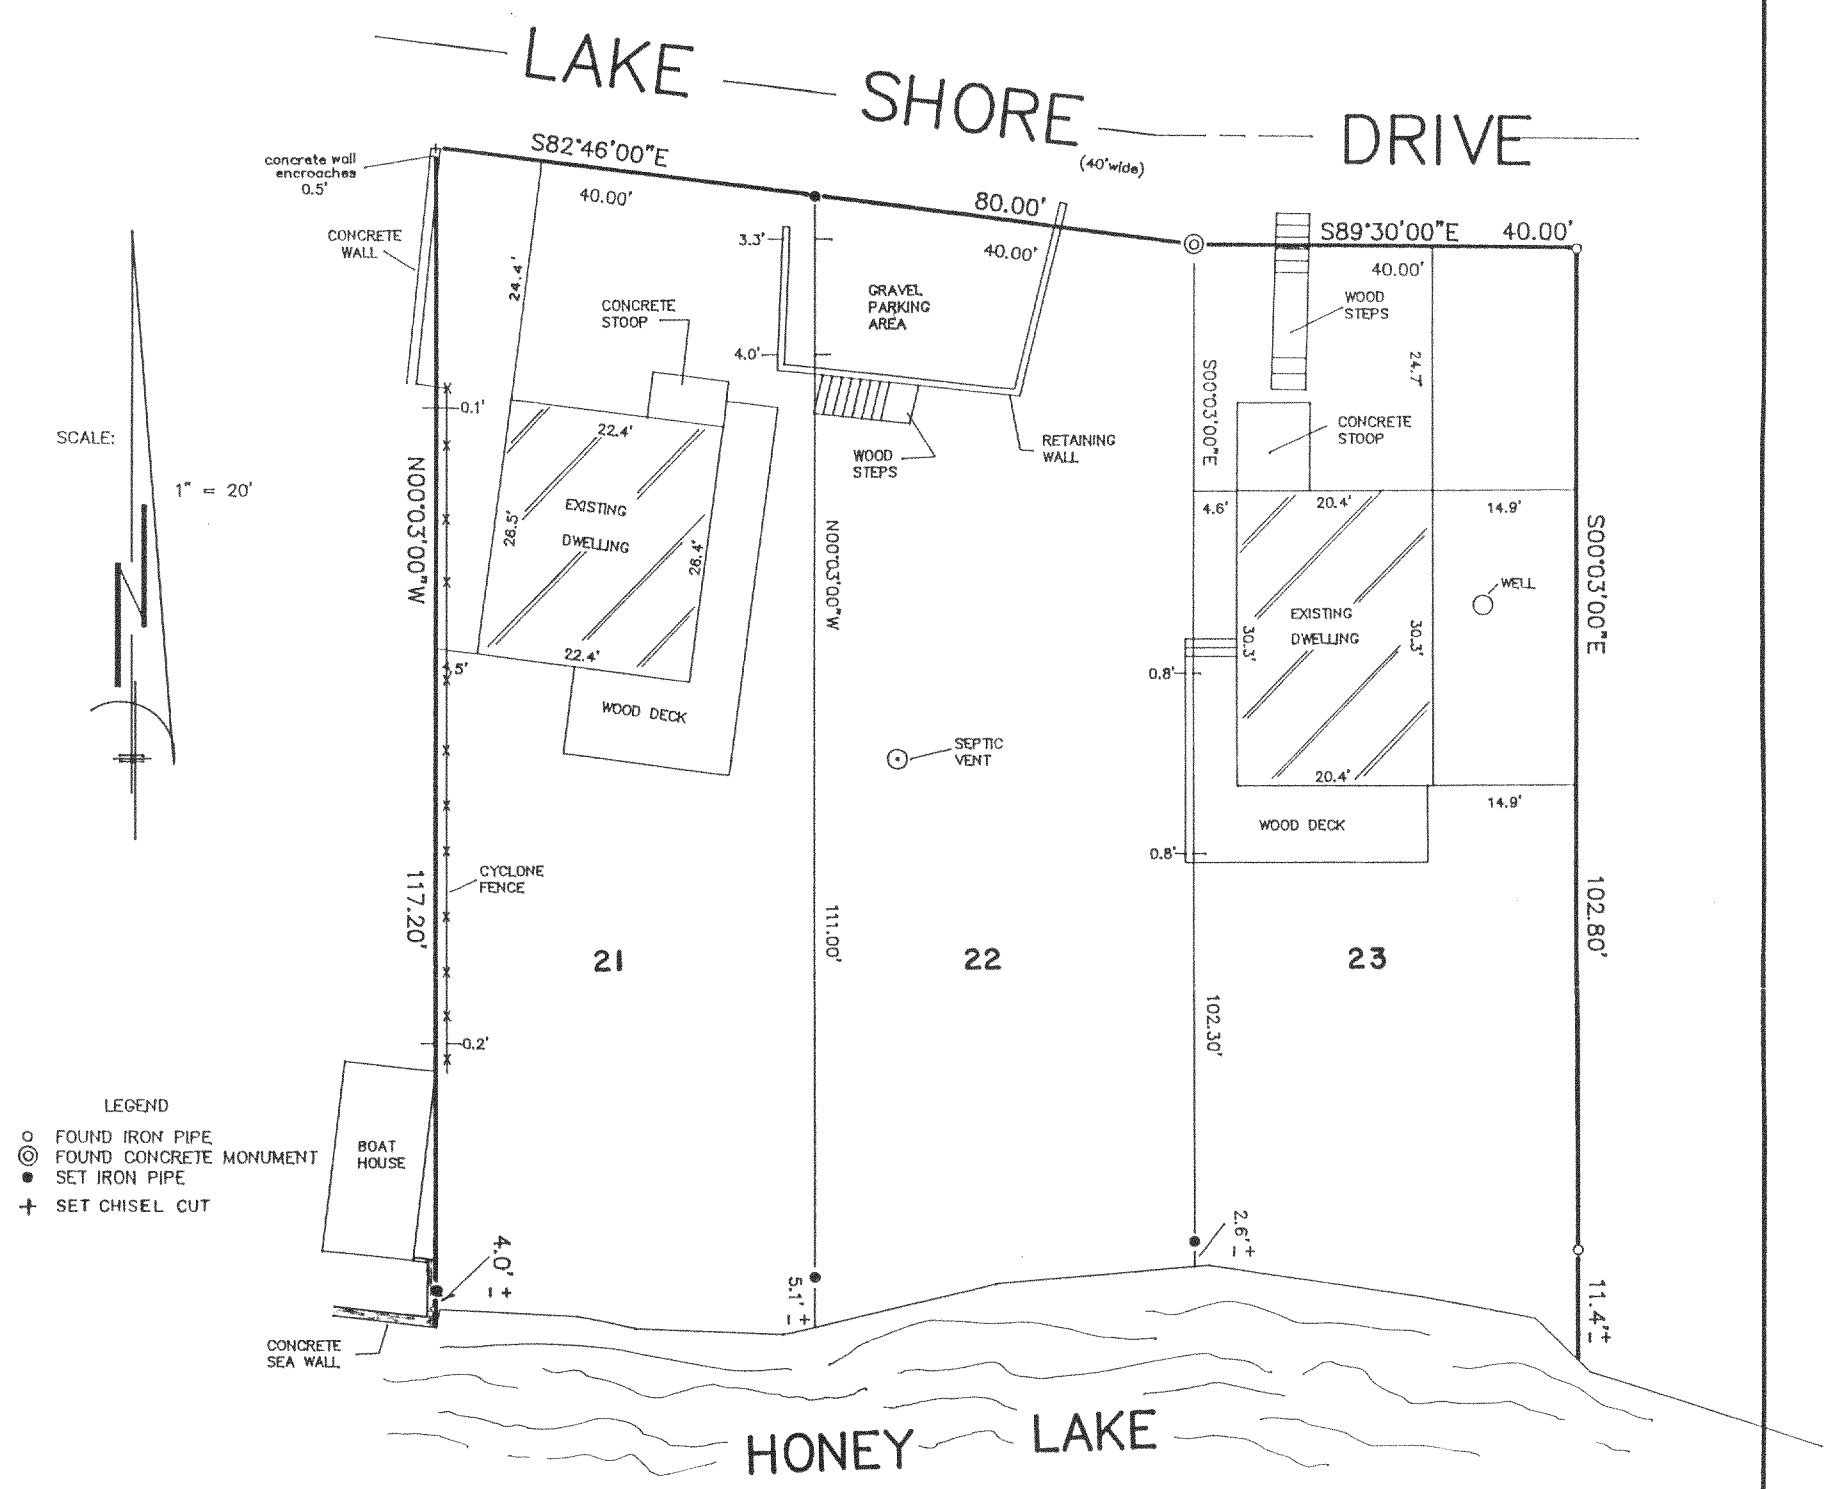


"I hereby certify that I have surveyed the above described property and that the above map is a correct representation thereof and shows the size and location of the property, its exterior boundaries, the location of all visible structures and dimensions of all principal buildings thereon, boundary fences, apparent easements, roadways and encroachments, if any."

"This survey is made for the use of the present owners of the property, and those who purchase, mortgage, or guarantee the title thereto within one year from date hereof."

RECEIVED
OCT 7 1996

WISCONSIN
ROBERT J. WETZEL
S-1778
BURLINGTON, WI
LAND SURVEYOR

THIS IS NOT AN ORIGINAL PRINT
UNLESS THIS SEAL IS RED.

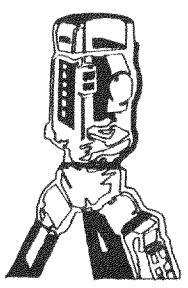

B.W. SURVEYING
LAND SURVEYS
MAPPING AND PLANNING
425 MILWAUKEE AVENUE
BURLINGTON, WI 53105
(414)-767-0225

ROBERT J. WETZEL S-1778

5\24\96
DATE

2536
JOB NUMBER

OHL1-70

318-565