
HAROLD H. KOLB

REGISTERED PROFESSIONAL LAND SURVEYOR
LAKE GENEVA, WISCONSIN

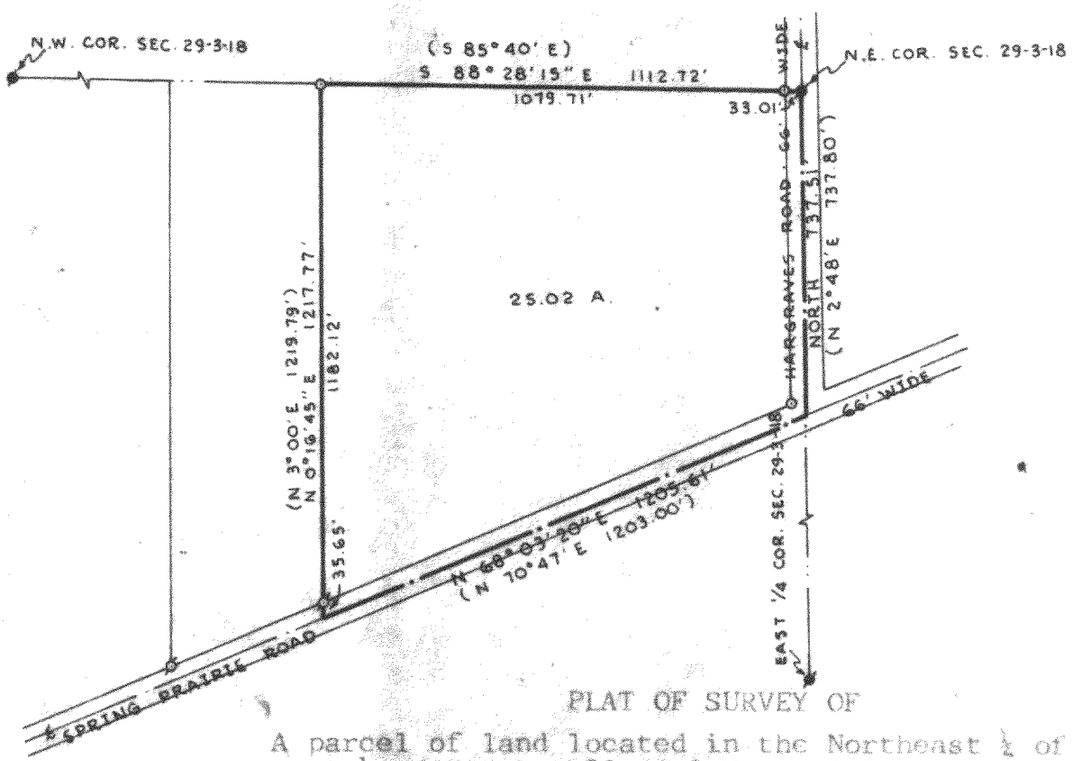

PLAT OF SURVEY OF

A parcel of land located in the Northeast ¼ of the Northeast ¼ of Section 29, T 3 N, R 18 E, Walworth County, Wisconsin, and described as follows: Beginning at the Northeast corner of said Section 29; thence South 737.51 feet; thence S 68°03'20" W 1205.61 feet; thence N 0°16'45" E 1217.77 feet; thence S 88°28'15" E 1112.72 feet to the place of beginning; containing 25.02 acres.

N

SCALE: 1"=400'

NOTE: The East line of Section 29, T 3 N, R 18 E, is assumed due North.

LEGEND

- ϕ — IRON PIPE FOUND
- O — IRON PIPE PLACED
- ● — CONCRETE MONUMENT
- x — SPIKE
- ( ) — As Recorded

WISCONSIN
HAROLD H. KOLB
S-187
LAKE GENEVA, WIS.
LAND SURVEYOR

I, HAROLD H. KOLB, DO HEREBY CERTIFY THAT I HAVE SURVEYED THE PROPERTY HEREON DESCRIBED ACCORDING TO THE OFFICIAL RECORDS, AND THAT THE PLAT HEREON IS A CORRECT REPRESENTATION OF THE LOT LINES.

Harold H. Kolb

HAROLD H. KOLB
WISCONSIN REGISTERED LAND SURVEYOR, S-187
DATE March 21, 1973

318-[illegible] 67

BRUNING 40-105 1M-6-71

SP-29-1C + 29-1C1 + C.S. #221 + 952


HAROLD H. KOLB

REGISTERED PROFESSIONAL LAND SURVEYOR

LAKE GENEVA, WISCONSIN

Copy

S. P.

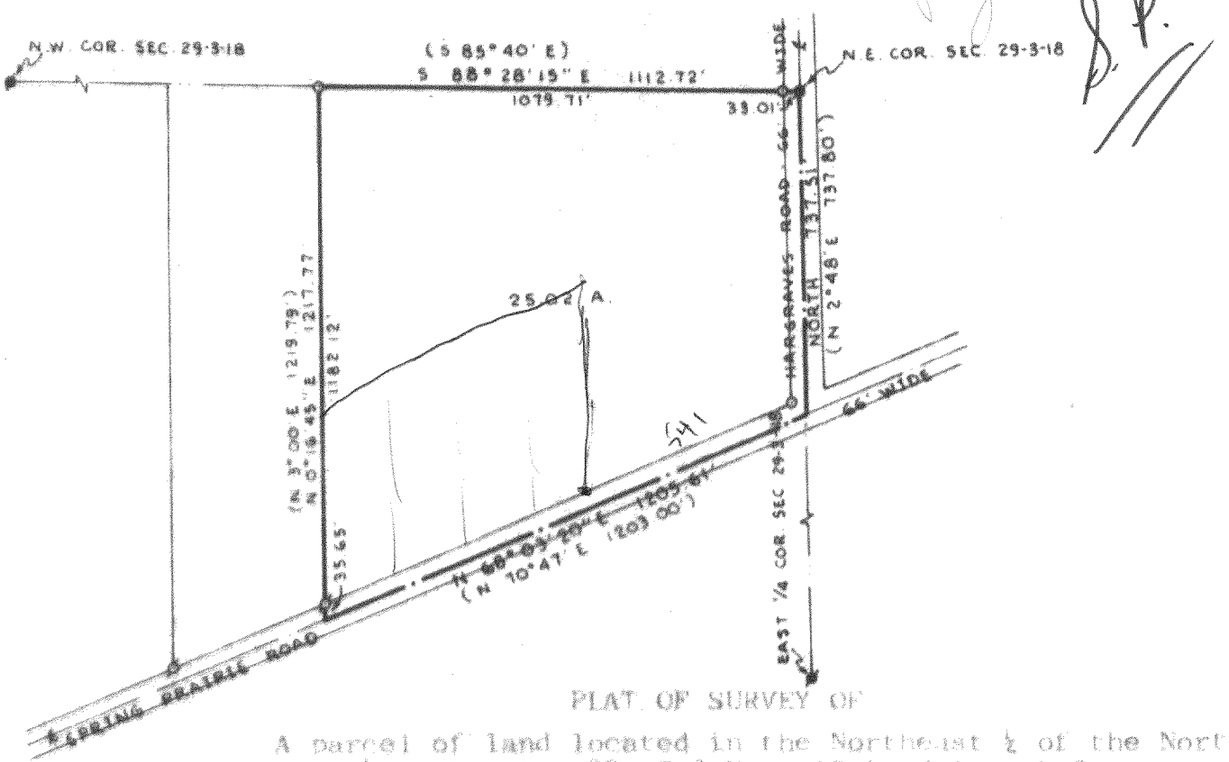

PLAT OF SURVEY OF

A parcel of land located in the Northeast ¼ of the Northeast ¼ of Section 29, T 3 N, R 18 E, Walworth County, Wisconsin, and described as follows: Beginning at the Northeast corner of said Section 29; thence South 737.51 feet; thence S 68°03'20" W 1205.61 feet; thence N 0°16'45" E 1217.77 feet; thence S 88°28'15" E 1112.72 feet to the place of beginning; containing 25.02 acres.

N

SCALE: 1"=400'

NOTE: The East line of Section 29, T 3 N, R 18 E, is assumed due North.

LEGEND

- ϕ — IRON PIPE FOUND
- O — IRON PIPE PLACED
- ● — CONCRETE MONUMENT
- x — SPIKE
- ( ) — As Recorded

HAROLD H KOLB S-187 LAKE GENEVA, WIS. LAND SURVEYOR

I, HAROLD H. KOLB, DO HEREBY CERTIFY THAT I HAVE SURVEYED THE PROPERTY HEREON DESCRIBED ACCORDING TO THE OFFICIAL RECORDS, AND THAT THE PLAT HEREON IS A CORRECT REPRESENTATION OF THE LOT LINES.

Harold H. Kolb

HAROLD H. KOLB
WISCONSIN REGISTERED LAND SURVEYOR, S-187
DATE March 21, 1973

218-67

BRUNING 40-105 1M-6-71