982396
982396S1.DWG

DEGEN, FOAT SURVEYING ASSOCIATES


100 SOUTH SECOND STREET
WATERFORD, WISCONSIN
(414)534-5404 *(FAX)534-2022*

RECEIVED
FEB 8 2000

PLAT OF SURVEY

LOT 1 OF WALWORTH COUNTY CERTIFIED SURVEY MAP NO._____
BEING A REDIVISION OF LOT 4 OF WALWORTH COUNTY CERTIFIED SURVEY MAP NO. 2160, RECORDED IN VOLUME 10 OF CERTIFIED SURVEY MAPS, PAGE 213, DOCUMENT NO. 235964, AND PART OF THE NORTHEAST 1/4 OF THE NORTHEAST 1/4 OF SECTION 33, TOWNSHIP 3 NORTH, RANGE 18 EAST OF THE FOURTH PRINCIPAL MERIDIAN, TOWNSHIP OF SPRING PRAIRIE, COUNTY OF WALWORTH AND STATE OF WISCONSIN.


SCALE: 1" = 100'

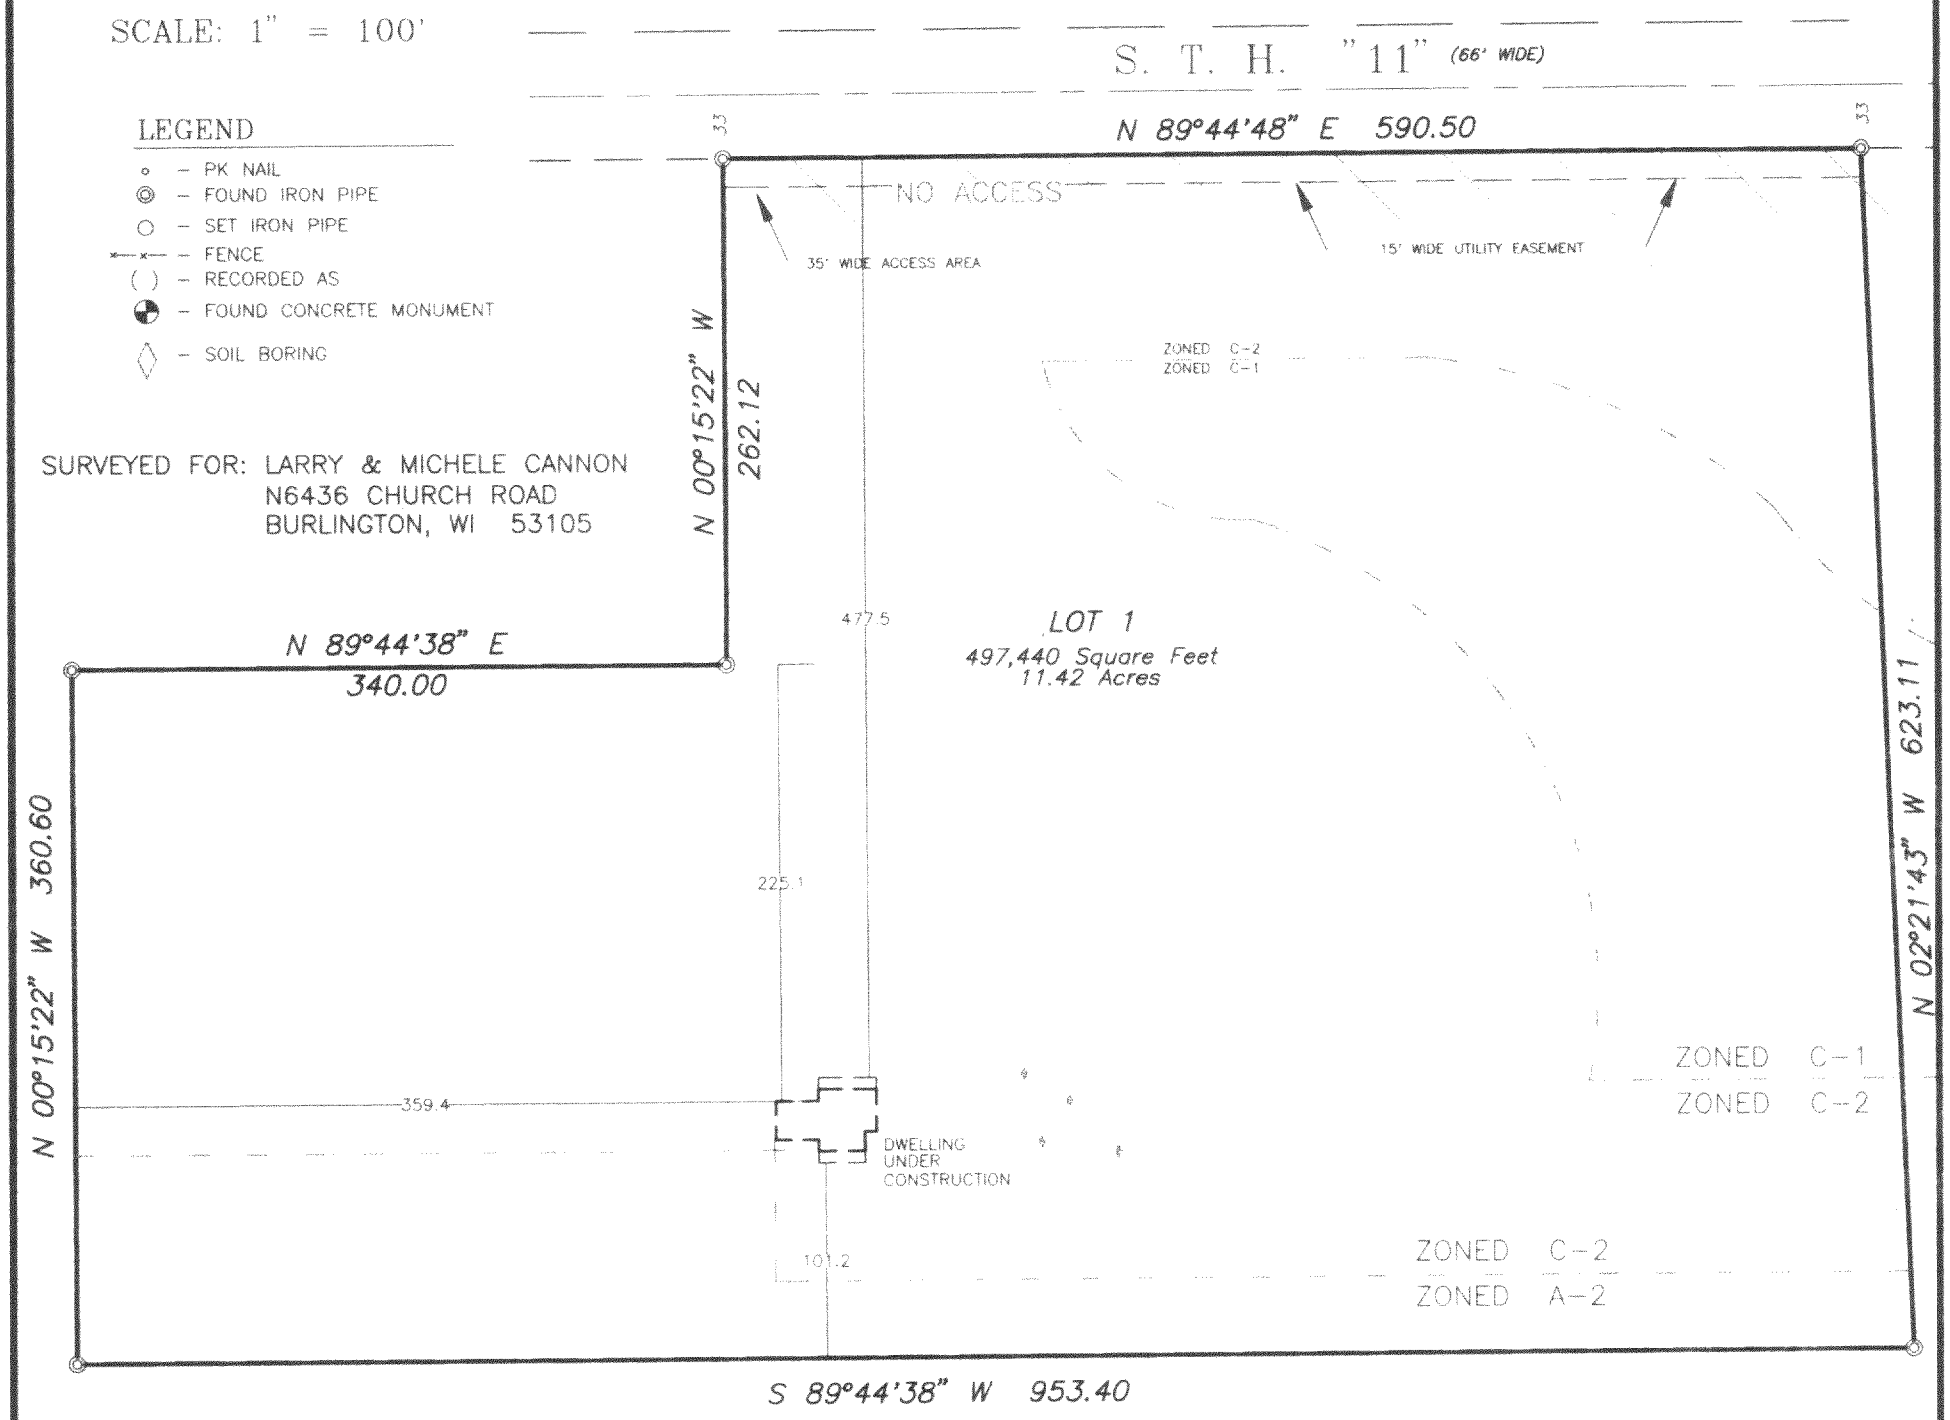

SURVEYED FOR: LARRY & MICHELE CANNON
N6436 CHURCH ROAD
BURLINGTON, WI 53105

LEGEND

- ○ – PK NAIL
- ◎ – FOUND IRON PIPE
- ○ – SET IRON PIPE
- ×—×— – FENCE
- ( ) – RECORDED AS
- ◕ – FOUND CONCRETE MONUMENT
- ◇ – SOIL BORING

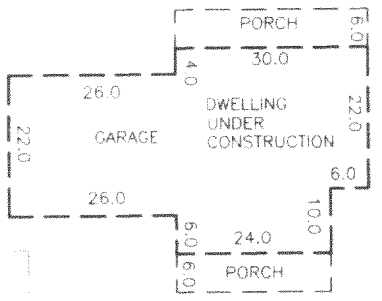

DWELLING DETAIL
SCALE: 1" = 30'

ZONING LINE

I HEREBY CERTIFY THAT I HAVE SURVEYED THE ABOVE DESCRIBED PROPERTY AND THE ABOVE MAP IS A TRUE REPRESENTATION THEREOF AND SHOWS THE SIZE AND LOCATION OF THE PROPERTY, THE LOCATION OF ALL VISIBLE STRUCTURES AND DIMENSIONS OF ALL PRINCIPAL BUILDINGS THEREON, BOUNDARY FENCES, APPARENT EASEMENTS, ROADWAY AND VISIBLE ENCROACHMENTS, IF ANY.

THIS SURVEY IS MADE FOR THE PRESENT OWNERS OF THE PROPERTY, AND ALSO THOSE WHO PURCHASE, OR GUARANTEE THE TITLE THERETO WITHIN (1) YEAR FROM THE DATE HEREOF

DATED AT WATERFORD, WI THIS 17TH DAY OF DECEMBER 19 98

RECERTIFIED OCT. 26, 1999

Gary D. Foat

REVISED: APRIL 30, 1999
BORINGS & ELEVATIONS

OA-3097-1

318-711