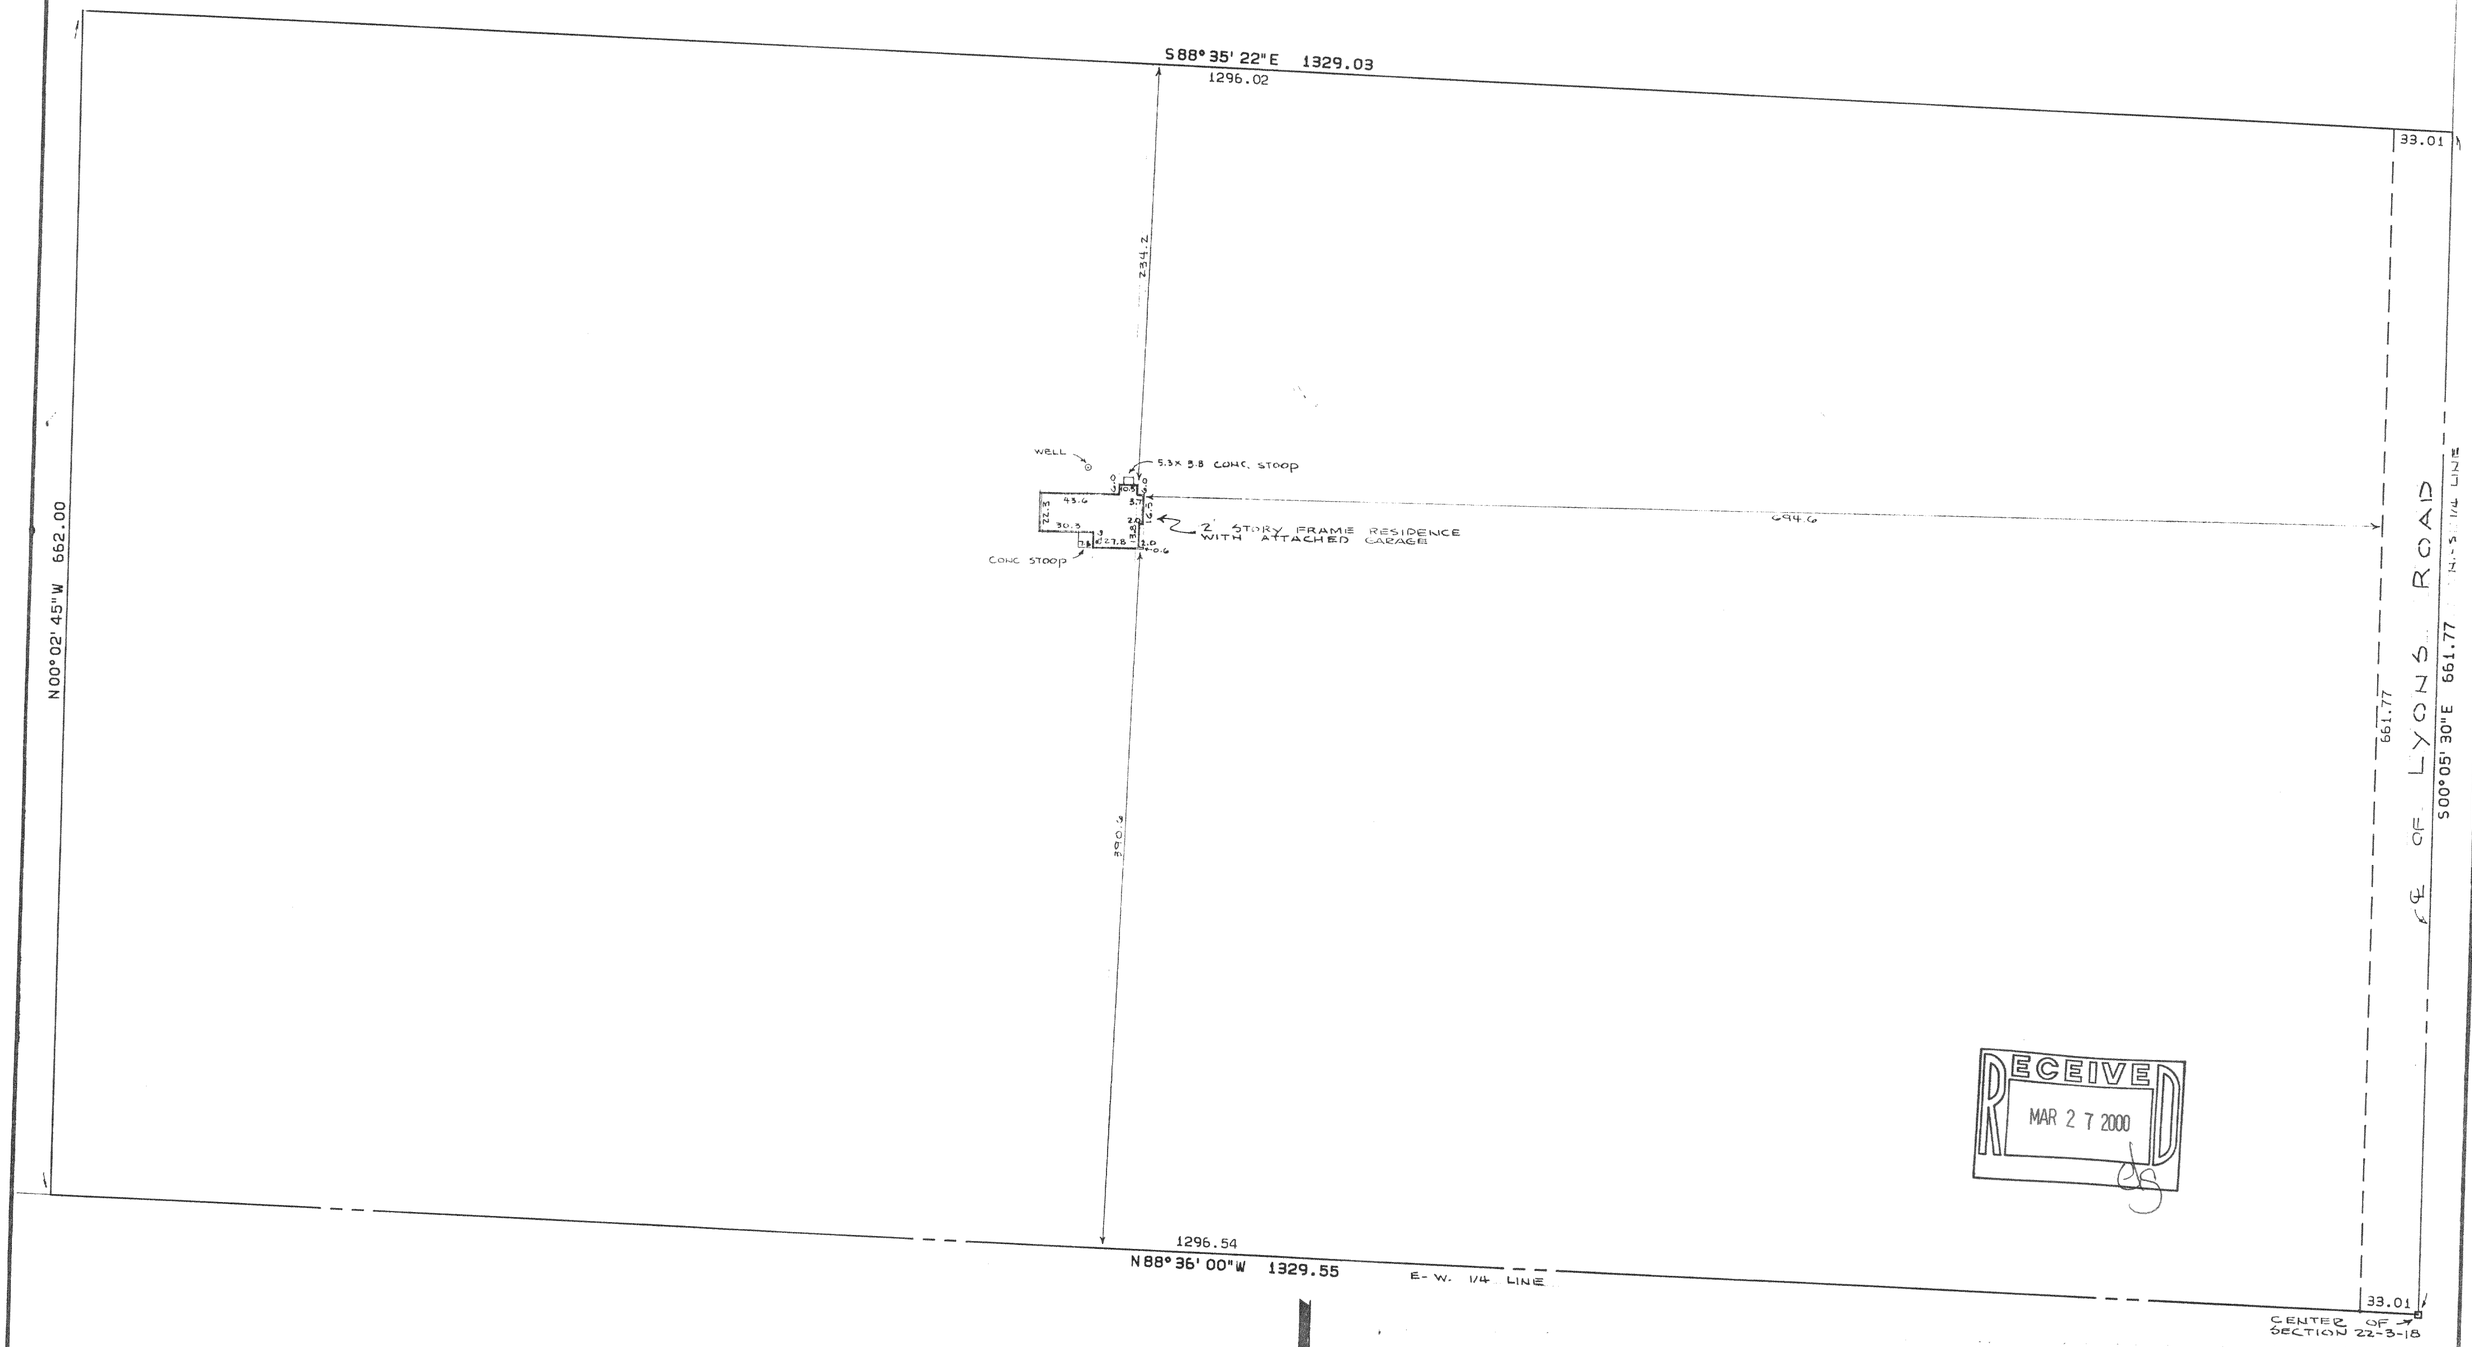

RECEIVED
MAR 27 2000

BEARINGS BASE IS CERTIFIED SURVEY MAP No. 1302

CERTIFICATE
The location of the building depicted hereon has been made under my direction and the above map is a correct representation thereof.
March 10, 1986

NM &B

Nielsen Madsen & Barber
consulting civil engineers and land surveyors
1339 washington avenue · racine, wisconsin 53403
(414) · 634-5588 · 552-7902 · 634-5589

Revised

A DRAWING FOR

WILLIAM J. SHAUGHNESSY

LOT 2 OF CERTIFIED SURVEY MAP No. 1302, IN THE TOWN OF SPRING PRAIRIE, WALWORTH COUNTY, WISC.

Designed	Date	Drawn	Date	Field Work	Date	Horizontal Scale 1"=60'	Sheet ___ of ___ Sheets
		RLD	3-10-86	MVD GME	3-4-86	Vertical Scale	Job Number 83056 A

OA-1302-2

318-714