PLAT of SURVEY AND HOUSE LOCATION OF


LOTS 6, 7, 18 & 19, BLOCK 13 OF HONEY LAKE SUBD. 1ST ADD. TOWN OF SPRING PRAIRIE, WALWORTH COUNTY, WISCONSIN

"I certify that I have surveyed the above described property and that the above plat is an accurate survey and a true representation thereof and correctly shows the exterior boundary lines and location of buildings and other improvements on said property and the correct measurements thereof."

ROBERS & BOYD, INC.
CONSULTING ENGINEERS
116 E. CHESTNUT STREET
BURLINGTON, WISCONSIN

WISCONSIN
IGNATIUS H. ROBERS
BURLINGTON, WIS.
LAND SURVEYOR

LEGEND
○ IRON PIPE
SCALE 1" = 30'

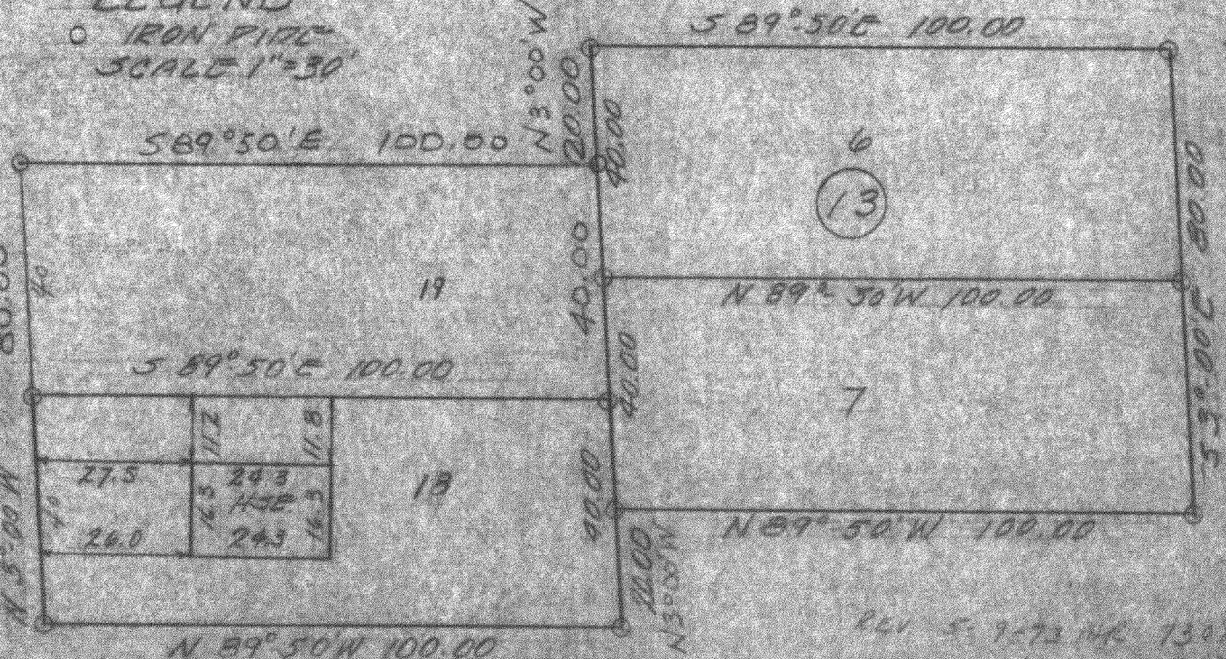

Rec. 5-7-73 Vol. 13 Pg. 39 Doc. #

0411-93,99

318-72