993371
993371S1.DWG


DEGEN, FOAT SURVEYING ASSOCIATES

100 SOUTH SECOND STREET
WATERFORD, WISCONSIN
(262)534-5404 (FAX)534-2022

PLAT OF SURVEY

LOT 1 OF WALWORTH COUNTY CERTIFIED SURVEY MAP NO. 2537, AS RECORDED IN VOLUME 12 OF CERTIFIED SURVEYS ON PAGE 302, WALWORTH COUNTY REGISTER OF DEEDS, LOCATED IN THE NORTHEAST 1/4 AND THE NORTHWEST 1/4 OF THE NORTHWEST 1/4 OF SECTION 26, TOWN 3 NORTH, RANGE 18 EAST OF THE FOURTH PRINCIPAL MERIDIAN, TOWN OF SPRING PRAIRIE, WALWORTH COUNTY, WISCONSIN.

NOTE: SHORELAND BOUNDARY LINE AND ZONING LINE WERE SCALED FROM CERTIFIED SURVEY MAP NO. 2537, AS MAPPED BY JOHN F. DEGEN, DATED SEPT. 23, 1994

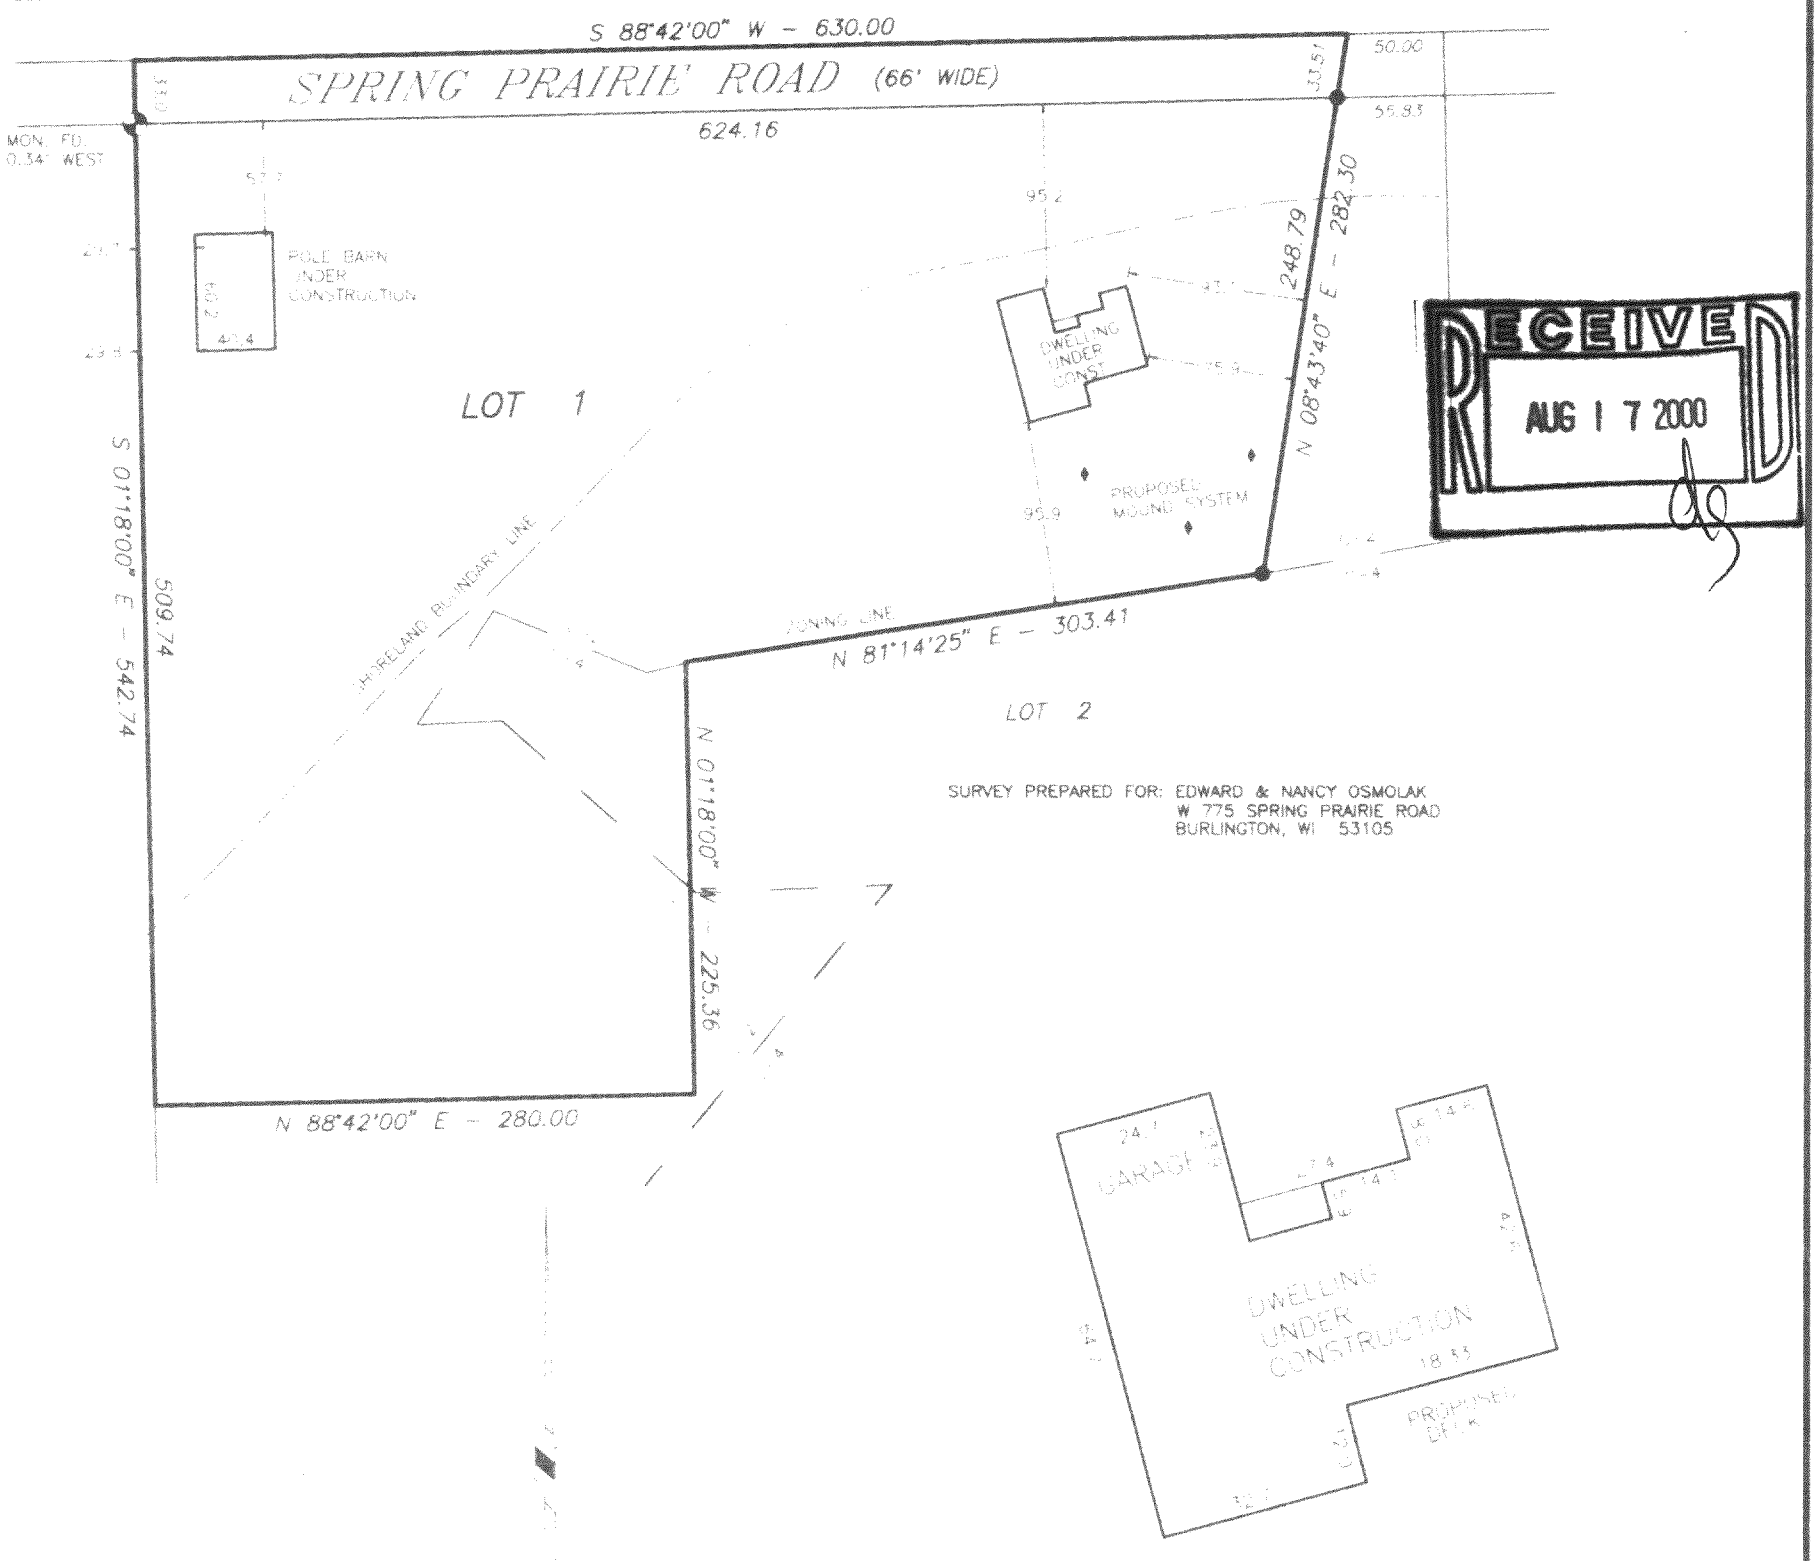

RECEIVED
AUG 17 2000

SURVEY PREPARED FOR: EDWARD & NANCY OSMOLAK
W 775 SPRING PRAIRIE ROAD
BURLINGTON, WI 53105

HOUSE DETAIL
SCALE: 1" = 30'

NOTE: OWNER/CONTRACTOR TO FIELD VERIFY BUILDING DIMENSIONS PRIOR TO EXCAVATION

SCALE: 1" = 100'

LEGEND
- ● - FOUND 3/4" IRON PIPE
- ○ - SET IRON PIPE
- ( ) - RECORDED AS
- ♦ - SOIL BORING
- ◕ - FOUND CONCRETE MONUMENT

IN ACCORDANCE WITH A-E 7.01(2)(b) OF THE WISCONSIN ADMINISTRATIVE CODE Edward Osmolak, OWNER AND Gary Foat, SURVEYOR DO HEREBY
EDWARD OSMOLAK GARY FOAT
MUTUALLY AGREE TO WAIVE MONUMENTATION OF THE ABOVE DESCRIBED PARCEL.

HEREBY CERTIFY THAT I HAVE SURVEYED THE ABOVE DESCRIBED PROPERTY AND THE ABOVE MAP IS A TRUE REPRESENTATION THEREOF AND SHOWS THE SIZE AND LOCATION OF THE PROPERTY, THE LOCATION OF ALL VISIBLE STRUCTURES AND DIMENSIONS OF ALL PRINCIPAL BUILDINGS THEREON, BOUNDARY FENCES, APPARENT EASEMENTS, ROADWAY AND VISIBLE ENCROACHMENTS, IF ANY.

THIS SURVEY IS MADE FOR THE PRESENT OWNERS OF THE PROPERTY AND ALSO THOSE WHO PURCHASE, OR GUARANTEE THE TITLE THERETO WITHIN (1) YEAR FROM THE DATE HEREOF.

DATED AT WATERFORD THIS 16 DAY OF NOVEMBER, 19 99

RECERTIFIED MARCH 2, 2000 Gary Foat

318-729

OA-2537-1