
ROBERS & BOYD, INC.
CONSULTING ENGINEERS & LAND SURVEYORS
PHONE (414) 763-2652 116 E. CHESTNUT ST. BURLINGTON, WIS. 53105

PLAT OF SURVEY
WAVELAND
OF
LOTS 5, 6 & 7 BLOCK 3, WAVELAND PARK
PART OF THE SE 1/4 OF SECTION 9, T3N, R19E,
TOWN OF SPRING PRAIRIE, WALWORTH CO., WIS.

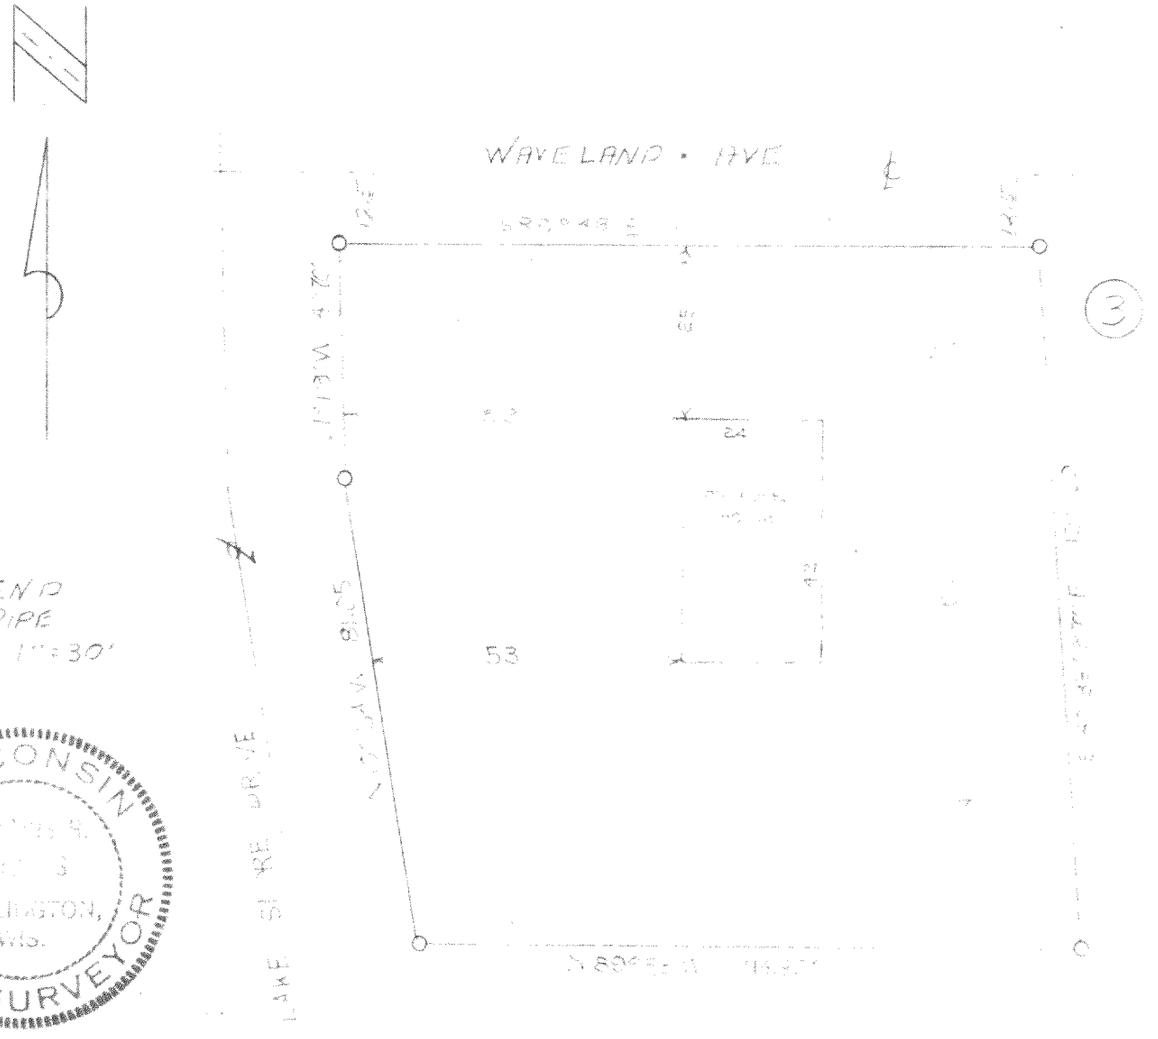

LEGEND
O IRON PIPE
SCALE 1"=30'

WISCONSIN
REGISTERED
NO. S-1113
BURLINGTON,
WIS.
LAND SURVEYOR

I HEREBY CERTIFY THAT WE HAVE SURVEYED THE LANDS DESCRIBED ABOVE ACCORDING TO OFFICIAL RECORDS AND THAT THE PLAT DRAWN HEREON IS A CORRECT REPRESENTATION OF SAID SURVEY.

Christian H. Roberts
WIS. REG. LAND SURVEYOR S-1113

DATE 6-13-73

JOB NO. 7310E

K & E 10-7155 250-8-72 OHL-15

318-83