
Plat of Survey

of

Lot 1 of Certified Survey Map No. 3459,

recorded in Vol. 20 of Certified Survey Maps of Walworth County on Page 87 and located in the Southeast 1/4 of the Northwest 1/4 of Section 1, Town 3 North, Range 18 East, Town of Spring Prairie, Walworth County, Wisconsin.

Surveyed for: **Richard E. Stevens, Jr.**
N7125 Bell School Road
Burlington, Wisconsin. 53105

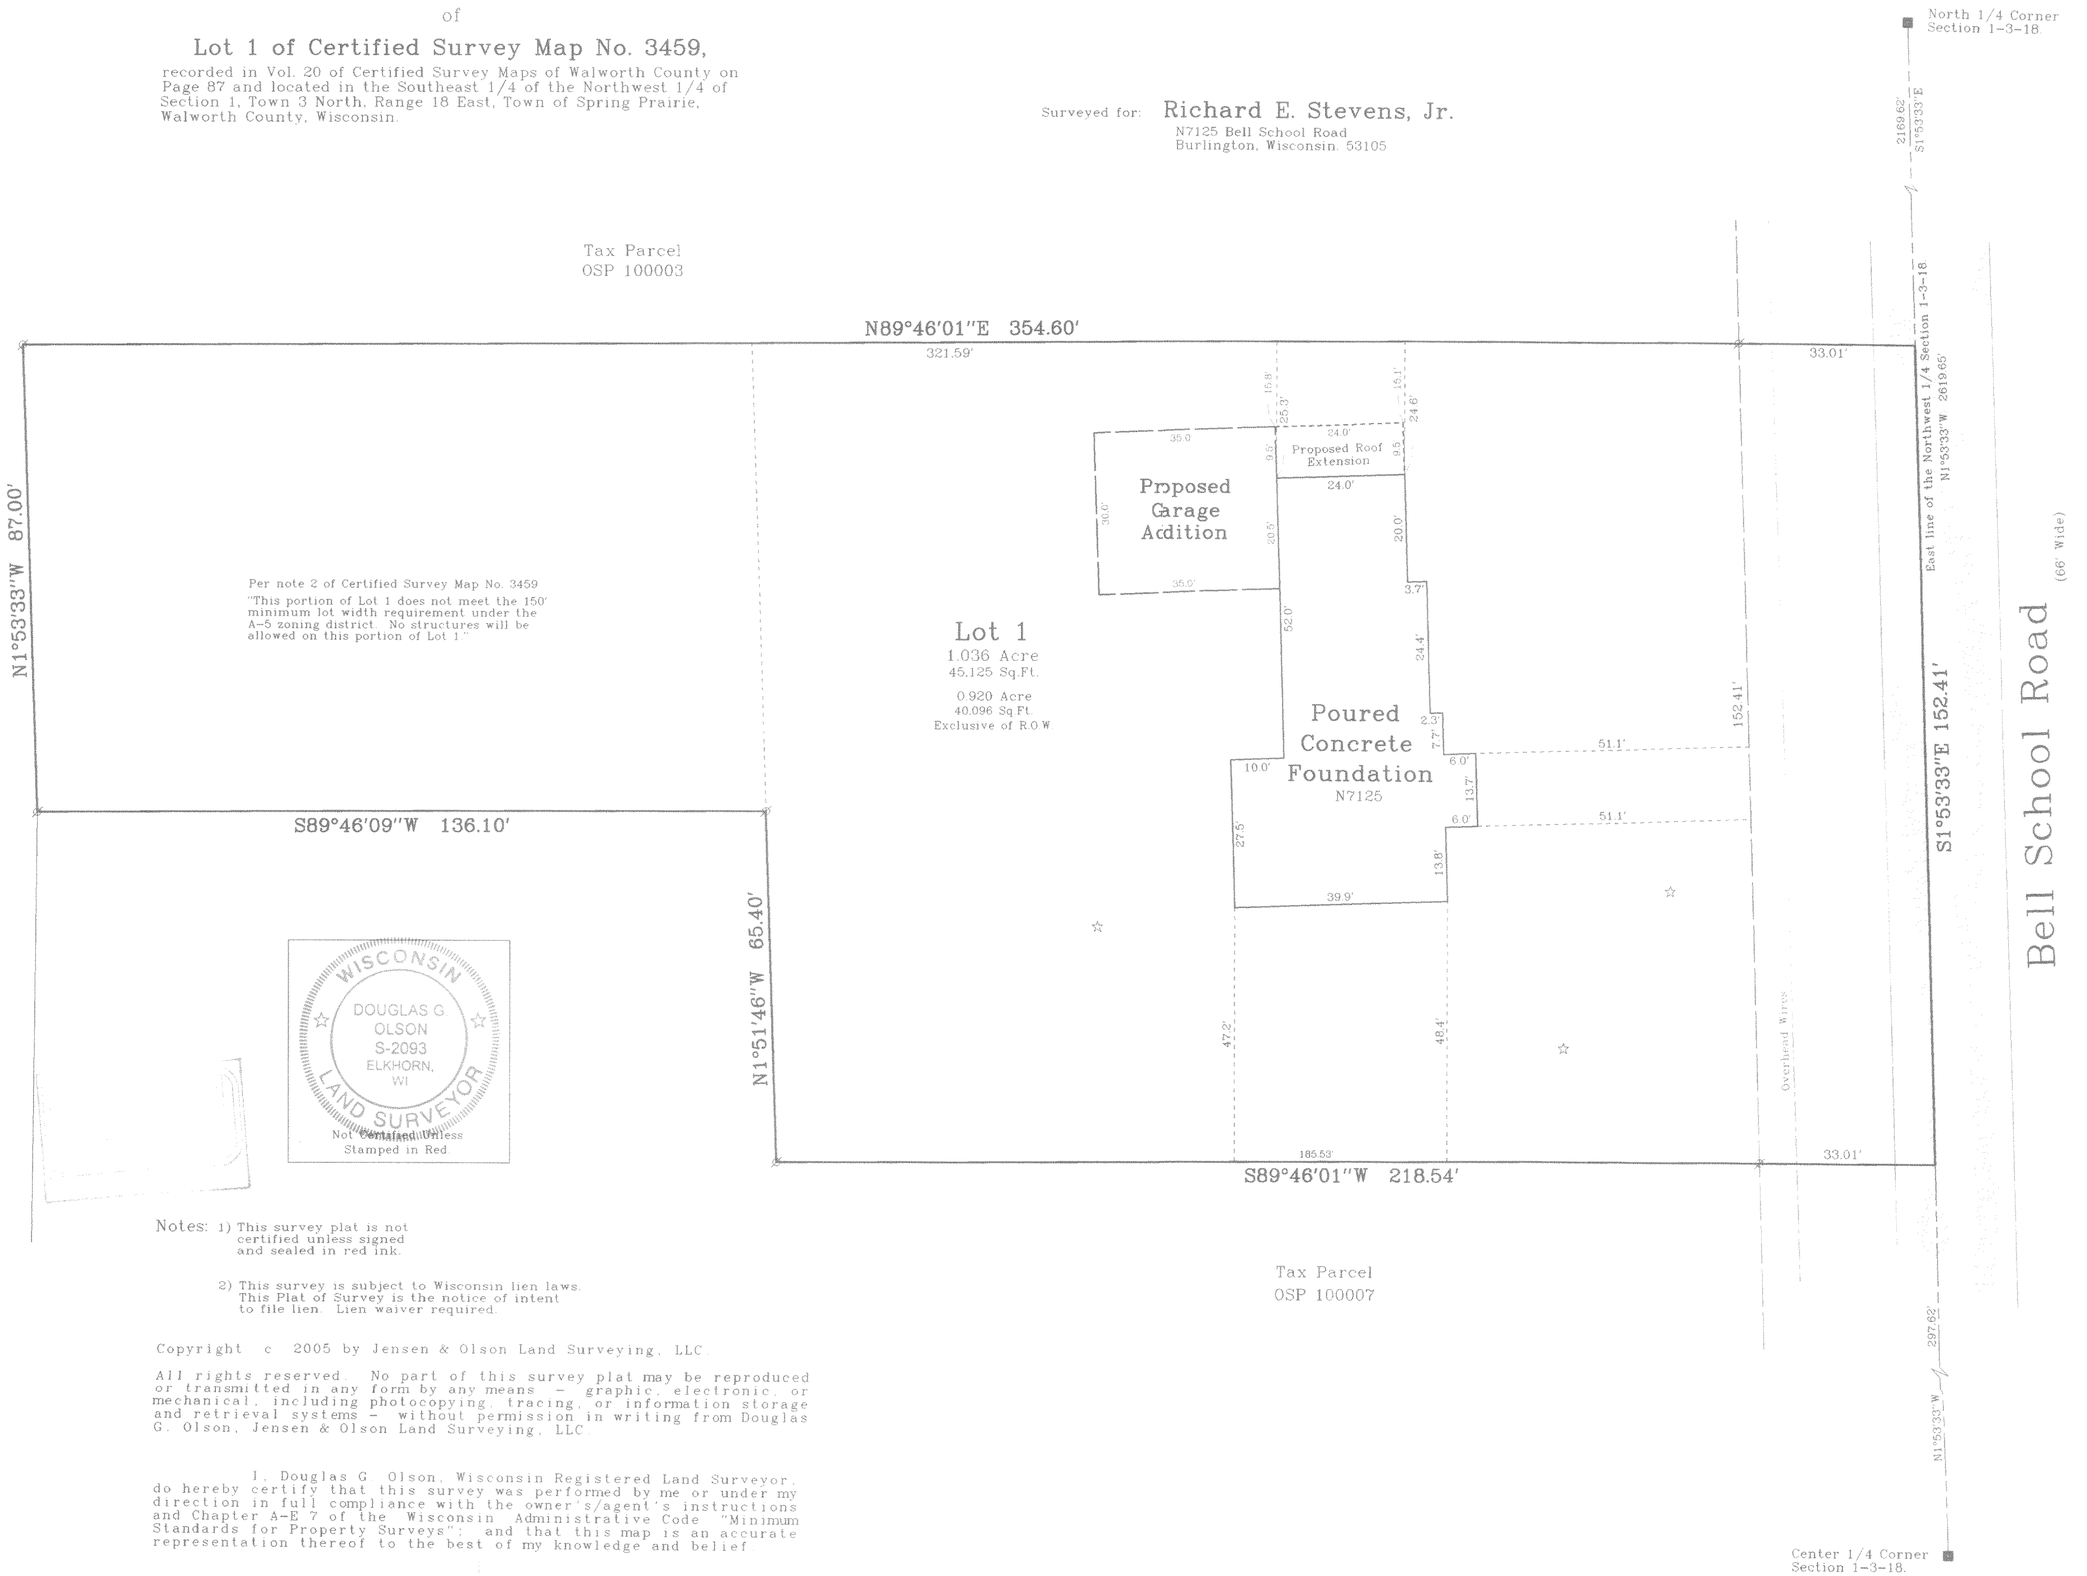

WISCONSIN
DOUGLAS G. OLSON
S-2093
ELKHORN, WI
LAND SURVEYOR
Not Certified Unless Stamped in Red

Notes: 1) This survey plat is not certified unless signed and sealed in red ink.

2) This survey is subject to Wisconsin lien laws. This Plat of Survey is the notice of intent to file lien. Lien waiver required.

Copyright © 2005 by Jensen & Olson Land Surveying, LLC

All rights reserved. No part of this survey plat may be reproduced or transmitted in any form by any means - graphic, electronic, or mechanical, including photocopying, tracing, or information storage and retrieval systems - without permission in writing from Douglas G. Olson, Jensen & Olson Land Surveying, LLC.

I, Douglas G. Olson, Wisconsin Registered Land Surveyor, do hereby certify that this survey was performed by me or under my direction in full compliance with the owner's/agent's instructions and Chapter A-E 7 of the Wisconsin Administrative Code "Minimum Standards for Property Surveys"; and that this map is an accurate representation thereof to the best of my knowledge and belief.

Douglas G. Olson
Wisconsin Registered Land Surveyor - 2093

Survey Date: July 2, 2002
Revisions: No. 1 - Set stakes
No. 2 - CSM rec. info
No. 3 - Foundation
No. 4 - Prop Addition

Scale in Feet
1" = 20'
0' 10' 20' 40'

Jensen & Olson Land Surveying, LLC
45 South Wisconsin Street
Elkhorn, Wisconsin.
Telephone (262) 723-3434
Facsimile (262) 723-6044

Legend
- Found County Section Corner
- Found Iron Rod, 3/4" dia.
- (R) Recorded Information
- Soil Boring
- Asphalt Surface

Sheet 1 of 1 Sheets

Job Reference Number
2005.043

2005.043