
PLAT OF SURVEY OF
THE NORTHEASTERLY LINE OF

PART OF BLACKSTONE DRIVE LYING BETWEEN BLOCKS 18 AND 19, HONEY LAKE SUBDIVISION FIRST ADDITION, ACCORDING TO THE RECORDED PLAT THEREOF, AND BEING MORE PARTICULARLY DESCRIBED AS FOLLOWS: COMMENCE AT THE MOST NORTHERLY CORNER OF SAID BLOCK 19; THENCE NORTH 33°52' EAST ALONG THE SOUTHEASTERLY LINE OF KENMORE AVENUE 40.00 FEET TO A POINT ON THE SOUTHERLY LINE OF SAID BLOCK 18; THENCE SOUTH 55°10' EAST ALONG SAID SOUTHERLY LINE, 163.00 FEET TO A POINT ON THE WESTERLY LINE OF COUNTY TRUNK HIGHWAY "DD"; THENCE SOUTH 33°52' WEST ALONG SAID WESTERLY LINE 40.00 FEET TO A POINT ON THE NORTHERLY LINE OF SAID BLOCK 19; THENCE NORTH 55°10' WEST ALONG SAID NORTHERLY LINE 163.00 FEET TO THE PLACE OF BEGINNING. SAID LAND BEING IN THE TOWNSHIP OF SPRING PRAIRIE, WALWORTH COUNTY, WISCONSIN.

SURVEY FOR: JERRY & SUE POPELIER

SURVEY ADDRESS: N6199 COUNTY ROAD "DD"

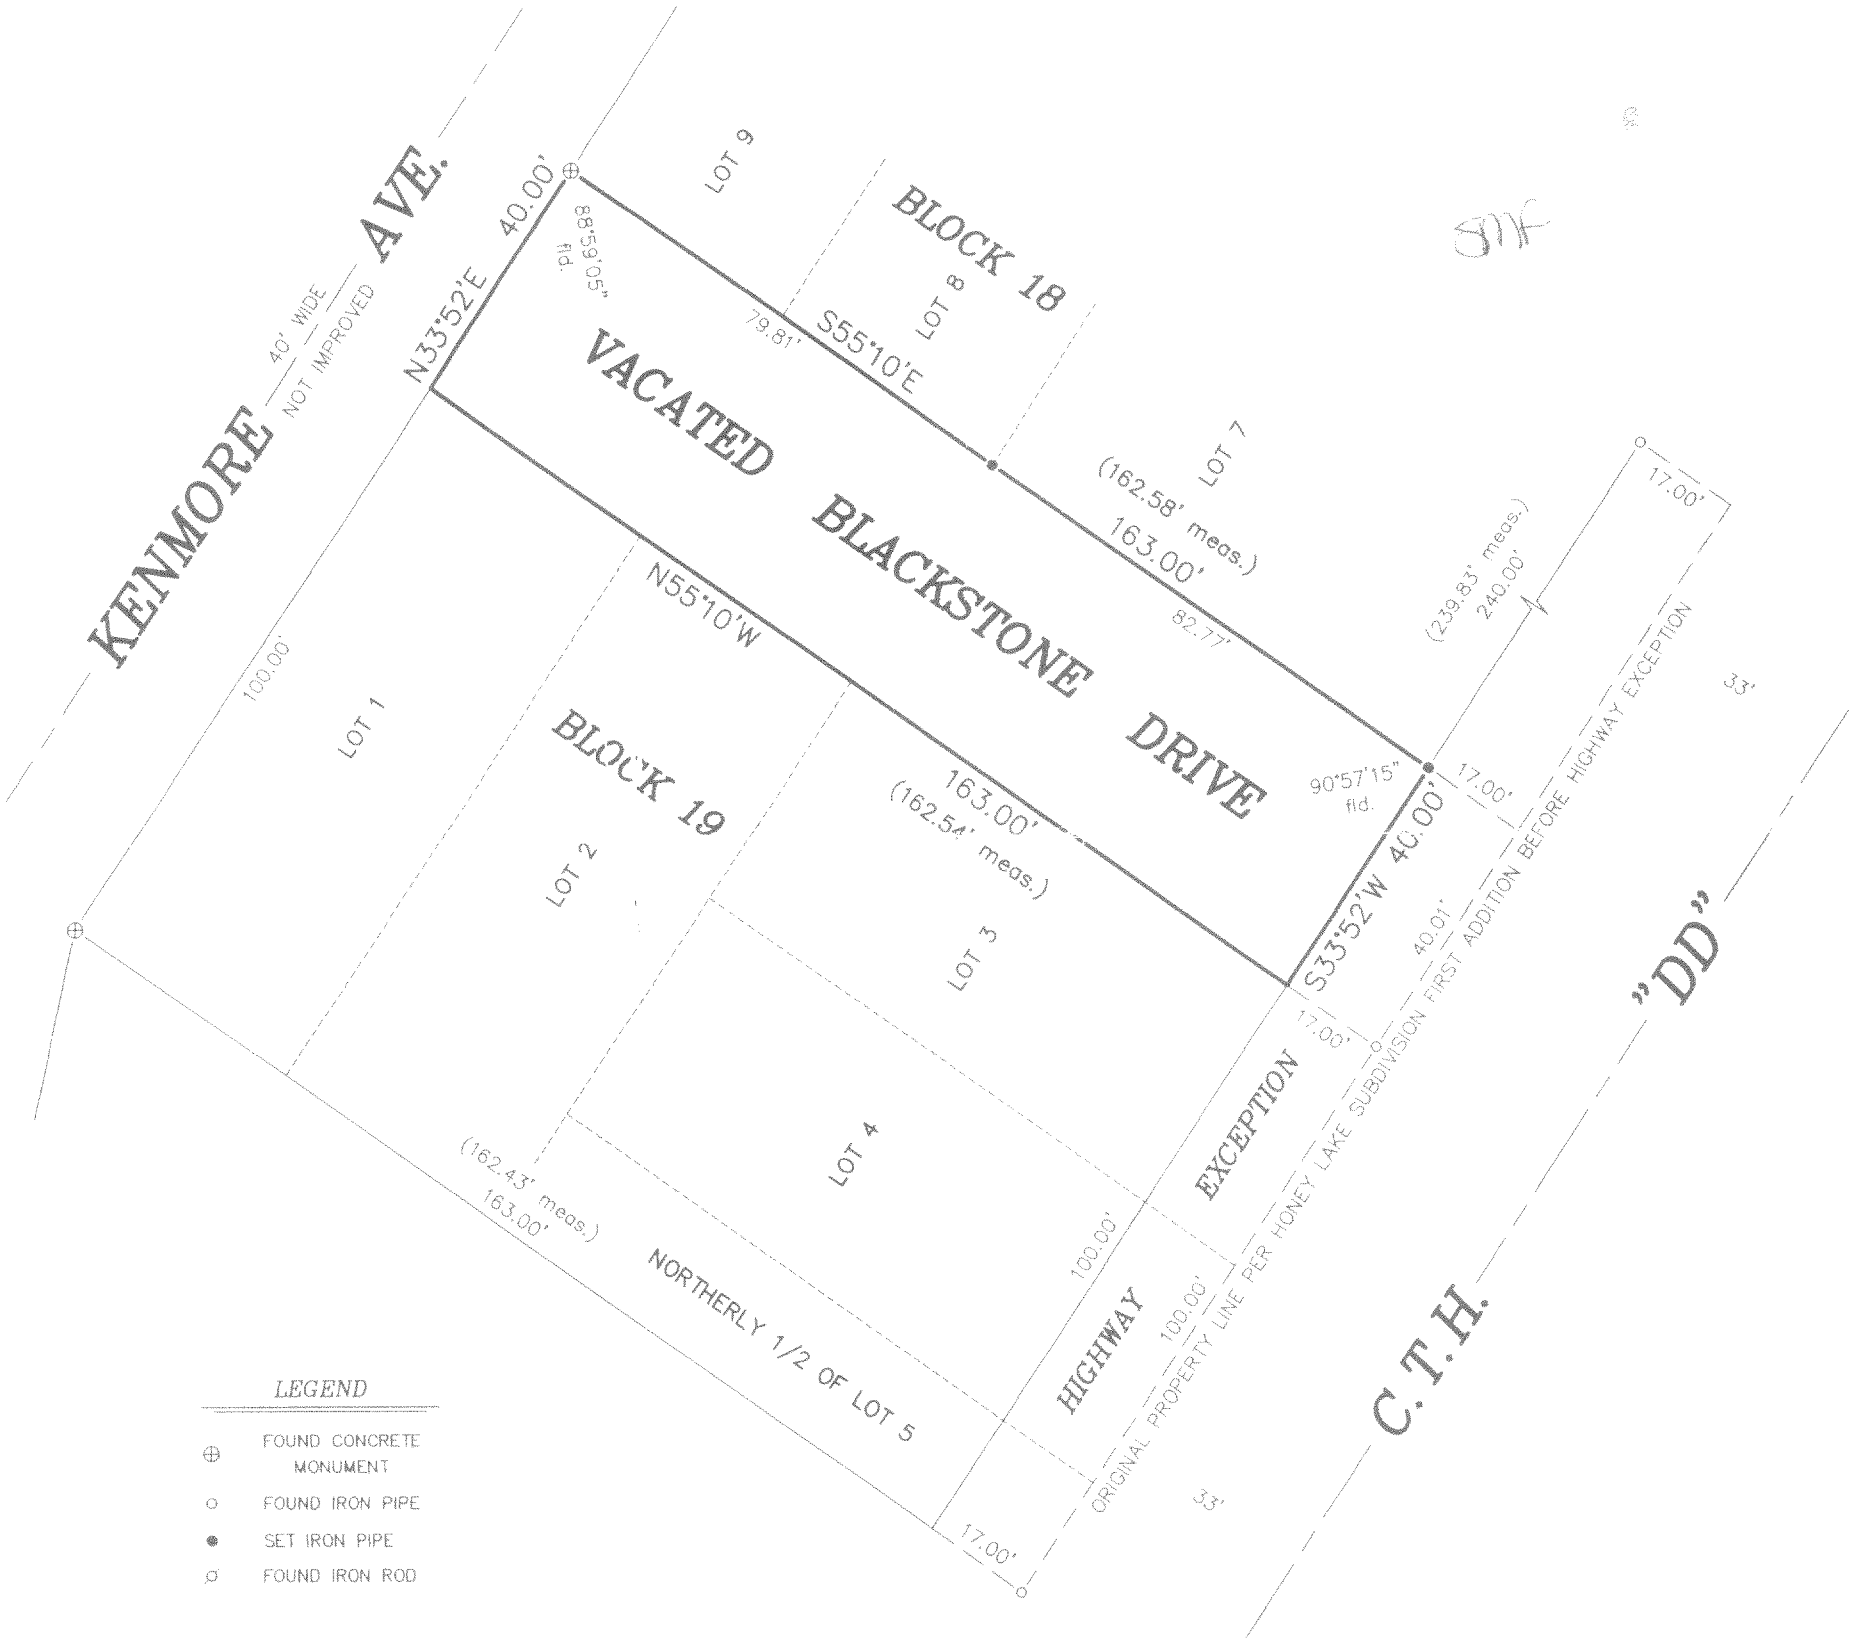


LEGEND

- ⊕ FOUND CONCRETE MONUMENT
- ○ FOUND IRON PIPE
- ● SET IRON PIPE
- ○ FOUND IRON ROD

"I hereby certify that I have surveyed the above described property and that the above map is a correct representation thereof and shows the size and location of the property, its exterior boundaries, the location of all visible structures and dimensions of all principal buildings thereon, boundary fences, apparent easements, roadways and encroachments, if any."

"This survey is made for the use of the present owners of the property, and those who purchase, mortgage, or guarantee the title thereto within one year from date hereof."

SCALE: 1" = 30'

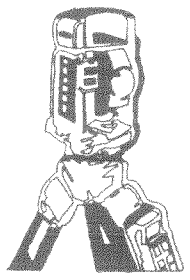

B.W. SURVEYING, INC.

LAND SURVEYS
MAPPING AND PLANNING
412 N. PINE STREET
BURLINGTON, WI 53105
(262)-767-0225

WISCONSIN

THIS IS NOT AN ORIGINAL PRINT UNLESS THIS SEAL IS RED.

Robert J. Wetzel

ROBERT J. WETZEL S-1778

REVISED: NOVEMBER 2, 2005

MAY 2, 2001 — DATE

4968 — JOB NUMBER

CHL-133

318-938