Property Exhibit


of

The location of an existing gravel drive,

located in the Southwest 1/4 of Section 10 and the Northwest 1/4 of Section 15, Town 3 North, Range 18 East, Town of Spring Prairie, Walworth County, Wisconsin.

Prepared for: Church Road Extension Organization

Bearings reference to the Wisconsin State Plane Coordinate System, South Zone.

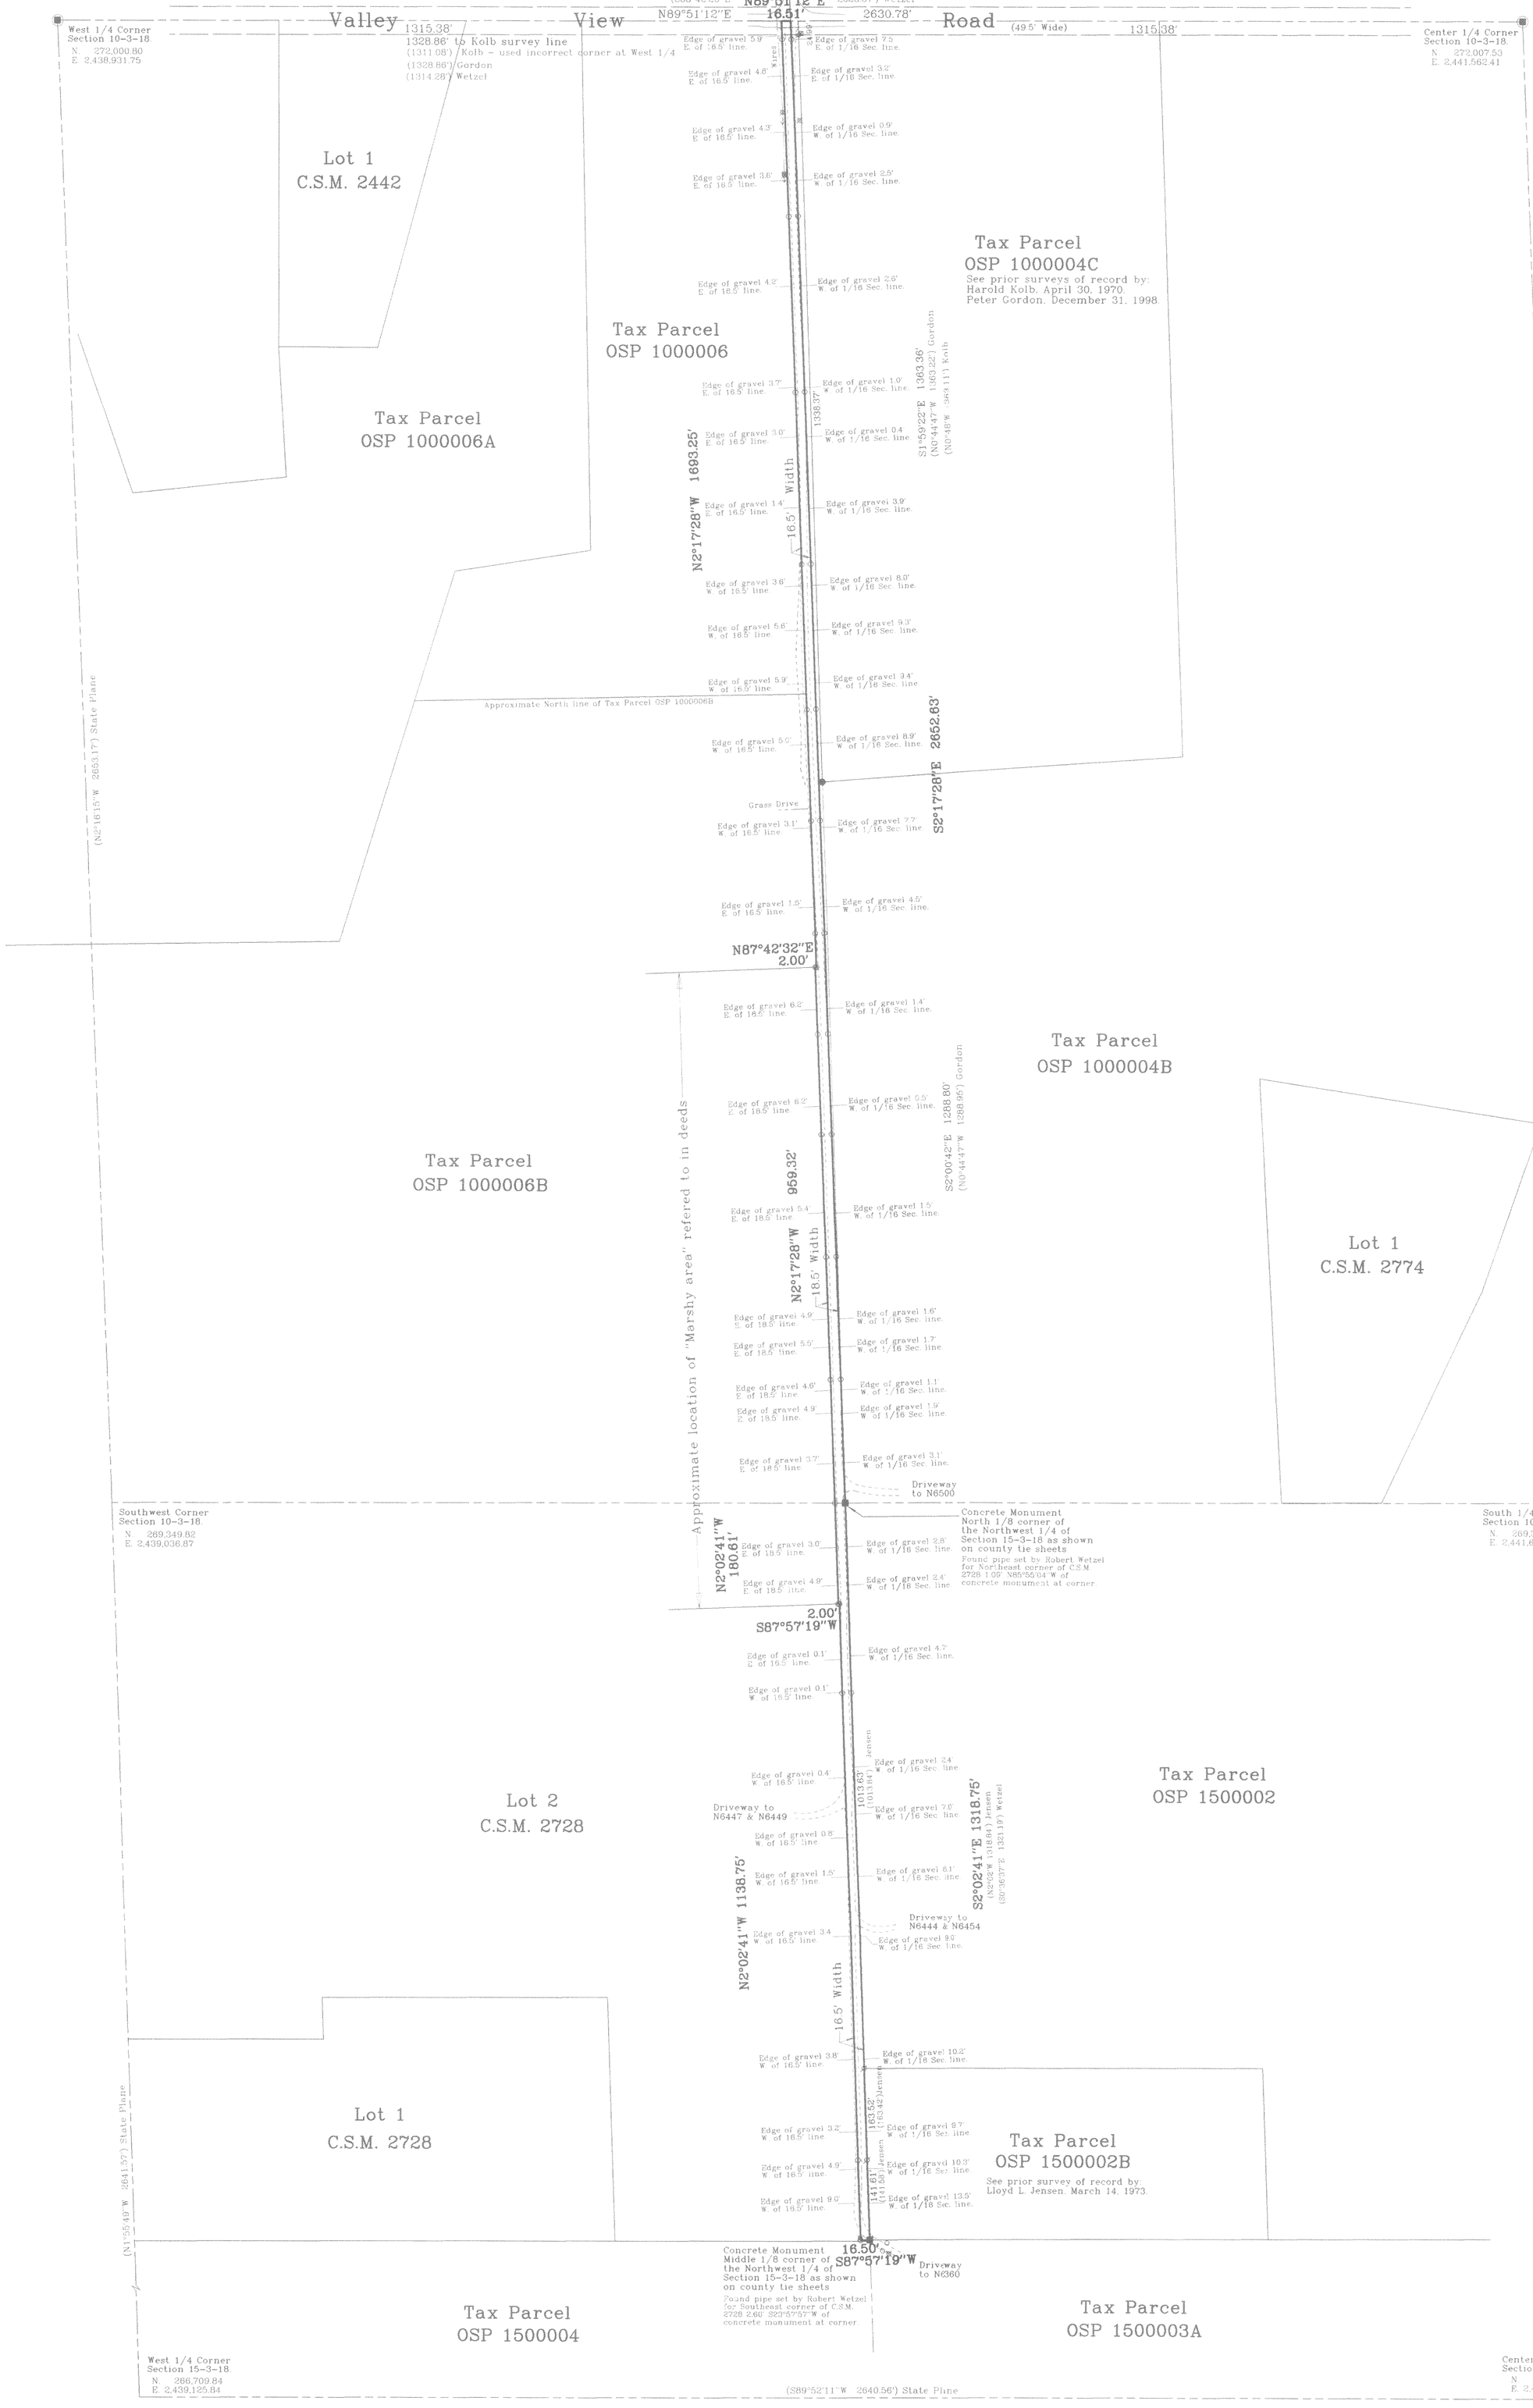

WISCONSIN DOUGLAS G OLSON S-2093 ELKHORN WI LAND SURVEYOR

MAR 17 2005

Sheet 1 of 3 Sheets.

Job Reference Number

2004.127

2004.127

Legend

- Found Concrete Monument
- Found Iron Pipe
- Found Iron Rod
- Set Wood Lath ○Set Iron Rod
- ( ) Recorded Information
- Utility Pole
- Utility Pedestal
- Asphalt Surface
- Gravel Surface

Jensen & Olson Land Surveying, LLC

45 South Wisconsin Street P.O. Box 322
Elkhorn, Wisconsin. 53121
Telephone: (262) 723-3434
Facsimile: (262) 723-8044

Scale in Feet

1" = 150'

0' 75' 150' 300' 450'

Survey date: September 17, 2004.

Revisions: No. 1 - Set Iron Rods
No. 2 - Corrections

OSP 1-4C OSP1-6 OSP1-6B OSP1-4B OSP15-2 OSP15-23
OA2728-2

318-948

Property Exhibit

of

The location of an existing gravel drive,

located in the Southwest 1/4 of Section 10 and the Northwest 1/4 of Section 15, Town 3 North, Range 18 East, Town of Spring Prairie, Walworth County, Wisconsin.

Prepared for: Church Road Extension Organization

Bearings reference to the Wisconsin State Plane Coordinate System, South Zone

Valley View Road

Church Road (49.5' Wide)

West 1/4 Corner
Section 10-3-18.
N. 272,000.80
E. 2,438,931.75

Center 1/4 Corner
Section 10-3-18.
N. 272,007.53
E. 2,441,562.41

1315.38'
1328.86' to Kolb survey line
(1311.08') Kolb - used incorrect corner at West 1/4
(1328.86') Gordon
(1314.28') Wetzel

(S88°54'E
(S88°42'25"E
N89°51'12"E
N89°51'12"E 16.51' 1348' 2630.78'
2622.16') Kolb
2628.57') Wetzel

(49.5' Wide)

1315.38'

Edge of gravel 5.9' E. of 16.5' line.
Edge of gravel 7.5' E. of 1/16 Sec. line.
33.00'
24.89'
Overhead Wires
Edge of gravel 4.8' E. of 16.5' line.
Edge of gravel 3.2' E. of 1/16 Sec. line.
Edge of gravel 4.3' E. of 16.5' line.
Edge of gravel 0.9' W. of 1/16 Sec. line.
315.62'
315.00'
Edge of gravel 3.6' E. of 16.5' line.
Edge of gravel 2.5' W. of 1/16 Sec. line.
Edge of gravel 4.2' E. of 16.5' line.
Edge of gravel 2.6' W. of 1/16 Sec. line.
314.63'
314.63'
S1°59'22"E 1363.36'
(N0°44'47"W 1363.22') Gordon
(N0°48'W 1363.11') Kolb
Edge of gravel 3.7' E. of 16.5' line.
Edge of gravel 1.0' W. of 1/16 Sec. line.
1338.37'
Edge of gravel 3.0' E. of 16.5' line.
Edge of gravel 0.4' W. of 1/16 Sec. line.
N2°17'28"W 1693.25'
310.00'
310.00'
Edge of gravel 1.4' E. of 16.5' line.
Edge of gravel 3.9' W. of 1/16 Sec. line.
16.5' Width
West edge of ditch 3.8' W. of 16.5' line.
Edge of gravel 8.0' W. of 1/16 Sec. line.
Edge of gravel 3.6' W. of 16.5' line.
West edge of ditch 10.4' W. of 16.5' line.
Edge of gravel 9.3' W. of 1/16 Sec. line.
Edge of gravel 5.6' W. of 16.5' line.
260.00'
260.00'
West edge of ditch 15.8' W. of 16.5' line.
Edge of gravel 5.9' W. of 16.5' line.
Edge of gravel 9.4' W. of 1/16 Sec. line.
West edge of ditch 13.6' W. of 16.5' line.
West edge of ditch
428'
West edge of ditch 12.0' W. of 16.5' line.
Edge of gravel 8.9' W. of 1/16 Sec. line.
Edge of gravel 5.0' W. of 16.5' line.
200.00'
200.00'
West edge of ditch 15.0' W. of 16.5' line.
6.29'
S2°17'28"E 2652.63'
West edge of ditch 7.0' W. of 16.5' line.
Centerline of Grass Drive
Edge of gravel 3.1' W. of 16.5' line.
Edge of gravel 7.7' W. of 1/16 Sec. line.
200.00'
200.00'
Edge of gravel 1.5' E. of 16.5' line.
Edge of gravel 4.5' W. of 1/16 Sec. line.
160.00'
N87°42'32"E 2.00'
Approximate location of "Marshy area" refered to in deeds
18.5' Width
120.00'
186.00'
Edge of gravel 6.2' E. of 18.5' line.
Edge of gravel 3.4' W. of 1/16 Sec. line.
N2°17'28"W 959.32'
180.00'
180.00'
S2°00'42"E 1288.80'
(N0°44'47"W 1288.95') Gordon
Edge of gravel 6.2' E. of 18.5' line.
Edge of gravel 0.5' W. of 1/16 Sec. line.

Lot 1
C.S.M. 2442

Tax Parcel
OSP 1000006

Tax Parcel
OSP 1000006A

Tax Parcel
OSP 1000004C

See prior surveys of record by:
Harold Kolb, April 30, 1970
Peter Gordon, December 31, 1998.

Approximate North line of Tax Parcel OSP 1000006B

Tax Parcel
OSP 1000004B

Tax Parcel
OSP 1000006B

Lot 1
C.S.M. 2774

Match Line
See Sheet 3

WISCONSIN
DOUGLAS O. OLSON
S-2557
ELKHORN
LAND SURVEYOR

MAR 17 2005

Sheet 2 of 3 Sheets.

Job Reference Number
2004.127

2004.127

Legend

- Found Concrete Monument
- Found Iron Pipe
- Found Iron Rod
- Set Wood Lath ○Set Iron Rod
- ( ) Recorded Information
- Utility Pole
- Utility Pedestal
- Asphalt Surface
- Gravel Surface

Jensen & Olson Land Surveying, LLC
45 South Wisconsin Street P.O. Box 322
Elkhorn, Wisconsin. 53121
Telephone: (262) 723-3434
Facsimile: (262) 723-8044

Scale in Feet
1" = 75'
0' 37.5' 75' 150' 225'

Survey date: September 17, 2004.
Revisions: No. 1 - Set Iron Rods
No. 2 - Corrections

Property Exhibit

of

The location of an existing gravel drive,

located in the Southwest 1/4 of Section 10 and the Northwest 1/4 of Section 15, Town 3 North, Range 18 East, Town of Spring Prairie, Walworth County, Wisconsin.

Prepared for: Church Road Extension Organization

See Sheet 2
Match Line

Bearings reference to the Wisconsin State Plane Coordinate System, South Zone.

Tax Parcel
OSP 1000006B

Tax Parcel
OSP 1000004B

Lot 2
C.S.M. 2728

Lot 1
C.S.M. 2728

Tax Parcel
OSP 1500002

Tax Parcel
OSP 1500002B
See prior survey of record by:
Lloyd L. Jensen, March 14, 1973.

Tax Parcel
OSP 1500004

Tax Parcel
OSP 1500003A

Approximate location of "Marshy area" refered to in deeds

18.5' Width
N2°17'28"W 959.32'
S2°17'28"E 2652.83'
180.00'
220.00'
S2°00'42"E 1288.80' (N0°44'47"W 1288.95') Gordon

Edge of gravel 5.4' E. of 18.5' line.
Edge of gravel 1.5' W. of 1/16 Sec. line.
Edge of gravel 4.9' E. of 18.5' line.
Edge of gravel 1.6' W. of 1/16 Sec. line.
Edge of gravel 5.5' E. of 18.5' line
Edge of gravel 1.7' W. of 1/16 Sec. line.
Edge of gravel 4.5' E. of 18.5' line.
Edge of gravel 1.1' W. of 1/16 Sec. line.
Edge of gravel 4.9' E. of 18.5' line.
Edge of gravel 1.9' W. of 1/16 Sec. line.
219.32'
220.00'
Edge of gravel 3.7' E. of 18.5' line.
Edge of gravel 3.1' W. of 1/16 Sec. line.

Driveway to N6500

Concrete Monument
North 1/8 corner of the Northwest 1/4 of Section 15-3-18 as shown on county tie sheets
Found pipe set by Robert Wetzel for Northeast corner of C.S.M. 2728 1.09' N85°55'04"W of concrete monument at corner.

N2°02'41"W 180.61'
Edge of gravel 3.0' E. of 18.5' line.
Edge of gravel 2.8' W. of 1/16 Sec. line.
Edge of gravel 4.9' E. of 18.5' line.
Edge of gravel 2.4' W. of 1/16 Sec. line.
338.75'
2.00'
S87°57'19"W
Edge of gravel 0.1' E. of 16.5' line.
Edge of gravel 4.7' W. of 1/16 Sec. line.
Edge of gravel 0.1' W. of 16.5' line.

Edge of gravel 2.4' W. of 1/16 Sec. line.
Edge of gravel 0.4' W. of 16.5' line.
1013.63' (1013.84') Jensen
Driveway to N6447 & N6449
Edge of gravel 7.0' W. of 1/16 Sec. line.
Edge of gravel 0.8' W. of 16.5' line.
S2°02'41"E 1318.75' (S0°36'07"E 1321.19') Wetzel (N2°02'W 1318.84') Jensen.
674.88'
Edge of gravel 1.5' W. of 16.5' line.
Edge of gravel 6.1' W. of 1/16 Sec. line.
1138.75'
838.00'
Driveway to N6444 & N6454
Edge of gravel 3.4' W. of 16.5' line.
Edge of gravel 9.0' W. of 1/16 Sec. line.
16.5' Width
N2°02'41"W
Edge of gravel 3.8' W. of 16.5' line.
Edge of gravel 10.2' W. of 1/16 Sec. line.
163.52' (163.42') Jensen
Edge of gravel 3.2' W. of 16.5' line.
Edge of gravel 9.7' W. of 1/16 Sec. line.
Edge of gravel 4.9' W. of 16.5' line.
Edge of gravel 10.3' W. of 1/16 Sec. line.
141.61' (141.58') Jensen
142.00'
Edge of gravel 9.0' W. of 16.5' line.
Edge of gravel 13.5' W. of 1/16 Sec. line.
16.50'
S87°57'19"W
Driveway to N6360

Concrete Monument
Middle 1/8 corner of the Northwest 1/4 of Section 15-3-18 as shown on county tie sheets
Found pipe set by Robert Wetzel for Southeast corner of C.S.M. 2728 2.60' S23°57'57"W of concrete monument at corner.

(S89°52'11"W 2640.56') State Plane

WISCONSIN
DOUGLAS O OLSON S-2093 ELKHORN WI
LAND SURVEYOR

MAR 17 [illegible]

2004.127

Sheet 3 of 3 Sheets.

Job Reference Number
2004.127

Legend
- ■ Found Concrete Monument
- ⌀ Found Iron Pipe
- ● Found Iron Rod
- □ Set Wood Lath ○Set Iron Rod
- ( ) Recorded Information
- ⊠ Utility Pole
- ⊠ Utility Pedestal
- Asphalt Surface
- Gravel Surface

Jensen & Olson Land Surveying, LLC
45 South Wisconsin Street P.O. Box 322
Elkhorn, Wisconsin. 53121
Telephone: (262) 723-3434
Facsimile: (262) 723-8044

Scale in Feet
1" = 75'
0' 37.5' 75' 150' 225'

Survey date: September 17, 2004.
Revisions: No. 1 - Set Iron Rods
No. 2 - Corrections