LAND-MARK SURVEYING
Mark L. Miritz
Wisconsin Registered Land Surveyor S-2582

N9330 Knuteson Drive
Whitewater, WI 53190
Phone:(262)495-3284
FAX : (262) 495-8421
LAND-MARKSURVEYING.COM

45-109


PLAT OF SURVEY


LOT 18 OF BLOCK 3 OF GRAND VIEW SUBDIVISION

LOCATED IN THE SOUTHEAST 1/4 OF SECTION 34
TOWN 4 NORTH, RANGE 15 EAST, TOWN OF WHITEWATER,
WALWORTH COUNTY, WISCONSIN.

Ordered by: Schauder Building, Inc.
4115 North U.S. Highway 51
Janesville, Wi. 53545-9674

CLIENT REFERENCE: JO AND MARY JO GEORGEN
175 VISTA ROAD
LAKE ZURICH, IL. 60047

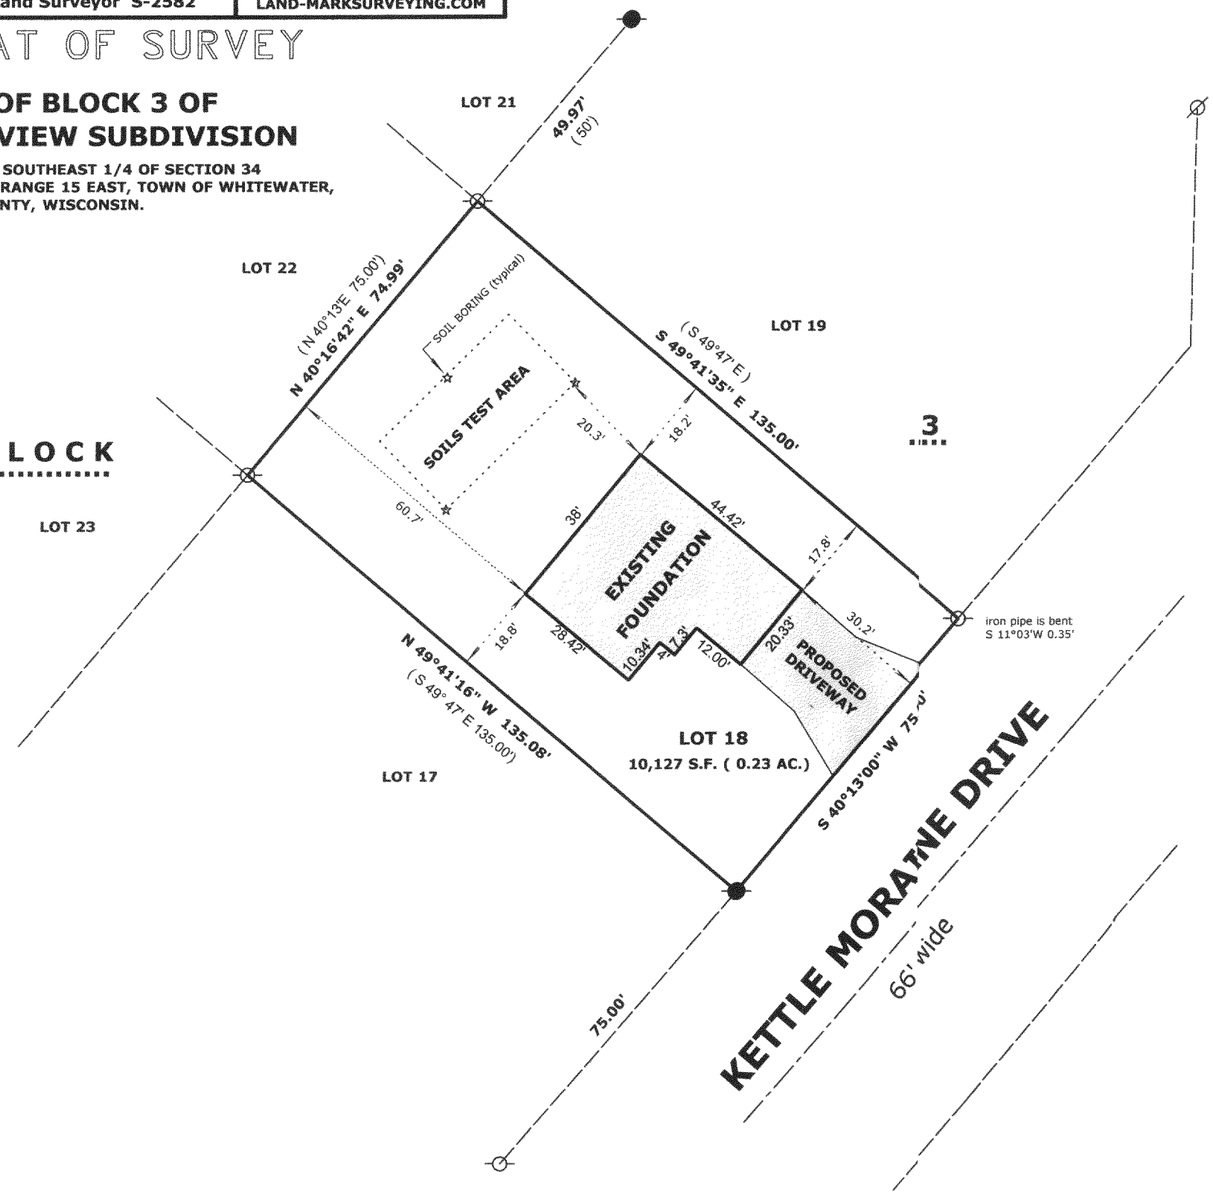

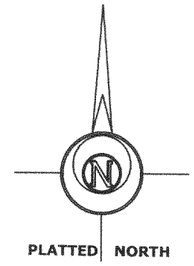

LEGEND

⌀	FOUND IRON PIPE
●	FOUND IRON ROD
⊠	FOUND COUNTY MONUMENT
□	WOOD STAKES AT 10' OFFSETS
+	CHISEL CUT IN CONCRETE
●	SET IRON ROD, 24" LONG, WEIGHING 1.5 LBS./LINEAL FT., 3/4" DIA.
(x x)	RECORDED AS DIMENSION
—x—x—	EXISTING FENCE

SCALE: 1" = 30 FEET

"I hereby certify that the above described property has been surveyed by me or under my direction and that the above map is a true representation thereof and shows the size and location of the property, its exterior boundaries, the location of all visible structures and dimensions of all principal buildings thereon, boundary fences, apparent easements, roadways and visible encroachments, if any." "This survey is made for the use of the present owners of the property, and also those who purchase, mortgage, or guarantee the title thereto within one year from date hereof."

Mark L. Miritz

MARK L. MIRITZ
WISCONSIN REGISTERED
LAND SURVEYOR S-2582

WISCONSIN
MARK L. MIRITZ
S-2582
WHITEWATER
WI
LAND SURVEYOR

REVISED MAY 12, 2005 TO SHOW FOUNDATION "AS BUILT"

DATE: March 12, 2005 JOB NO. 05.215

D&D 00336