LAND-MARK SURVEYING
Mark L. Miritz

Wisconsin Registered Land Surveyor S-2582

N9330 Knuteson Drive
Whitewater, WI 53190
Phone:(262)495-3284
FAX : (262) 495-8421
LAND-MARKSURVEYING.COM


PLAT OF SURVEY

LEGAL DESCRIPTION FOR LOT LINE ADJUSTMENT 1

A part of Lot 5 of Pine Knolls Subdivision, located in Town 4 North, Range 15 East, Town of Whitewater, Walworth County, Wisconsin, described as follows: Begin at a found iron rod which marks the Southwest corner of Lot 10 of said Subdivision; THENCE North 01°49'32" West a distance of 94.32 feet to a set iron rod; THENCE North 21°26'15" East a distance of 32.48 feet to a set iron rod in the east line of Lot 5; THENCE South 04°04'25" West along the east line of said Lot 5 a distance of 124.82 feet to a found iron rod which is the POINT OF BEGINNING, and containing 605 square feet or 0.014 acres of land, more or less.

LEGAL DESCRIPTION FOR LOT LINE ADJUSTMENT 2

A part of Lot 10 of Pine Knolls Subdivision, located in Town 4 North, Range 15 East, Town of Whitewater, Walworth County, Wisconsin, described as follows: Commence at a found iron rod which marks the Southwest corner of Lot 10 of said subdivision; THENCE North 04°04'25" East along the west line of said Lot 10 a distance of 124.82 feet to a set iron rod which is the POINT OF BEGINNING; THENCE continue North 4°04'25" East along said west line of said Lot 10, 55.35 feet to a found iron rod which marks the Northeast corner of Lot 5; THENCE North 6°17'20" East along the west line of said Lot 10, 66.24 feet to a found iron rod which marks the Northwest corner of said Lot 10; THENCE South 00°13'32" East 91.64 feet to a set iron rod; THENCE South 21°26'15" West a distance of 31.60 feet to the POINT OF BEGINNING and containing 605 square feet or 0.014 acres of land, more or less.

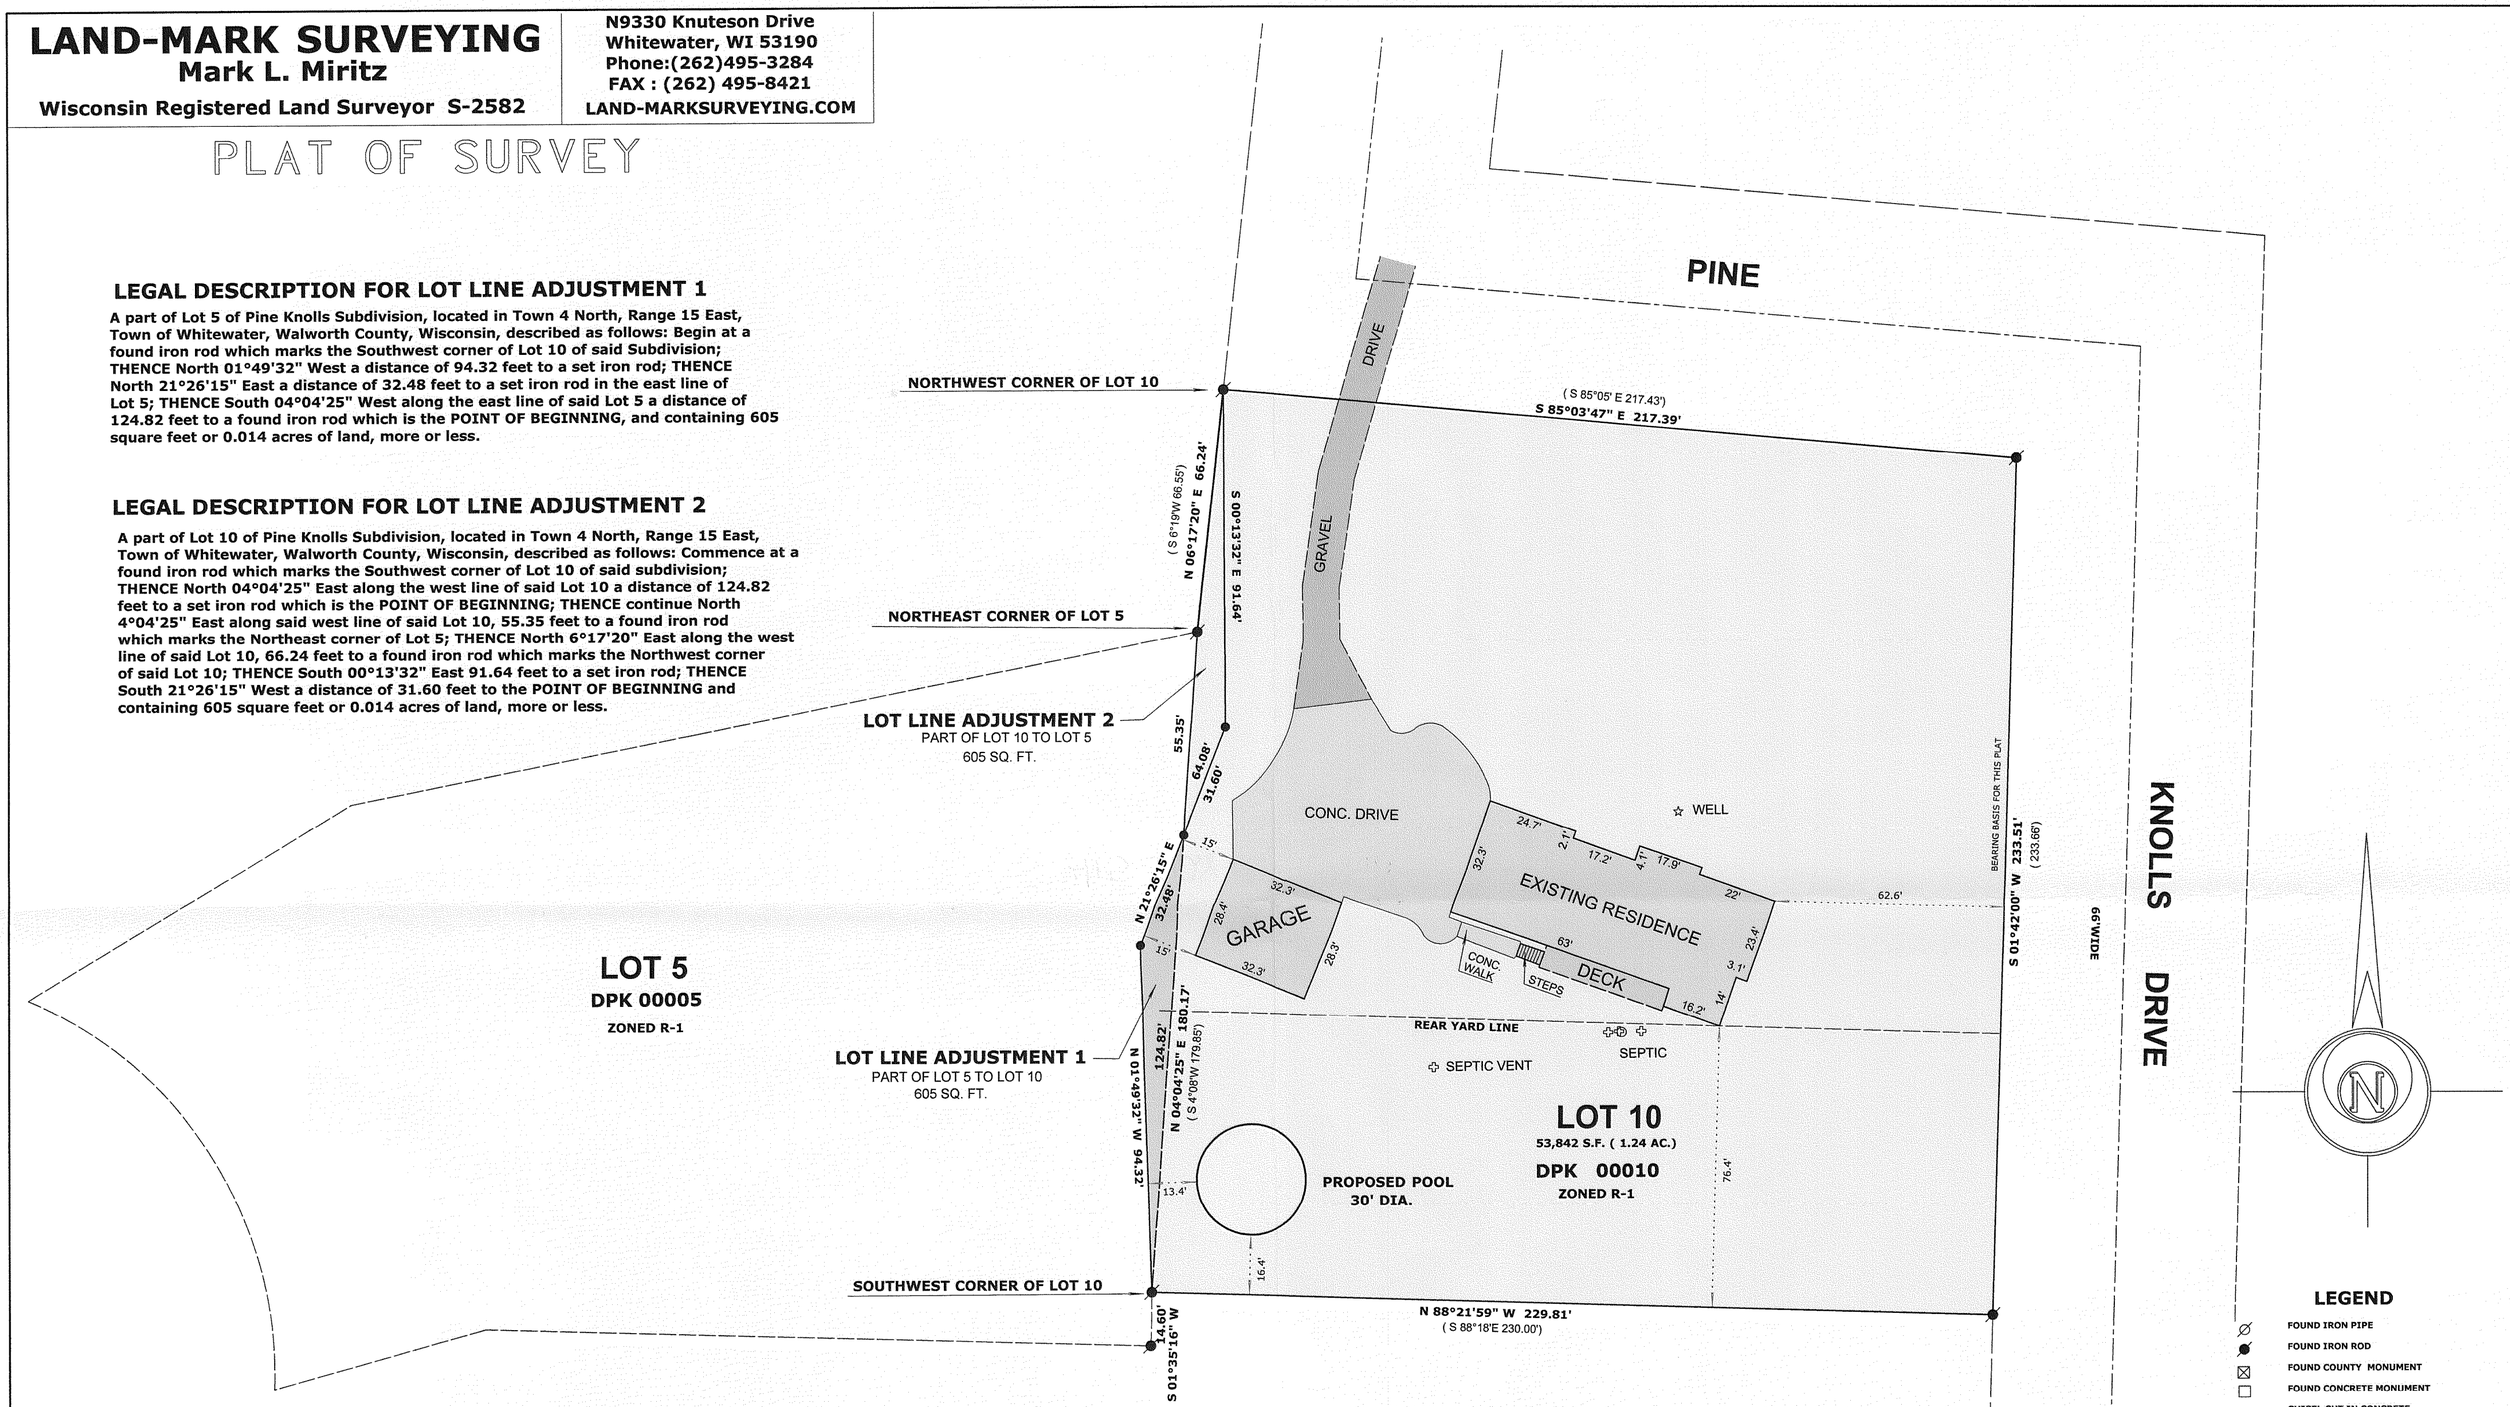

"THIS LOT LINE ADJUSTMENT BETWEEN ADJOINING LAND OWNERS DOES NOT CREATE ADDITIONAL LOTS AND THE ORIGINAL PARCELS ARE NOT REDUCED BELOW THE MINIMUM SIZE REQUIRED BY THE WALWORTH COUNTY CODE OF ORDINANCES (ZONING/SHORELAND ZONING)."

OWNERS: JERRY R. MILLIAN
CYNTHIA J. MILLIAN
N7683 PINE KNOLLS DRIVE
WHITEWATER, WI. 53190

RECEIVED
AUG 27 2007

WISCONSIN
MARK L. MIRITZ
S-2582
WHITEWATER, WI
LAND SURVEYOR

LEGEND

- FOUND IRON PIPE
- FOUND IRON ROD
- FOUND COUNTY MONUMENT
- FOUND CONCRETE MONUMENT
- CHISEL CUT IN CONCRETE
- SET IRON ROD, 24" LONG, WEIGHING 1.5 LBS./LINEAL FT., 3/4" DIA.
- (x x) RECORDED AS DIMENSION
- EXISTING FENCE

SCALE: 1" = 30 FEET

"I hereby certify that the above described property has been surveyed by me or under my direction and that the above map is a true representation thereof and shows the size and location of the property, its exterior boundaries, the location of all visible structures and dimensions of all principal buildings thereon, boundary fences, apparent easements, roadways and visible encroachments, if any."
"This survey is made for the use of the present owners of the property, and also those who purchase, mortgage, or guarantee the title thereto within one year from date hereof."

Mark L. Miritz

MARK L. MIRITZ
WISCONSIN REGISTERED
LAND SURVEYOR S-2582

DATE: JUNE 20, 2007 JOB NO. 07.601

DPK-10

415-1128