
ABELL
SURVEYING & MAPPING
1140 SEQUOIA STREET · DELAVAN, WISCONSIN 53115
262-728-6737

TAX PARCEL DW-35-49

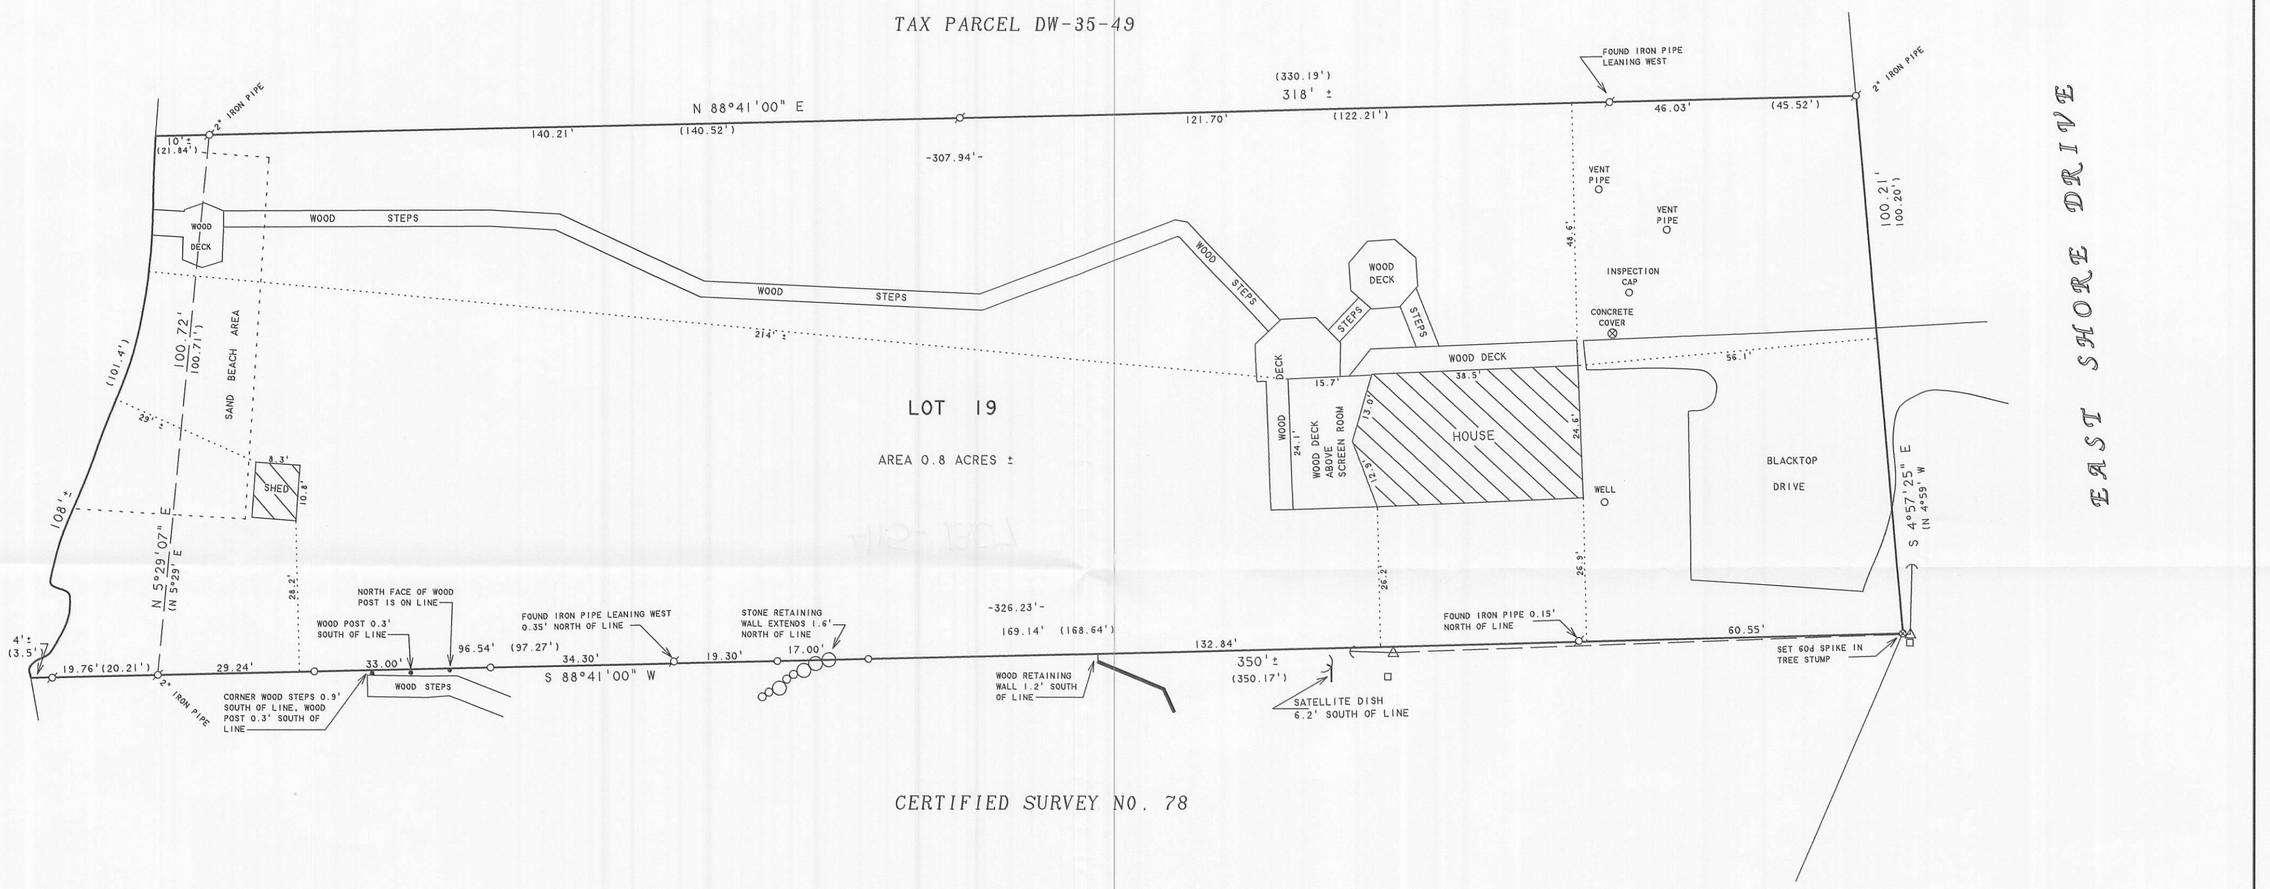

CERTIFIED SURVEY NO. 78

PLAT OF SURVEY OF

LOT 19 OF THORNE HEIGHTS, LOCATED IN THE SOUTHEAST 1/4 AND IN THE SOUTHWEST 1/4 OF SECTION 35, T4N,R15E, WALWORTH COUNTY, WISCONSIN.

NOTE: BEARINGS ARE REFERENCED TO THE RECORDED SUBDIVISION PLAT.

N

SCALE 1"=20'

LEGEND

- Ø -IRON PIPE FOUND
- O -IRON PIPE SET
- ⊗ -60d SPIKE SET IN TREE STUMP
- △ -UTILITY POLE
- —— —— -OVERHEAD UTILITY LINES
- —→ -GUY WIRE
- □ -UTILITY PED
- ( ) -RECORDED AS

RECEIVED
MAY 13 2010
By

REVISED: APRIL 6, 2010 TO SHOW THE WOOD WALK AND WOOD POSTS HAVE BEEN MOVED AND TO SHOW THE ADDITIONAL IRON PIPES THAT WERE SET ALONG THE SOUTH LINE.

ORDERED BY: ANDY SZYMANKYJ
KEEFE REAL ESTATE
1040 N. WISCONSIN ST.
ELKHORN, WI 53121

I HEREBY CERTIFY THAT I HAVE SURVEYED THE ABOVE DESCRIBED PROPERTY AND THAT THE ABOVE MAP IS A TRUE REPRESENTATION THEREOF AND SHOWS THE SIZE AND LOCATION OF THE PROPERTY, ITS EXTERIOR BOUNDARIES, THE LOCATION OF ALL VISIBLE STRUCTURES AND DIMENSIONS OF ALL PRINCIPAL BUILDINGS THEREON, BOUNDARY FENCES, APPARENT EASEMENTS, ROADWAYS AND VISIBLE ENCROACHMENTS, IF ANY, TO THE BEST OF MY KNOWLEDGE AND BELIEF.

THIS SURVEY IS MADE FOR THE USE OF THE PRESENT OWNERS OF THE PROPERTY, AND ALSO THOSE WHO PURCHASE, MORTGAGE, OR GUARANTEE THE TITLE THERETO WITHIN ONE (1) YEAR FROM DATE HEREON.

David F. Abell

DAVID F. ABELL
WISCONSIN REGISTERED LAND SURVEYOR, S-1596

March 22, 2010

DATE JOB NUMBER - 10006A
NOTE: THIS IS NOT A CERTIFIED COPY UNLESS SEALED.

DTH-19

415-1207