ABELL
SURVEYING & MAPPING
1140 SEQUOIA STREET · DELAVAN, WISCONSIN 53115
262-728-6737


RECEIVED
FEB 10 2011
By

BEARINGS ARE REFERENCED TO THE RECORDED SUBDIVISION PLAT.

N

SCALE 1"=20'

LEGEND
- -IRON PIPE FOUND
- -IRON ROD FOUND
- -UTILITY POLE
( )-RECORDED AS

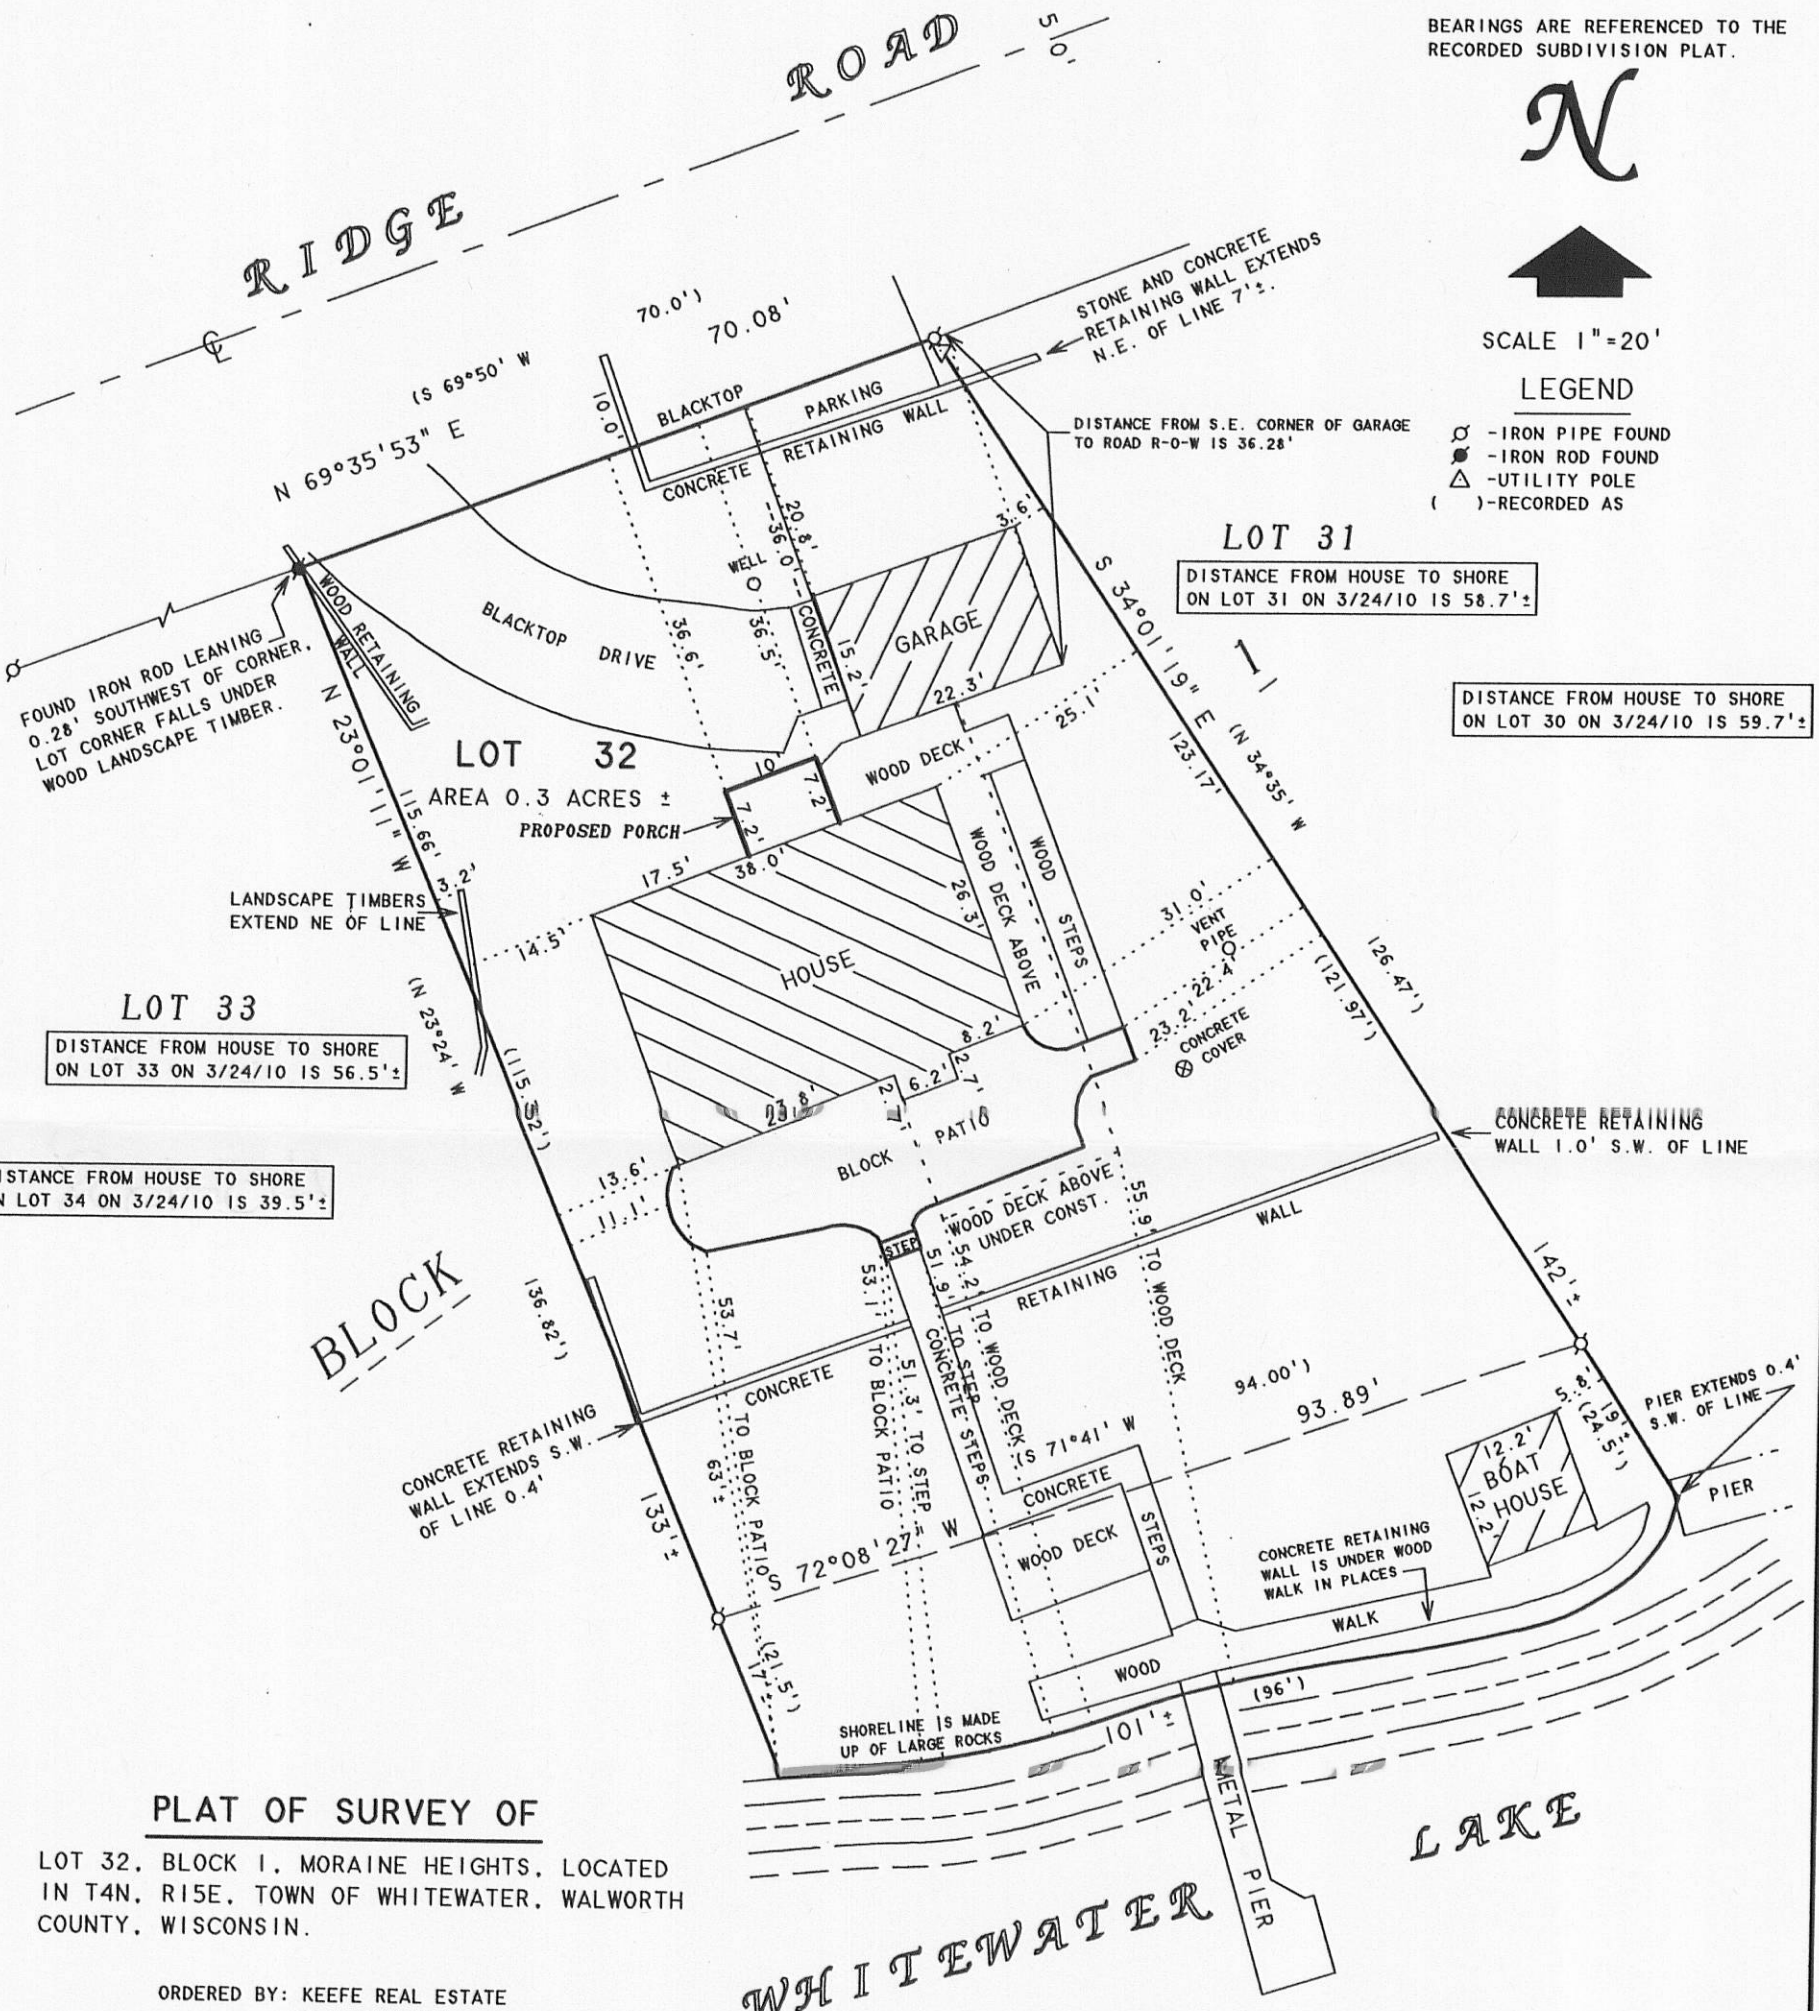

PLAT OF SURVEY OF

LOT 32, BLOCK 1, MORAINE HEIGHTS, LOCATED IN T4N, R15E, TOWN OF WHITEWATER, WALWORTH COUNTY, WISCONSIN.

ORDERED BY: KEEFE REAL ESTATE
P.O. BOX 460
LAKE GENEVA, WI 53147

REVISED: MARCH 24, 2010 TO SHOW DISTANCES FROM THE DECKS ON LOT 32 TO THE SHORE. TO SHOW DISTANCES FROM THE HOUSES ON LOTS 30,31,33 AND 34 TO THE SHORE FROM THE CLOSEST CORNER OF THE HOUSES.

REVISED: JUNE 1, 2010 TO SHOW WOOD DECK TO BE REMOVED, 1.0' TO BE REMOVED FROM WOOD DECK ABOVE AND LOCATION OF PROPOSED CONCRETE PATIO.

REVISED: JUNE 28, 2010 TO SHOW AS-BUILT ON BLOCK PATIO AND WOOD DECK UNDER CONSTRUCTION.

REVISED: JANUARY 3, 2011 TO SHOW PROPOSED PORCH.

ORDERED BY: CAL WEBER
C. WEBER BUILDERS
W7990 COUNTY ROAD A
DELAVAN, WI 53115

OWNER : JEFFREY BELLINGER

I HEREBY CERTIFY THAT I HAVE SURVEYED THE ABOVE DESCRIBED PROPERTY AND THAT THE ABOVE MAP IS A TRUE REPRESENTATION THEREOF AND SHOWS THE SIZE AND LOCATION OF THE PROPERTY, ITS EXTERIOR BOUNDARIES, THE LOCATION OF ALL VISIBLE STRUCTURES AND DIMENSIONS OF ALL PRINCIPAL BUILDINGS THEREON, BOUNDARY FENCES, APPARENT EASEMENTS, ROADWAYS AND VISIBLE ENCROACHMENTS, IF ANY, TO THE BEST OF MY KNOWLEDGE AND BELIEF.

THIS SURVEY IS MADE FOR THE USE OF THE PRESENT OWNERS OF THE PROPERTY, AND ALSO THOSE WHO PURCHASE, MORTGAGE, OR GUARANTEE THE TITLE THERETO WITHIN ONE (1) YEAR FROM DATE HEREON.

David F. Abell

DAVID F. ABELL
WISCONSIN REGISTERED LAND SURVEYOR, S-1596

June 8, 2009.

DATE

JOB NUMBER - 94134E

NOTE: THIS IS NOT A CERTIFIED COPY UNLESS SEALED.