

Plat of Survey

of
Lot 5 in Block 1 of Chapel Hills Subdivision,


located in the Southeast 1/4 of Section 34, Town 4 North, Range
15 East, Town of Whitewater, Walworth County, Wisconsin.

Surveyed for: **Timothy & Deborah Young**


17464 Johnson Street
Union, Illinois. 60180

Whitewater
Lake

Water Elevation on
February 20, 2012.
872.4

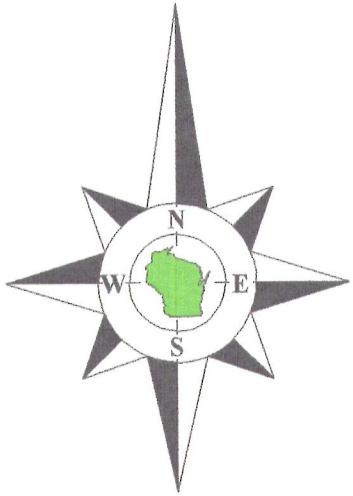



Bearings reference to the plat
of Chapel Hills Subdivision.

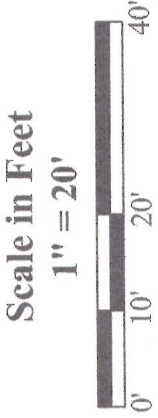

Shoreyard Setback Average

Lot 3	±33.4'
Lot 4	±48.7'
Lot 6	±45.1'
Lot 7	±62.0'
Average	47.3'

Note:
Exact location of
shoreline beneath
wood dock can not
be determined.

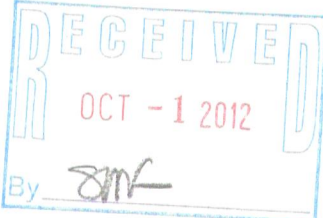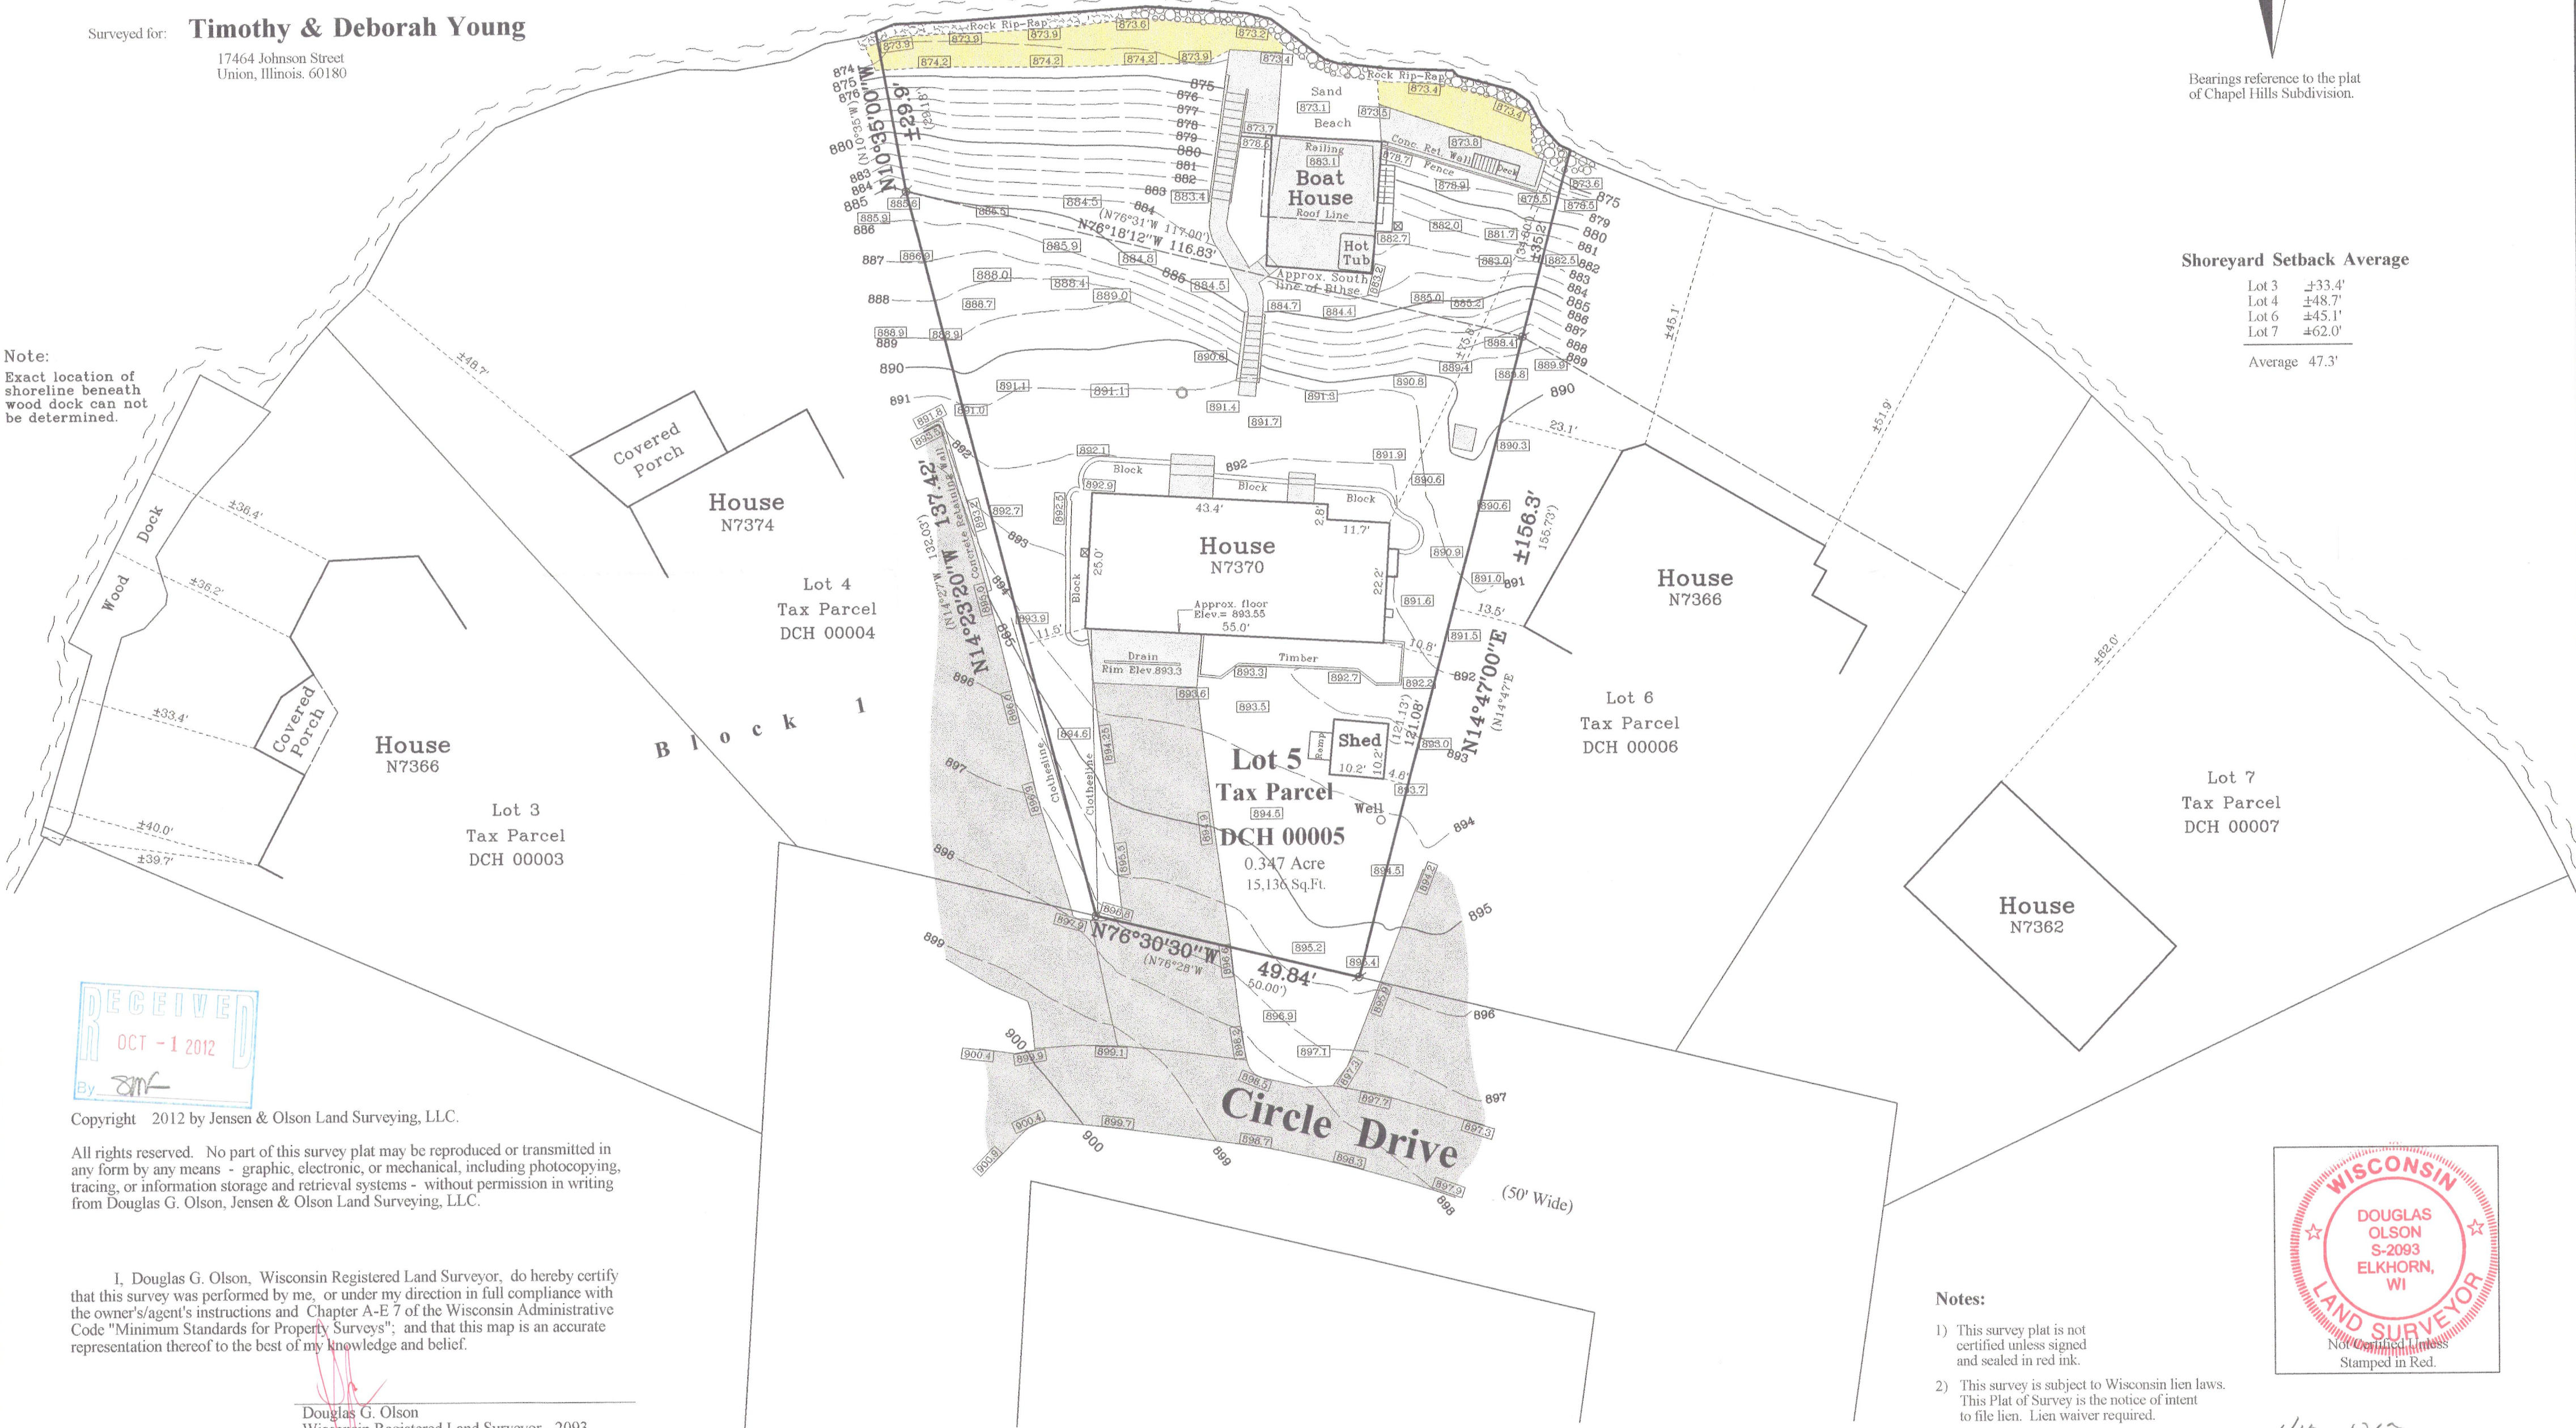

Copyright 2012 by Jensen & Olson Land Surveying, LLC.

All rights reserved. No part of this survey plat may be reproduced or transmitted in any form by any means - graphic, electronic, or mechanical, including photocopying, tracing, or information storage and retrieval systems - without permission in writing from Douglas G. Olson, Jensen & Olson Land Surveying, LLC.

I, Douglas G. Olson, Wisconsin Registered Land Surveyor, do hereby certify that this survey was performed by me, or under my direction in full compliance with the owner's/agent's instructions and Chapter A-E 7 of the Wisconsin Administrative Code "Minimum Standards for Property Surveys"; and that this map is an accurate representation thereof to the best of my knowledge and belief.

Douglas G. Olson
Wisconsin Registered Land Surveyor - 2093

Notes:

- 1) This survey plat is not certified unless signed and sealed in red ink.
- 2) This survey is subject to Wisconsin lien laws. This Plat of Survey is the notice of intent to file lien. Lien waiver required.



Jensen & Olson Land Surveying, LLC

45 South Wisconsin Street * P.O. Box 322 * Elkhorn, Wisconsin. 53121
Telephone: (262) 723-3434 * Facsimile: (262) 723-8044

Email: jensen.olson@elknet.net

- Legend
- ☒ Found Iron Pipe
 - ☒ Recorded Information
 - ☒ Concrete Cover
 - ☒ Electric Box or Meter
 - ☒ Asphalt Surface
 - ☒ Concrete Surface
 - ☒ Stone

Sheet 1 of 1 Sheets

Job Reference Number

2012.003

2012.003

Survey Date: February 20, 2012.

Revisions:

415-1067