
LAND-MARK SURVEYING
Mark L. Miritz
Wisconsin Registered Land Surveyor S-2582

N9330 Knuteson Drive
Whitewater, WI 53190
Phone:(262)495-3284
FAX : (262) 495-8421
LAND-MARKSURVEYING.COM

PLAT OF SURVEY

LOT 1 OF CERTIFIED SURVEY MAP NO. 629, LOCATED IN THE NORTHWEST 1/4 OF SECTION 29, TOWN 4 NORTH, RANGE 15 EAST, WHITEWATER TOWNSHIP, WALWORTH COUNTY, WISCONSIN.

OWNER: ADRIENNE D. WRIGHT
N8073 STATE ROAD 89
WHITEWATER, WI 53190

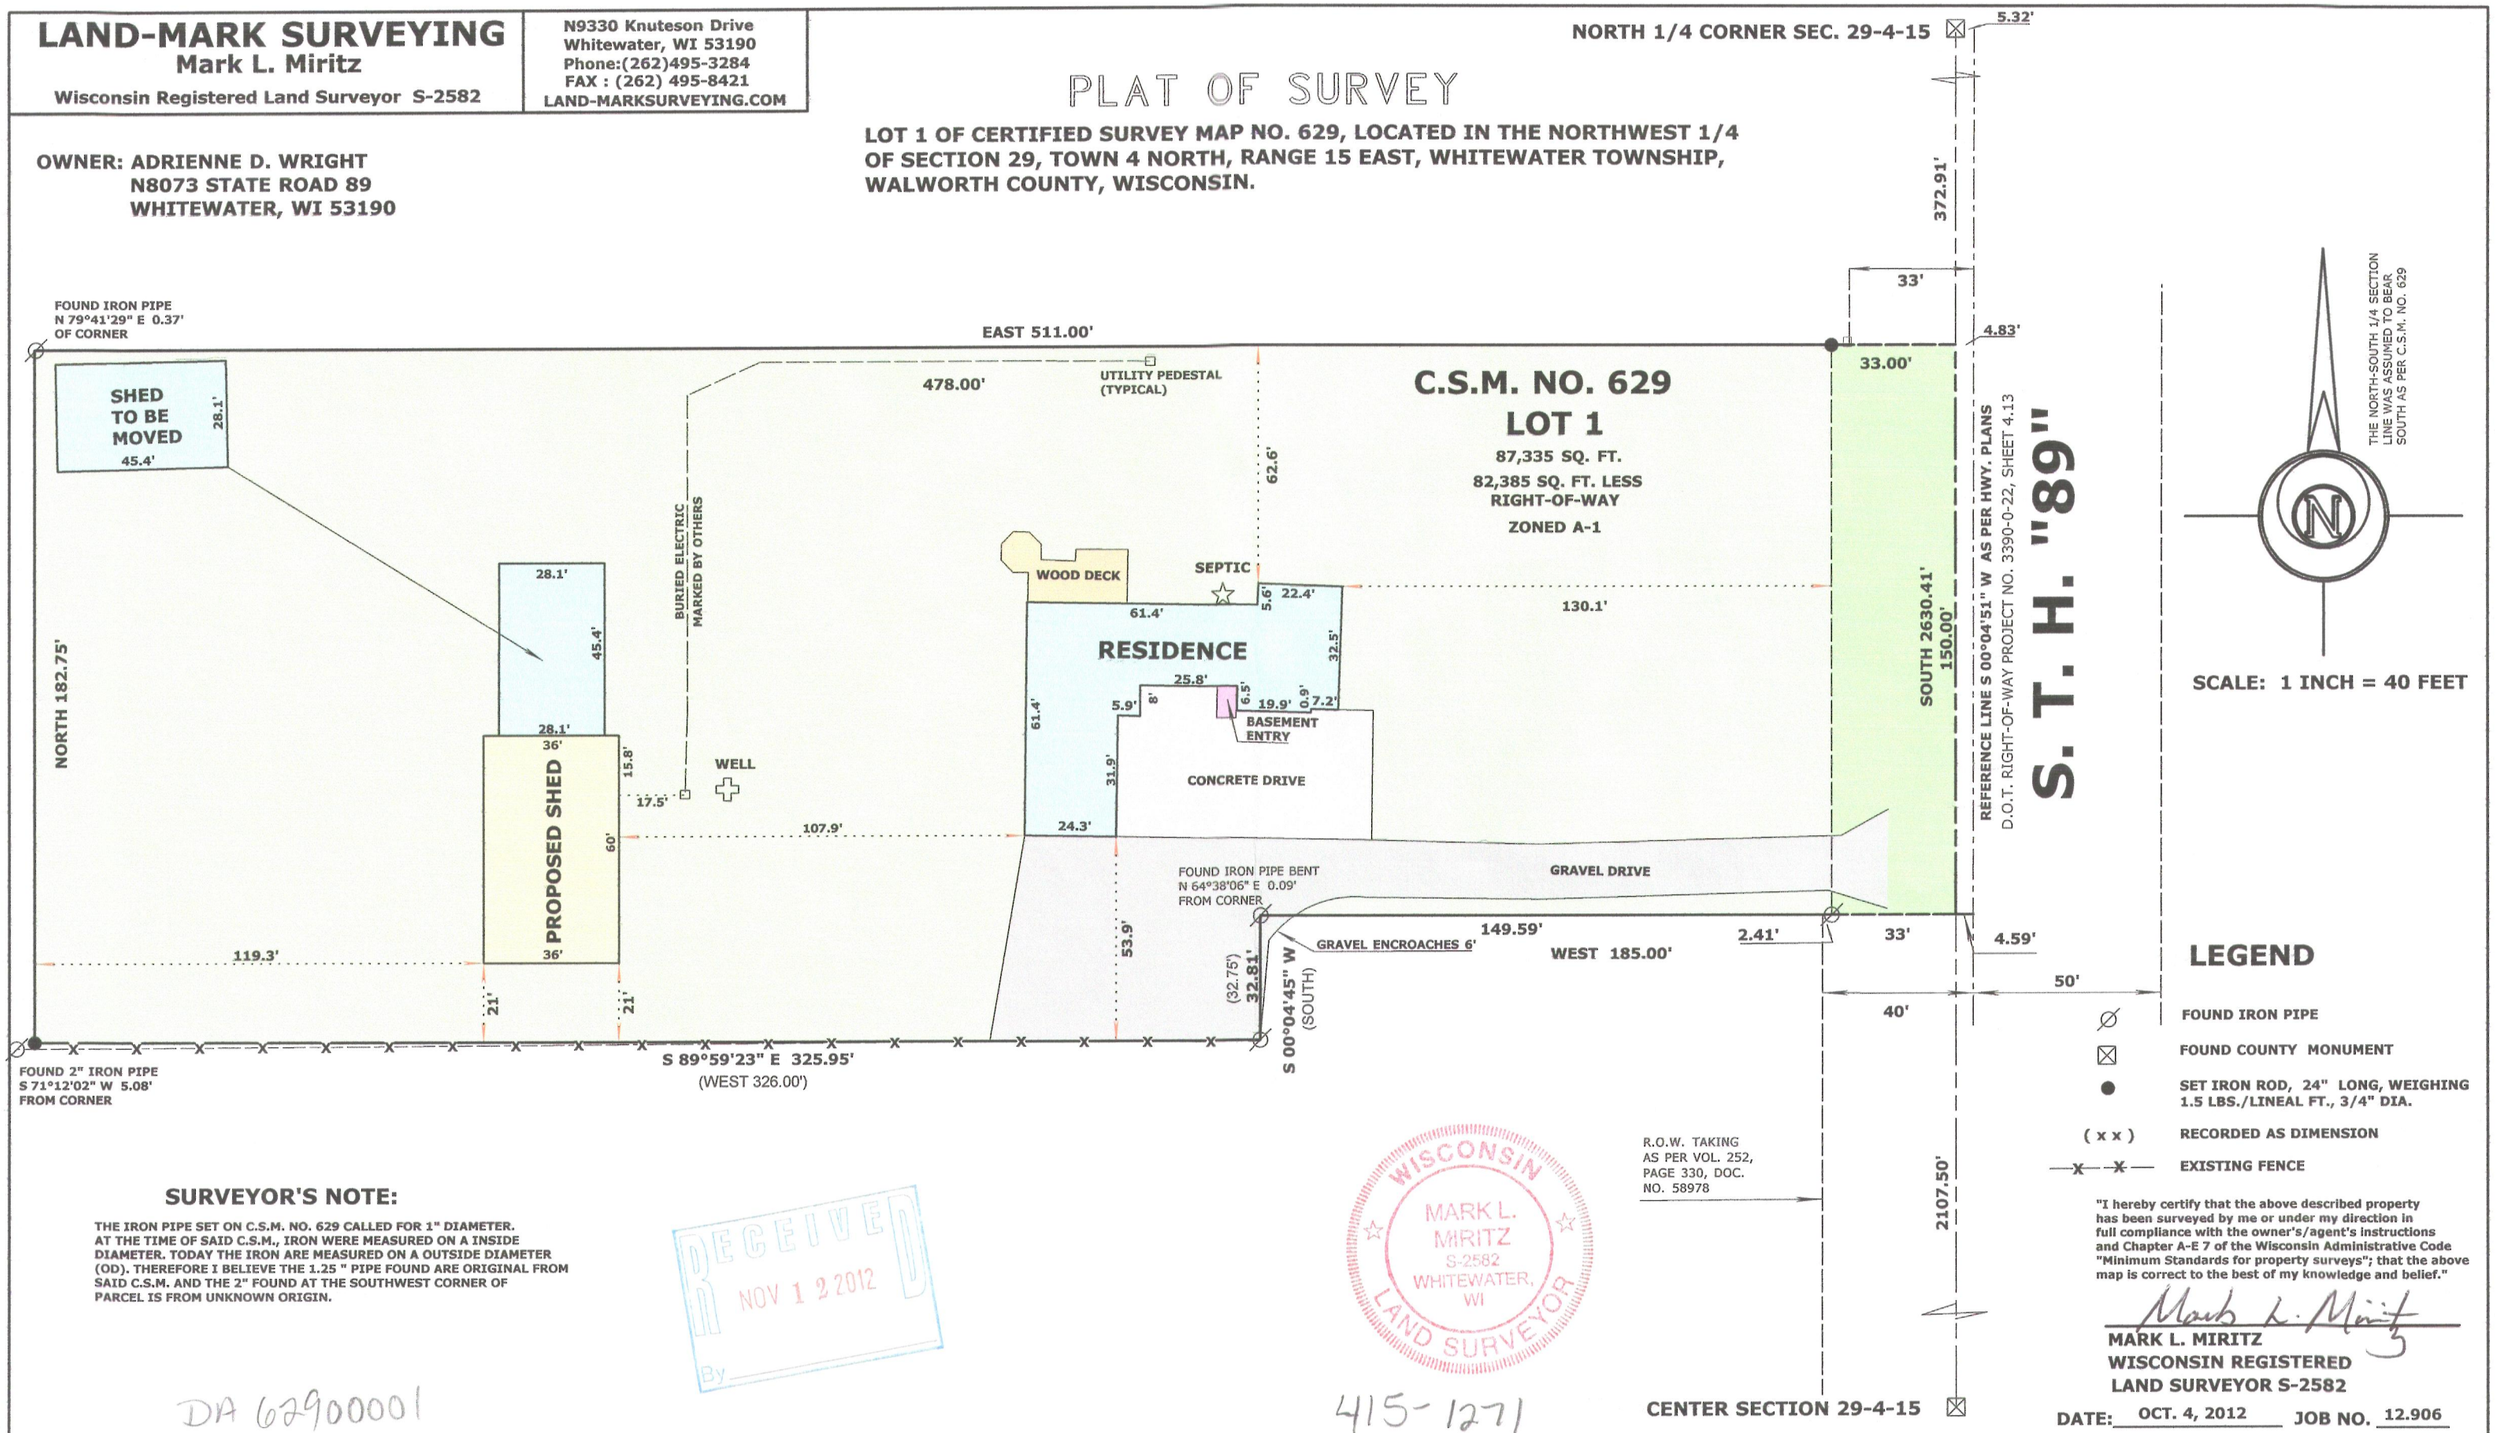

LEGEND

- FOUND IRON PIPE
- FOUND COUNTY MONUMENT
- SET IRON ROD, 24" LONG, WEIGHING 1.5 LBS./LINEAL FT., 3/4" DIA.
- (x x) RECORDED AS DIMENSION
- —x—x— EXISTING FENCE

SURVEYOR'S NOTE:

THE IRON PIPE SET ON C.S.M. NO. 629 CALLED FOR 1" DIAMETER. AT THE TIME OF SAID C.S.M., IRON WERE MEASURED ON A INSIDE DIAMETER. TODAY THE IRON ARE MEASURED ON A OUTSIDE DIAMETER (OD). THEREFORE I BELIEVE THE 1.25 " PIPE FOUND ARE ORIGINAL FROM SAID C.S.M. AND THE 2" FOUND AT THE SOUTHWEST CORNER OF PARCEL IS FROM UNKNOWN ORIGIN.

RECEIVED
NOV 1 2 2012
By

WISCONSIN
MARK L. MIRITZ
S-2582
WHITEWATER, WI
LAND SURVEYOR

"I hereby certify that the above described property has been surveyed by me or under my direction in full compliance with the owner's/agent's instructions and Chapter A-E 7 of the Wisconsin Administrative Code "Minimum Standards for property surveys"; that the above map is correct to the best of my knowledge and belief."

Mark L. Miritz

MARK L. MIRITZ
WISCONSIN REGISTERED
LAND SURVEYOR S-2582

DATE: OCT. 4, 2012 JOB NO. 12.906

DA 62900001

415-1271