LAND-MARK SURVEYING
Mark L. Miritz
Wisconsin Registered Land Surveyor S-2582

N9330 Knuteson Drive
Whitewater, WI 53190
Phone:(262)495-3284
MARKMIRITZ@
LAND-MARKSURVEYING.COM


SITE PLAN

Lot 3 of Certified Survey Map No. 702, being a part of the SE 1/4 of Section 34, T4N, R15E, Walworth County, Wisconsin, recorded in Volume 3 of Certified Surveys at Page 205 as Document No. 21674. EXCEPTING THEREFROM those portions of said Lot 3 more particularly described as follows, to-wit; Commencing at the NE corner of Lot 4 of Certified Survey Map No. 702; thence South 0° 23' West along the Easterly line of said Lot 4, 68.17 feet to the point of beginning; thence continue South 0° 23' West along said Easterly line 7.23 feet; thence South 33°11' East along said Easterly 1ine 108.80 feet to a meander point which is North 33° 11' West 6.5 feet, more or less, from Whitewater Lake; thence North 50° 40' East along a meander line 4.02 feet to a meander point, which is North 33° 11' W. 7 feet ,more or less, from said Whitewater Lake; Thence North 33°11' West 114.39 feet to the point of beginning, containing 500 square feet more or less which includes all lands between the above described meander line, the courses N 33°11' West 6.5 feet more or less, North 33°11' West 7 feet, more or less, and Whitewater Lake.
ALSO included in this conveyance is a part of Lot 4 of Certified Survey Map No. 702 described as follows: Beginning at the NE corner of said Lot 4; thence N 89° 37' W along the North line of said Lot 4, 51. 70 feet; Thence S 73°26'15" E., 53.83 feet to the easterly line of said Lot 4; thence N 0° 23' E. along said easterly line, 15.00 feet to the point of beginning, containing 388 square feet.

ORDERED BY: COUNTRY BUILDERS, INC.
DAVID R. WILLIAMS
220 N. JEFFERSON ST.
WHITEWATER, WI 53190

OWNER: WHITEWATER LAKE COOPERATIVE
615 FAIRFIELD DR.
BARRINGTON, IL 60010

SITE ADDRESS: N7468 KETTLE MORAINE DRIVE

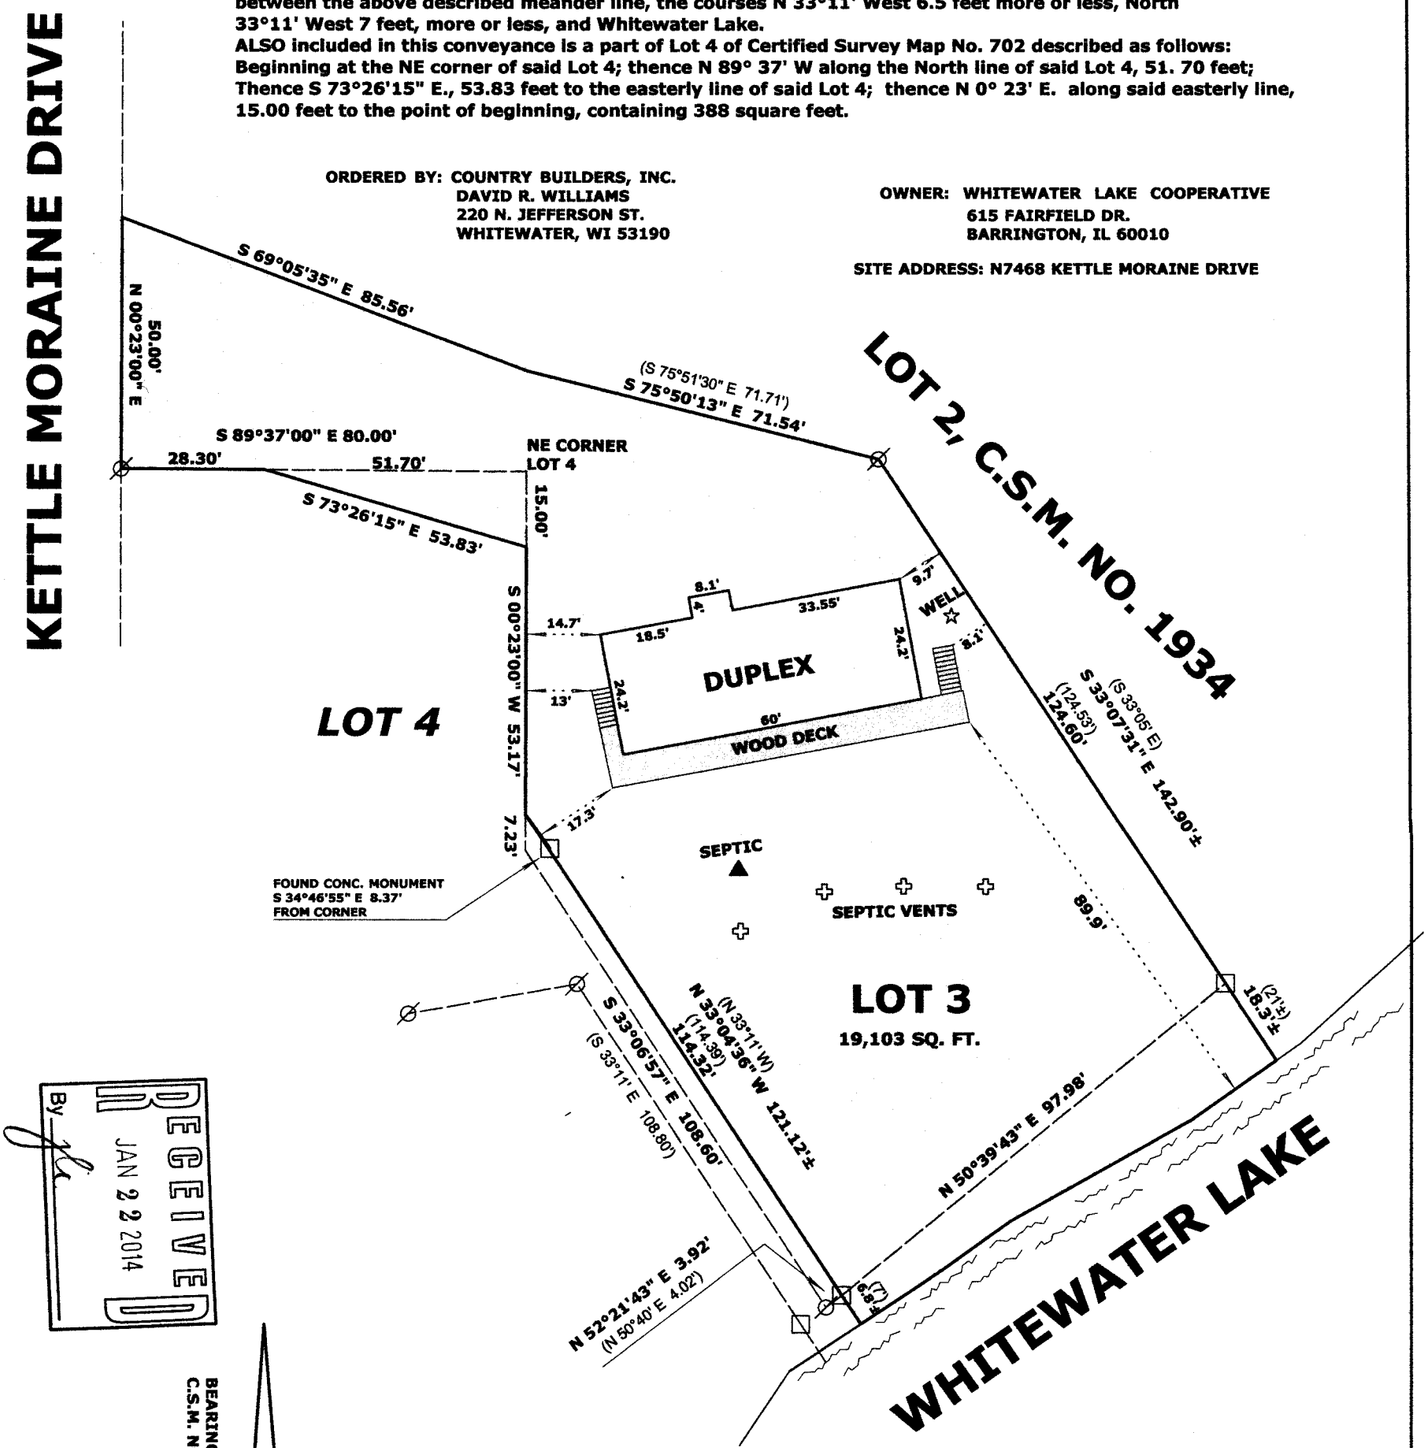

RECEIVED
JAN 22 2014
By

BEARINGS REFERENCE C.S.M. NO. 702

N

LEGEND

⌀	FOUND IRON PIPE
□	FOUND CONCRETE MONUMENT
(x x)	RECORDED AS DIMENSION

SCALE: 1 INCH = 30 FEET

"I hereby certify that the above described property has been surveyed by me or under my direction and that the above map is correct to the best of my knowledge and belief."

WISCONSIN
MARK L. MIRITZ
S-2582
WHITEWATER, WI
LAND SURVEYOR

Mark L. Miritz

MARK L. MIRITZ
WISCONSIN REGISTERED
LAND SURVEYOR S-2582

DATE: DEC. 31, 2013 **JOB NO.** 13.1210

dA 702-3 415-1307