
PLAT OF SURVEY

LOT 1 CERTIFIED SURVEY MAP 4501
REC AS DOC. 876441

LOCATED IN THE MSE 1/4 OF THE NW 1/4 AND
THE SW 1/4 OF THE NE 1/4 SECTION 32
TOWN 4 NORTH, RANGE 15 EAST
WALWORTH COUNTY, WISCONSIN

RECEIVED
SEP 5 2014
By jan

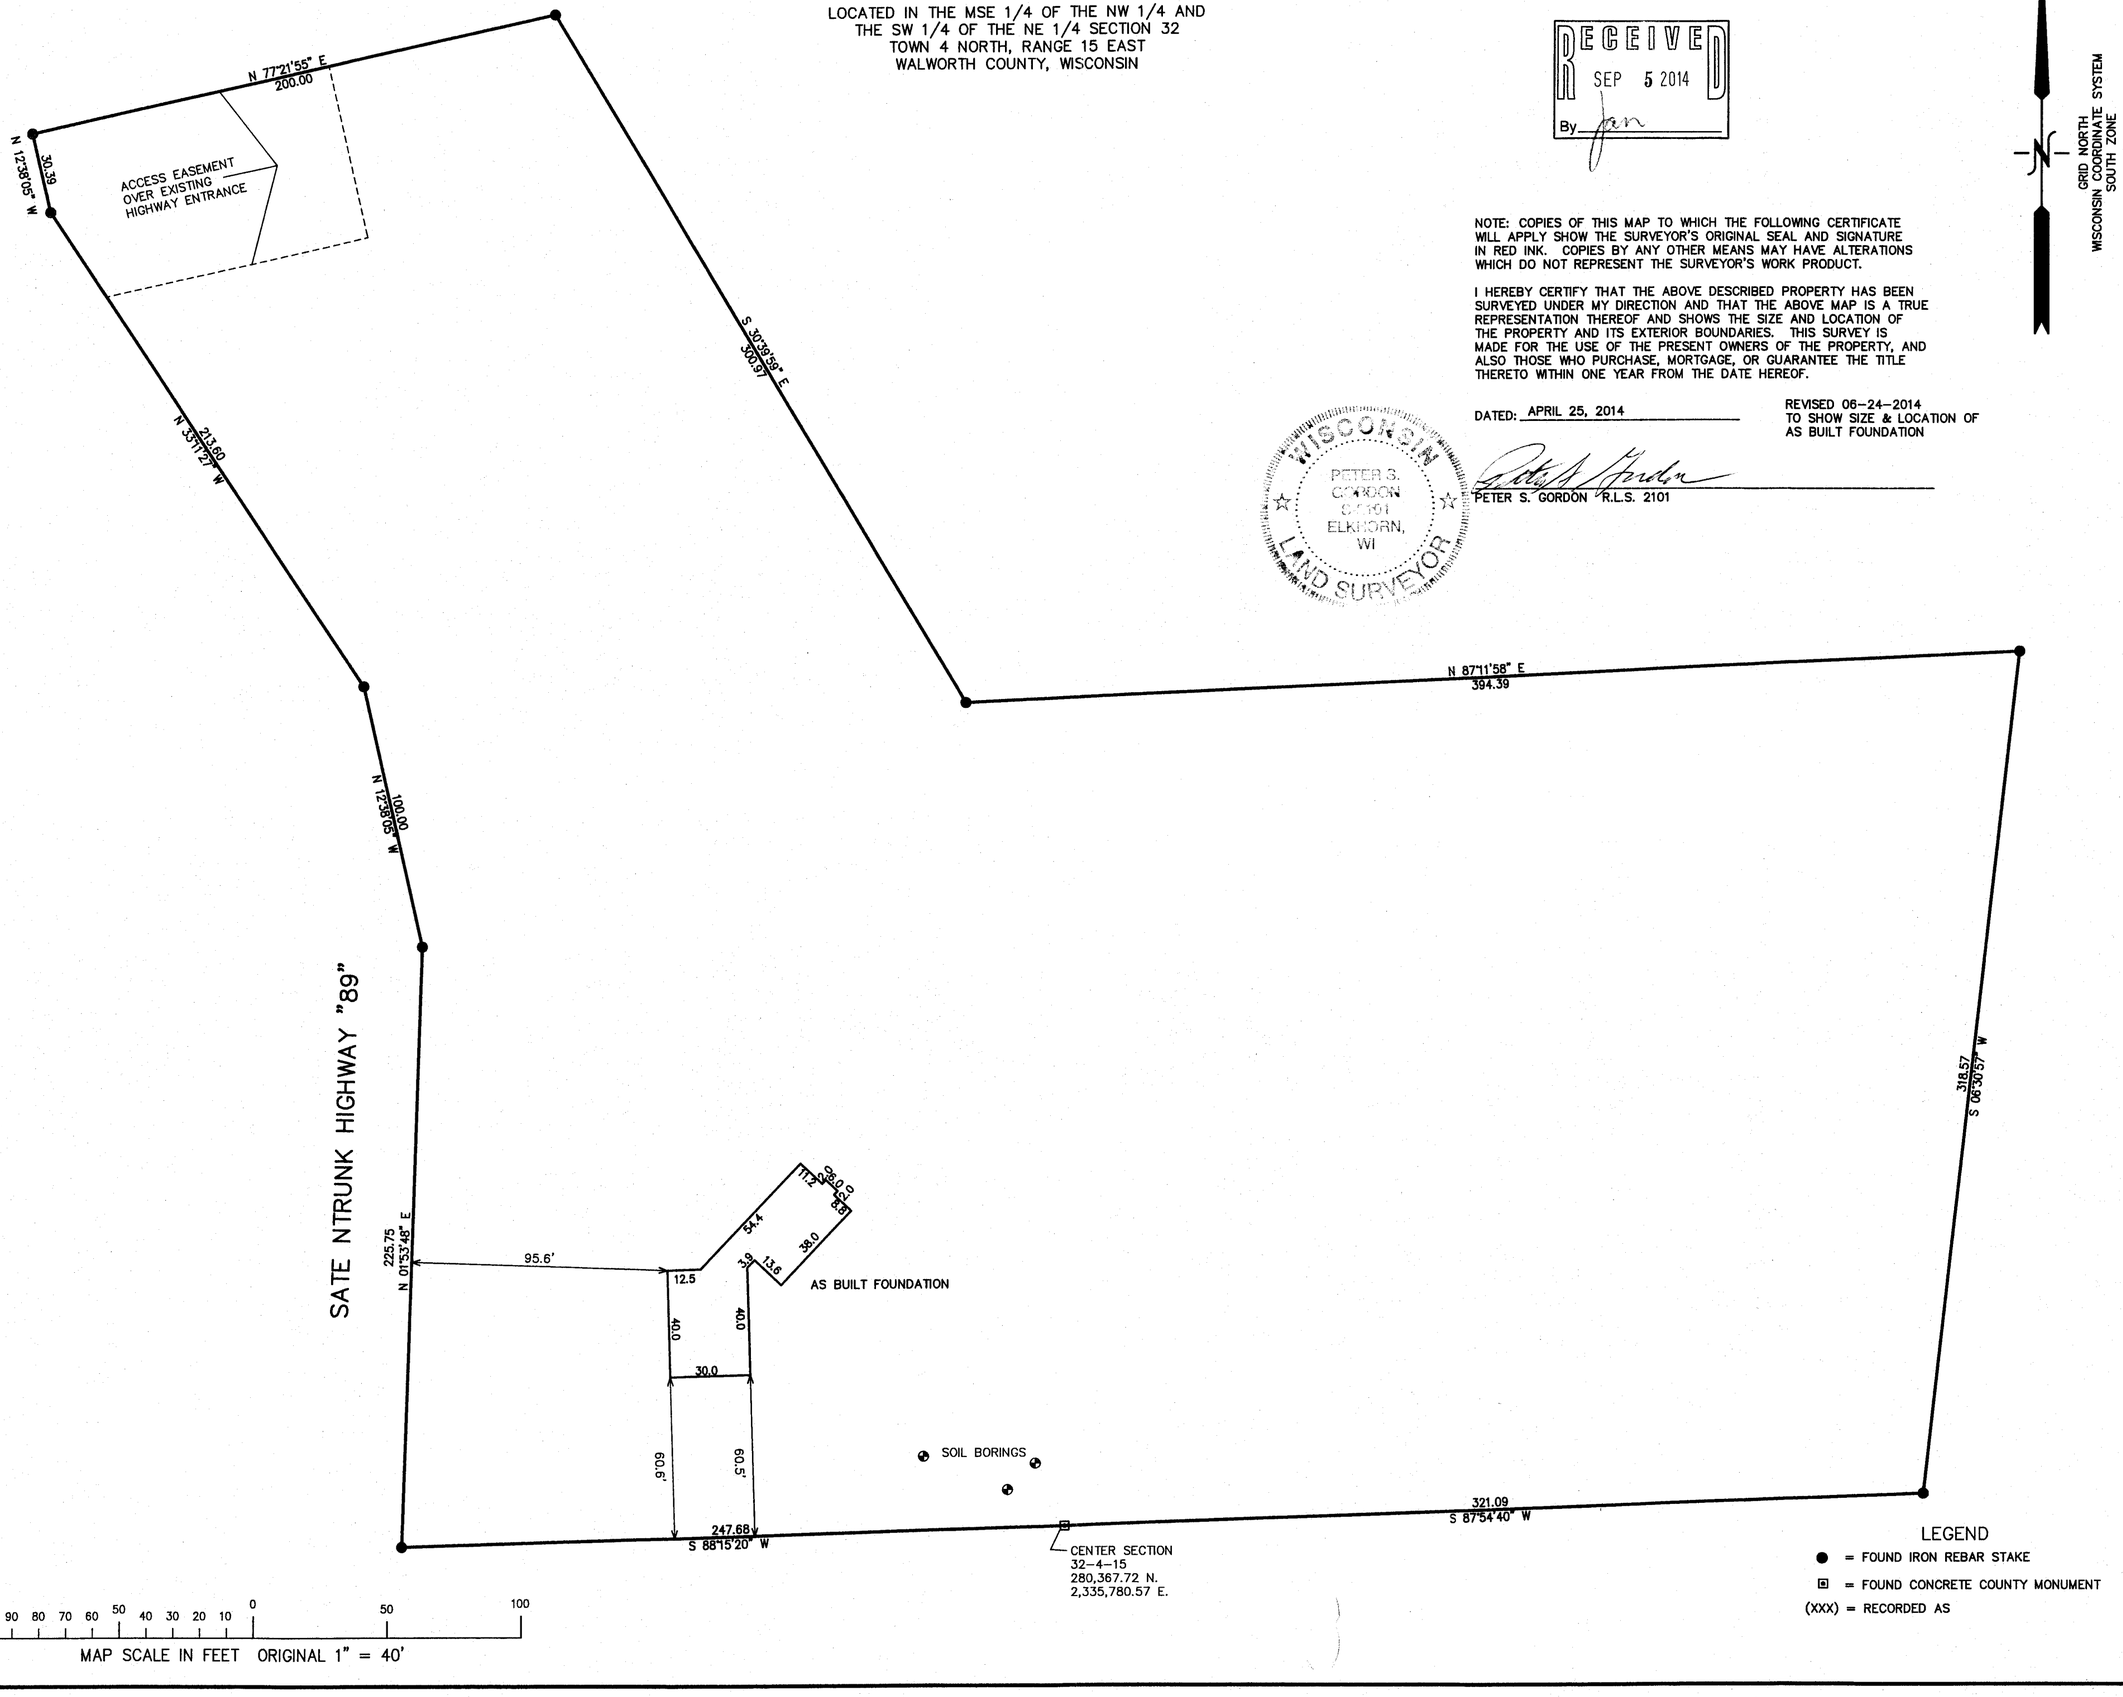

NOTE: COPIES OF THIS MAP TO WHICH THE FOLLOWING CERTIFICATE WILL APPLY SHOW THE SURVEYOR'S ORIGINAL SEAL AND SIGNATURE IN RED INK. COPIES BY ANY OTHER MEANS MAY HAVE ALTERATIONS WHICH DO NOT REPRESENT THE SURVEYOR'S WORK PRODUCT.

I HEREBY CERTIFY THAT THE ABOVE DESCRIBED PROPERTY HAS BEEN SURVEYED UNDER MY DIRECTION AND THAT THE ABOVE MAP IS A TRUE REPRESENTATION THEREOF AND SHOWS THE SIZE AND LOCATION OF THE PROPERTY AND ITS EXTERIOR BOUNDARIES. THIS SURVEY IS MADE FOR THE USE OF THE PRESENT OWNERS OF THE PROPERTY, AND ALSO THOSE WHO PURCHASE, MORTGAGE, OR GUARANTEE THE TITLE THERETO WITHIN ONE YEAR FROM THE DATE HEREOF.

DATED: APRIL 25, 2014

REVISED 06-24-2014
TO SHOW SIZE & LOCATION OF
AS BUILT FOUNDATION

WISCONSIN
PETER S. GORDON
S-2101
ELKHORN, WI
LAND SURVEYOR

PETER S. GORDON R.L.S. 2101

GRID NORTH
WISCONSIN COORDINATE SYSTEM
SOUTH ZONE

LEGEND
● = FOUND IRON REBAR STAKE
⊡ = FOUND CONCRETE COUNTY MONUMENT
(XXX) = RECORDED AS

WORK ORDERED BY:
JAMES FRODL
N7665 STATE ROAD 89
WHITEWATER, WI. 53190

FARRIS, HANSEN & ASSOCIATES, INC.
ENGINEERING – ARCHITECTURE – SURVEYING
7 RIDGWAY COURT P.O. BOX 437
ELKHORN, WISCONSIN 53121
OFFICE: (262) 723-2098 FAX: (262) 723-5886

REVISIONS

PROJECT NO.
8766

DATE:
04-25-2014

SHEET NO.
1 OF 1

JUN 24 2014

6/24/2014 X:\Projects\8766\DCAD\PERMIT2014

dA4501-1 415-1324