
PLAT OF SURVEY

–OF–

LOT 29 OF OAK KNOLL SUBDIVISION, ACCORDING TO THE RECORDED PLAT THEREOF, BEING A SUBDIVISION OF A PART OF THE SOUTHWEST ONE–QUARTER (SW 1/4) OF THE SOUTHEAST ONE–QUARTER (SE 1/4) OF SECTION 34, TOWN 4 NORTH, RANGE 15 EAST, AND THE NORTHWEST ONE–QUARTER (NW 1/4) OF THE NORTHEAST ONE–QUARTER (NE 1/4) OF SECTION 3, TOWN 3 NORTH, RANGE 15 EAST, TOWN OF WHITEWATER, WALWORTH COUNTY, WISCONSIN.

SURVEY FOR: GABE PALOMBIT

SURVEY ADDRESS: N7364 KRAHN DRIVE

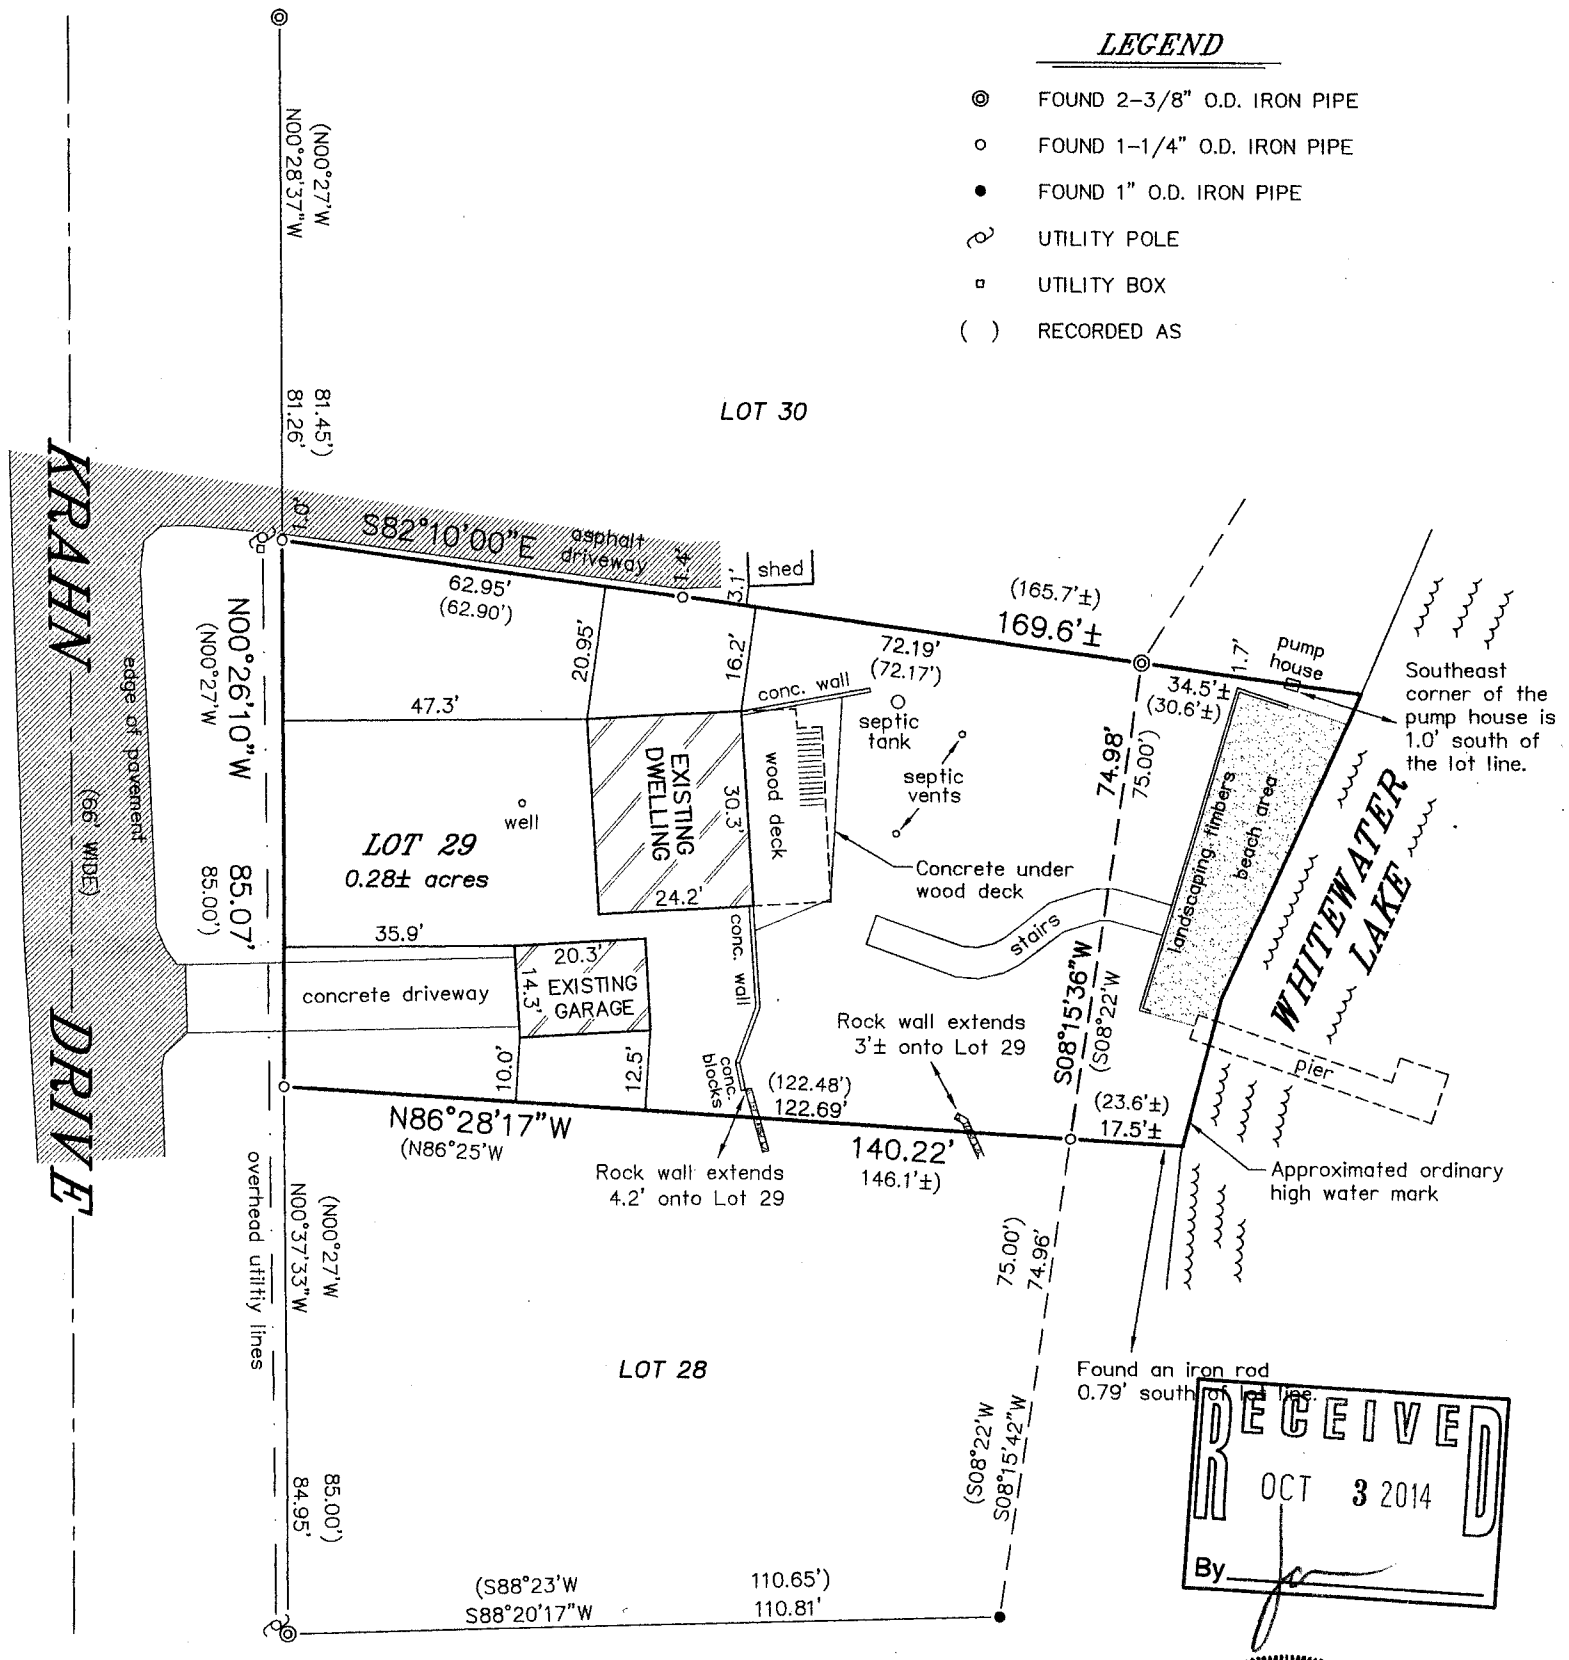

RECEIVED
OCT 3 2014
By

BEARINGS HEREON RELATE TO THE NORTH LINE OF LOT 29 OF OAK KNOLL SUBDIVISION. ASSUMED BEARING OF SOUTH 82°10'00" EAST AS PLATTED.

N

0 15' 30' 60'

SCALE: 1"= 30'

"I HEREBY CERTIFY THAT I HAVE SURVEYED THE ABOVE DESCRIBED PROPERTY AND THAT THE ABOVE MAP IS A CORRECT REPRESENTATION THEREOF AND SHOWS THE SIZE AND LOCATION OF THE PROPERTY, ITS EXTERIOR BOUNDARIES, THE LOCATION OF ALL VISIBLE STRUCTURES AND DIMENSIONS OF ALL PRINCIPAL BUILDINGS THEREON, BOUNDARY FENCES, APPARENT EASEMENTS, ROADWAYS AND ENCROACHMENTS, IF ANY."

"THIS SURVEY IS MADE FOR THE USE OF THE PRESENT OWNERS OF THE PROPERTY, AND THOSE WHO PURCHASE, MORTGAGE, OR GUARANTEE THE TITLE THERETO WITHIN ONE YEAR FROM DATE HEREOF."

WISCONSIN
THOMAS L. SATTER
S-2850
BURLINGTON, WI
LAND SURVEYOR

THIS IS NOT AN ORIGINAL PRINT UNLESS THIS SEAL IS RED.

Thomas L. Satter

THOMAS L. SATTER S–2850

SATTER SURVEYING, LLC
LAND SURVEYS, MAPPING AND PLANNING
272 ORIGEN STREET
BURLINGTON, WI 53105
262–661–4239

AUGUST 16, 2014 — DATE

081402 — JOB NUMBER

dOK-12 415-1329