LAND-MARK SURVEYING
Mark L. Miritz
Wisconsin Registered Land Surveyor S-2582


N9330 Knuteson Drive
Whitewater, WI 53190
Phone:(262)495-3284
FAX : (262) 495-8421
LAND-MARKSURVEYING.COM


PLAT OF SURVEY

LOT 12, BLOCK 2, LUDTKE SUBDIVISION, LOCATED IN THE SOUTHWEST 1/4 OF SECTION 26, AND THE SOUTHEAST 1/4 OF SECTION 27, AND THE NORTH-WEST 1/4 OF THE NORTHEAST 1/4 AND THE NORTHEAST 1/4 OF THE NORTH-EAST 1/4 OF SECTION 34, ALL IN TOWN 4 NORTH, RANGE 15 EAST, WHITEWATER TOWNSHIP, WALWORTH COUNTY, WISCONSIN.

ORDERED BY: ATTORNEY MARK OLM
OLM & ASSOCIATES
522 WEST MAIN STREET
WHITEWATER, WI 53190

SITE ADDRESS:
W8080 BAYVIEW DRIVE
WHITEWATER, WI 53190

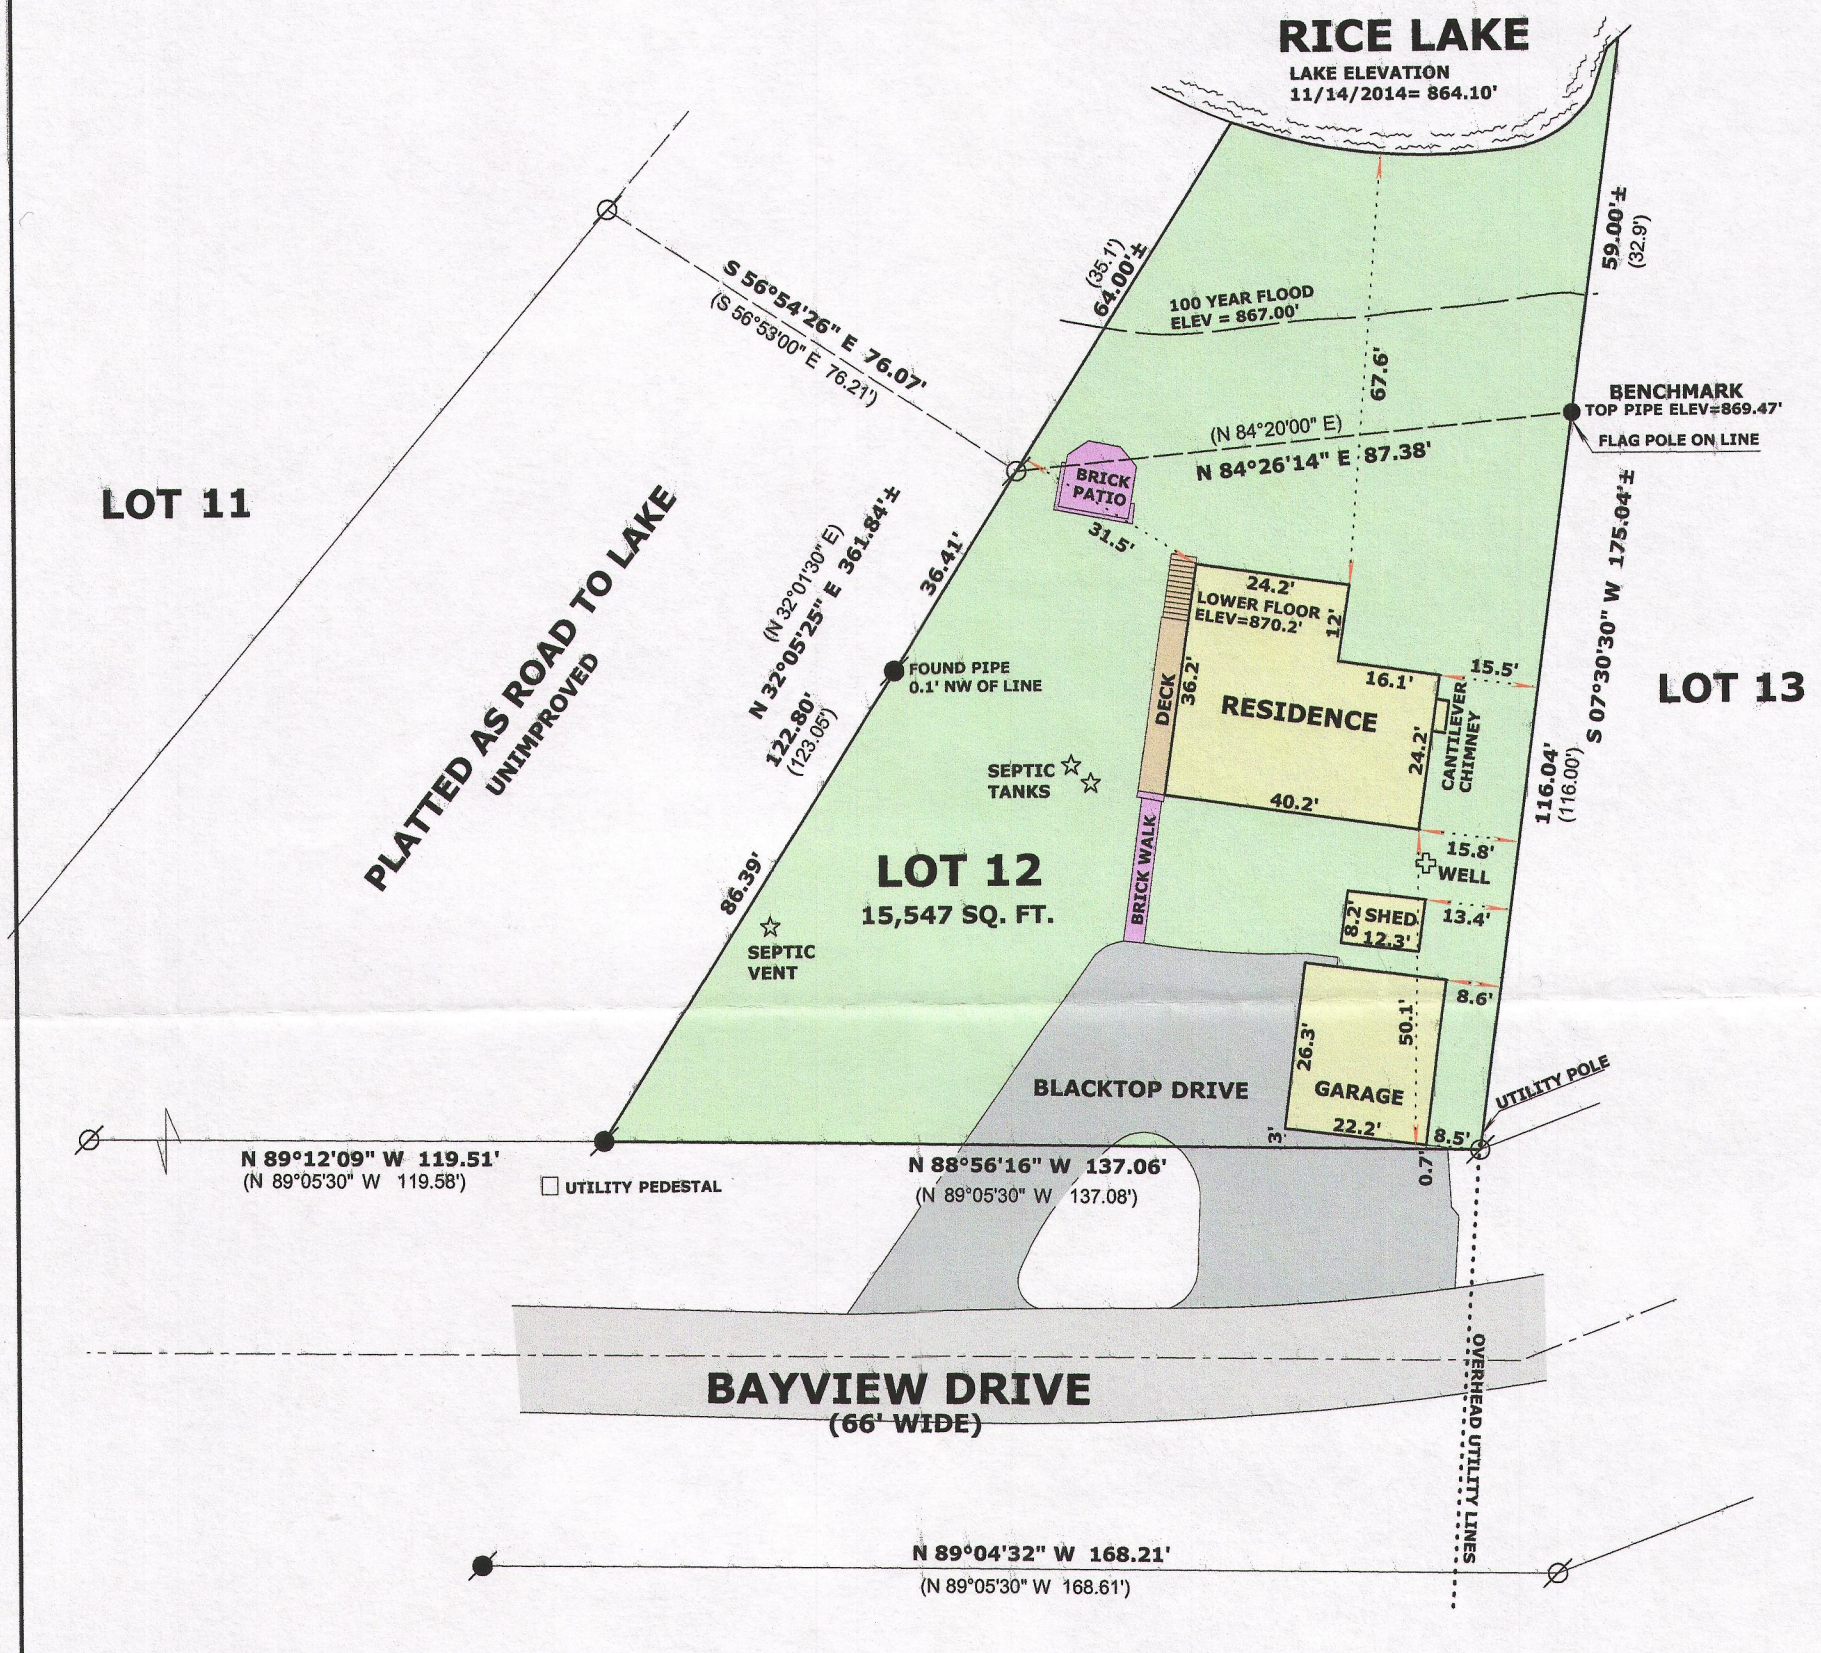

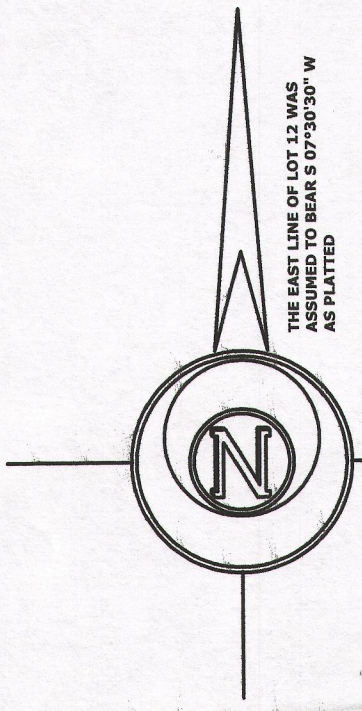

VERICAL DATUM (NAVD 88)
THE SE CORNER OF SECTION
27-4-15 WAS ASSUMED 882.77'

LEGEND

∅	FOUND IRON PIPE 2"
●	FOUND IRON PIPE 1 1/2"
●	FOUND IRON PIPE 1 1/4"
(x x)	RECORDED AS DIMENSION

WISCONSIN
MARK L. MIRITZ
S-2582
WHITEWATER, WI
LAND SURVEYOR

RECEIVED
DEC 10 2014
By

SCALE: 1 INCH = 30 FEET

"I hereby certify that the above described property has been surveyed by me or under my direction and that the above map is a true representation thereof and shows the size and location of the property, its exterior boundaries, the location of all visible structures and dimensions of all principal buildings thereon, boundary fences, apparent easements, roadways and visible encroachments, if any."
"This survey is made for the use of the present owners of the property, and also those who purchase, mortgage, or guarantee the title thereto within one year from date hereof."

Mark L. Miritz
MARK L. MIRITZ
WISCONSIN REGISTERED
LAND SURVEYOR S-2582

DATE: NOV. 15, 2014 **JOB NO.** 14.1103

dL 8-15 415-1335