

Plat of Survey


of

Lot 4 of Certified Survey Map No. 2417,


recorded in Vol. 12 of Certified Survey Maps of Walworth County on Page 54 and located in the Northwest 1/4 of Section 36, Town 4 North, Range 15 East, Town of Whitewater, Walworth County, Wisconsin.

Surveyed for: **L & W Revocable Trust**

434 Winnebago Drive
Janesville, Wisconsin. 53545

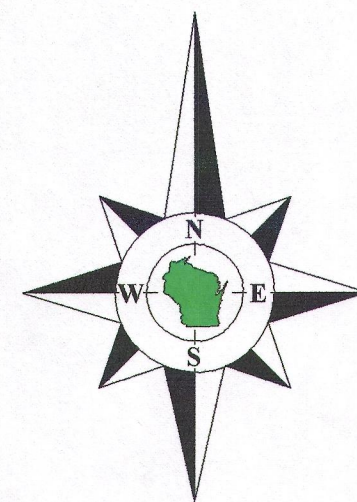

Bearings reference to Certified Survey Map No. 2417.

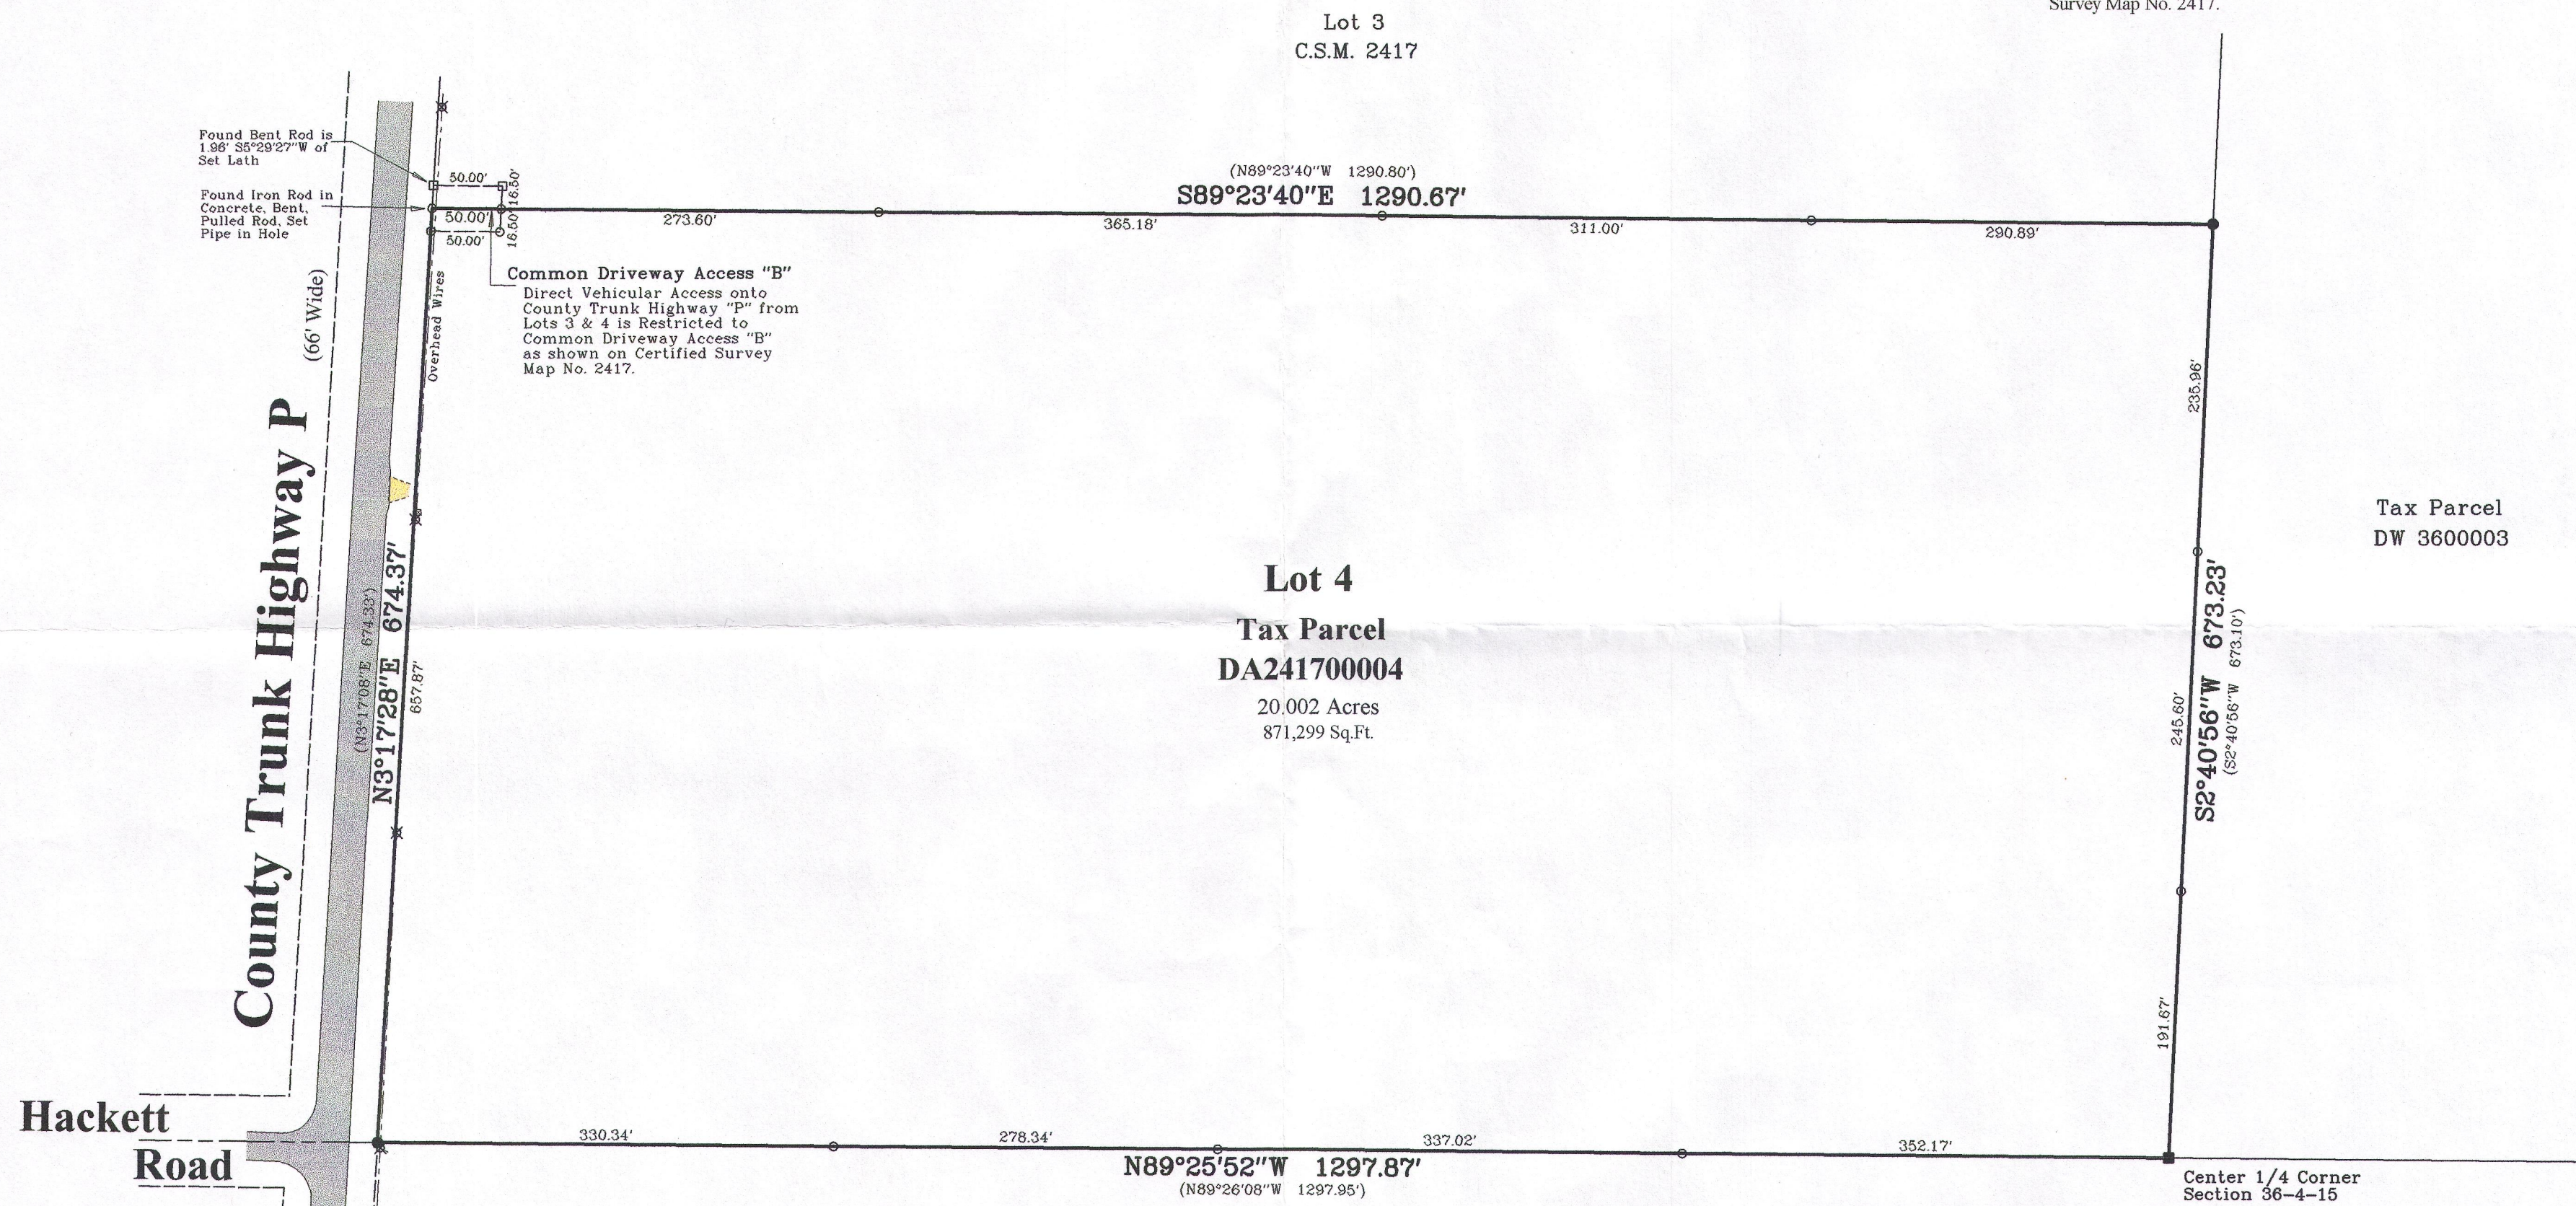

Hackett Road


County Trunk Highway P
(66' Wide)

Common Driveway Access "B"
Direct Vehicular Access onto
County Trunk Highway "P" from
Lots 3 & 4 is Restricted to
Common Driveway Access "B"
as shown on Certified Survey
Map No. 2417.

Lot 4
Tax Parcel
DA241700004
20.002 Acres
871,299 Sq.Ft.

Tax Parcel
DW 3600003

Tax Parcel
DW 3600006C

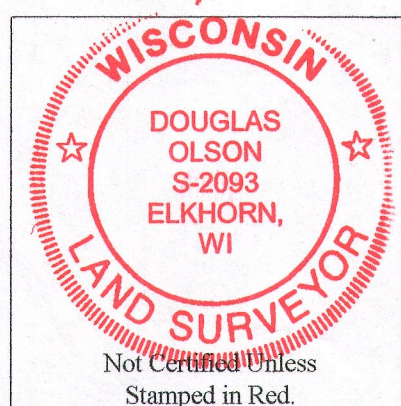

Notes:

- 1) This survey plat is not certified unless signed and sealed in red ink.
- 2) This survey is subject to Wisconsin lien laws. This Plat of Survey is the notice of intent to file lien. Lien waiver required.

Copyright 2015 by Olson Land Surveying, LLC.


All rights reserved. No part of this survey plat may be reproduced or transmitted in any form by any means - graphic, electronic, or mechanical, including photocopying, tracing, or information storage and retrieval systems - without permission in writing from Douglas G. Olson, Olson Land Surveying, LLC.

I, Douglas G. Olson, Wisconsin Professional Land Surveyor, do hereby certify that this survey was performed by me, or under my direction in full compliance with the owner's/agent's instructions and Chapter A-E 7 of the Wisconsin Administrative Code "Minimum Standards for Property Surveys"; and that this map is an accurate representation thereof to the best of my knowledge and belief.

Douglas G. Olson
Wisconsin Professional Land Surveyor - 2093

Survey Date: November 9, 2015.
Revisions:

Scale in Feet
1" = 100'

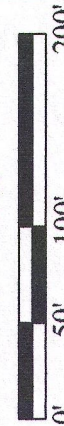

Olson Land Surveying, LLC



45 South Wisconsin Street * P.O. Box 322 * Elkhorn, Wisconsin. 53121
Telephone: (262) 723-3434 * Facsimile: (262) 723-8044
Email: doug@olsonsurveying.com

Legend

- Found County Section Corner
- Found Iron Rod in Concrete
- Set Iron Pipe, 1" dia.
- Set Wood Stake
- Recorded Information
- Utility Pole
- Pedestal
- Asphalt Surface
- Gravel

Sheet 1 of 1 Sheets

Job Reference Number

2015.092

2015.092

DA2417-4

415-1368