
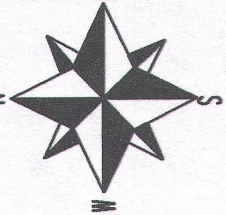


PREPARED FOR:
LOWELL MANAGEMENT
401 WEST MAIN AVE S
LAKE GENEVA, WI 53147

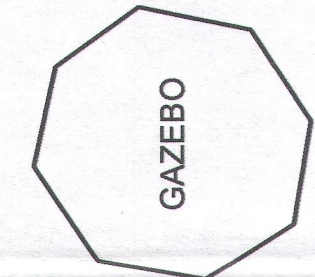


BEARINGS HEREON RELATE TO
THE WISCONSIN COUNTY
E & WALWORTH COUNTY ZONE
ALL ELEVATIONS RELATE TO
NAVD83

LYNCH & ASSOCIATES
SURVEYING & CONSULTANTS, LLC

405 SKYLINE DRIVE, SUITE C
LAKE GENEVA, WI 53147
(262) 245-3887



LEGAL DESCRIPTION:

LOT 29 OF OAK KNOLL SUBDIVISION ACCORDING TO THE
RECORDED PLAT THEREOF, BEING A SUBDIVISION OF A
PART OF THE SOUTHWEST 1/4 OF THE SOUTHEAST 1/4 OF
SECTION 34, TOWN 4 NORTH, RANGE 15 EAST, AND THE
NORTHWEST 1/4 OF THE NORTHEAST 1/4 OF SECTION 3,
TOWN 3 NORTH, RANGE 15 EAST, WALWORTH COUNTY,
WISCONSIN.

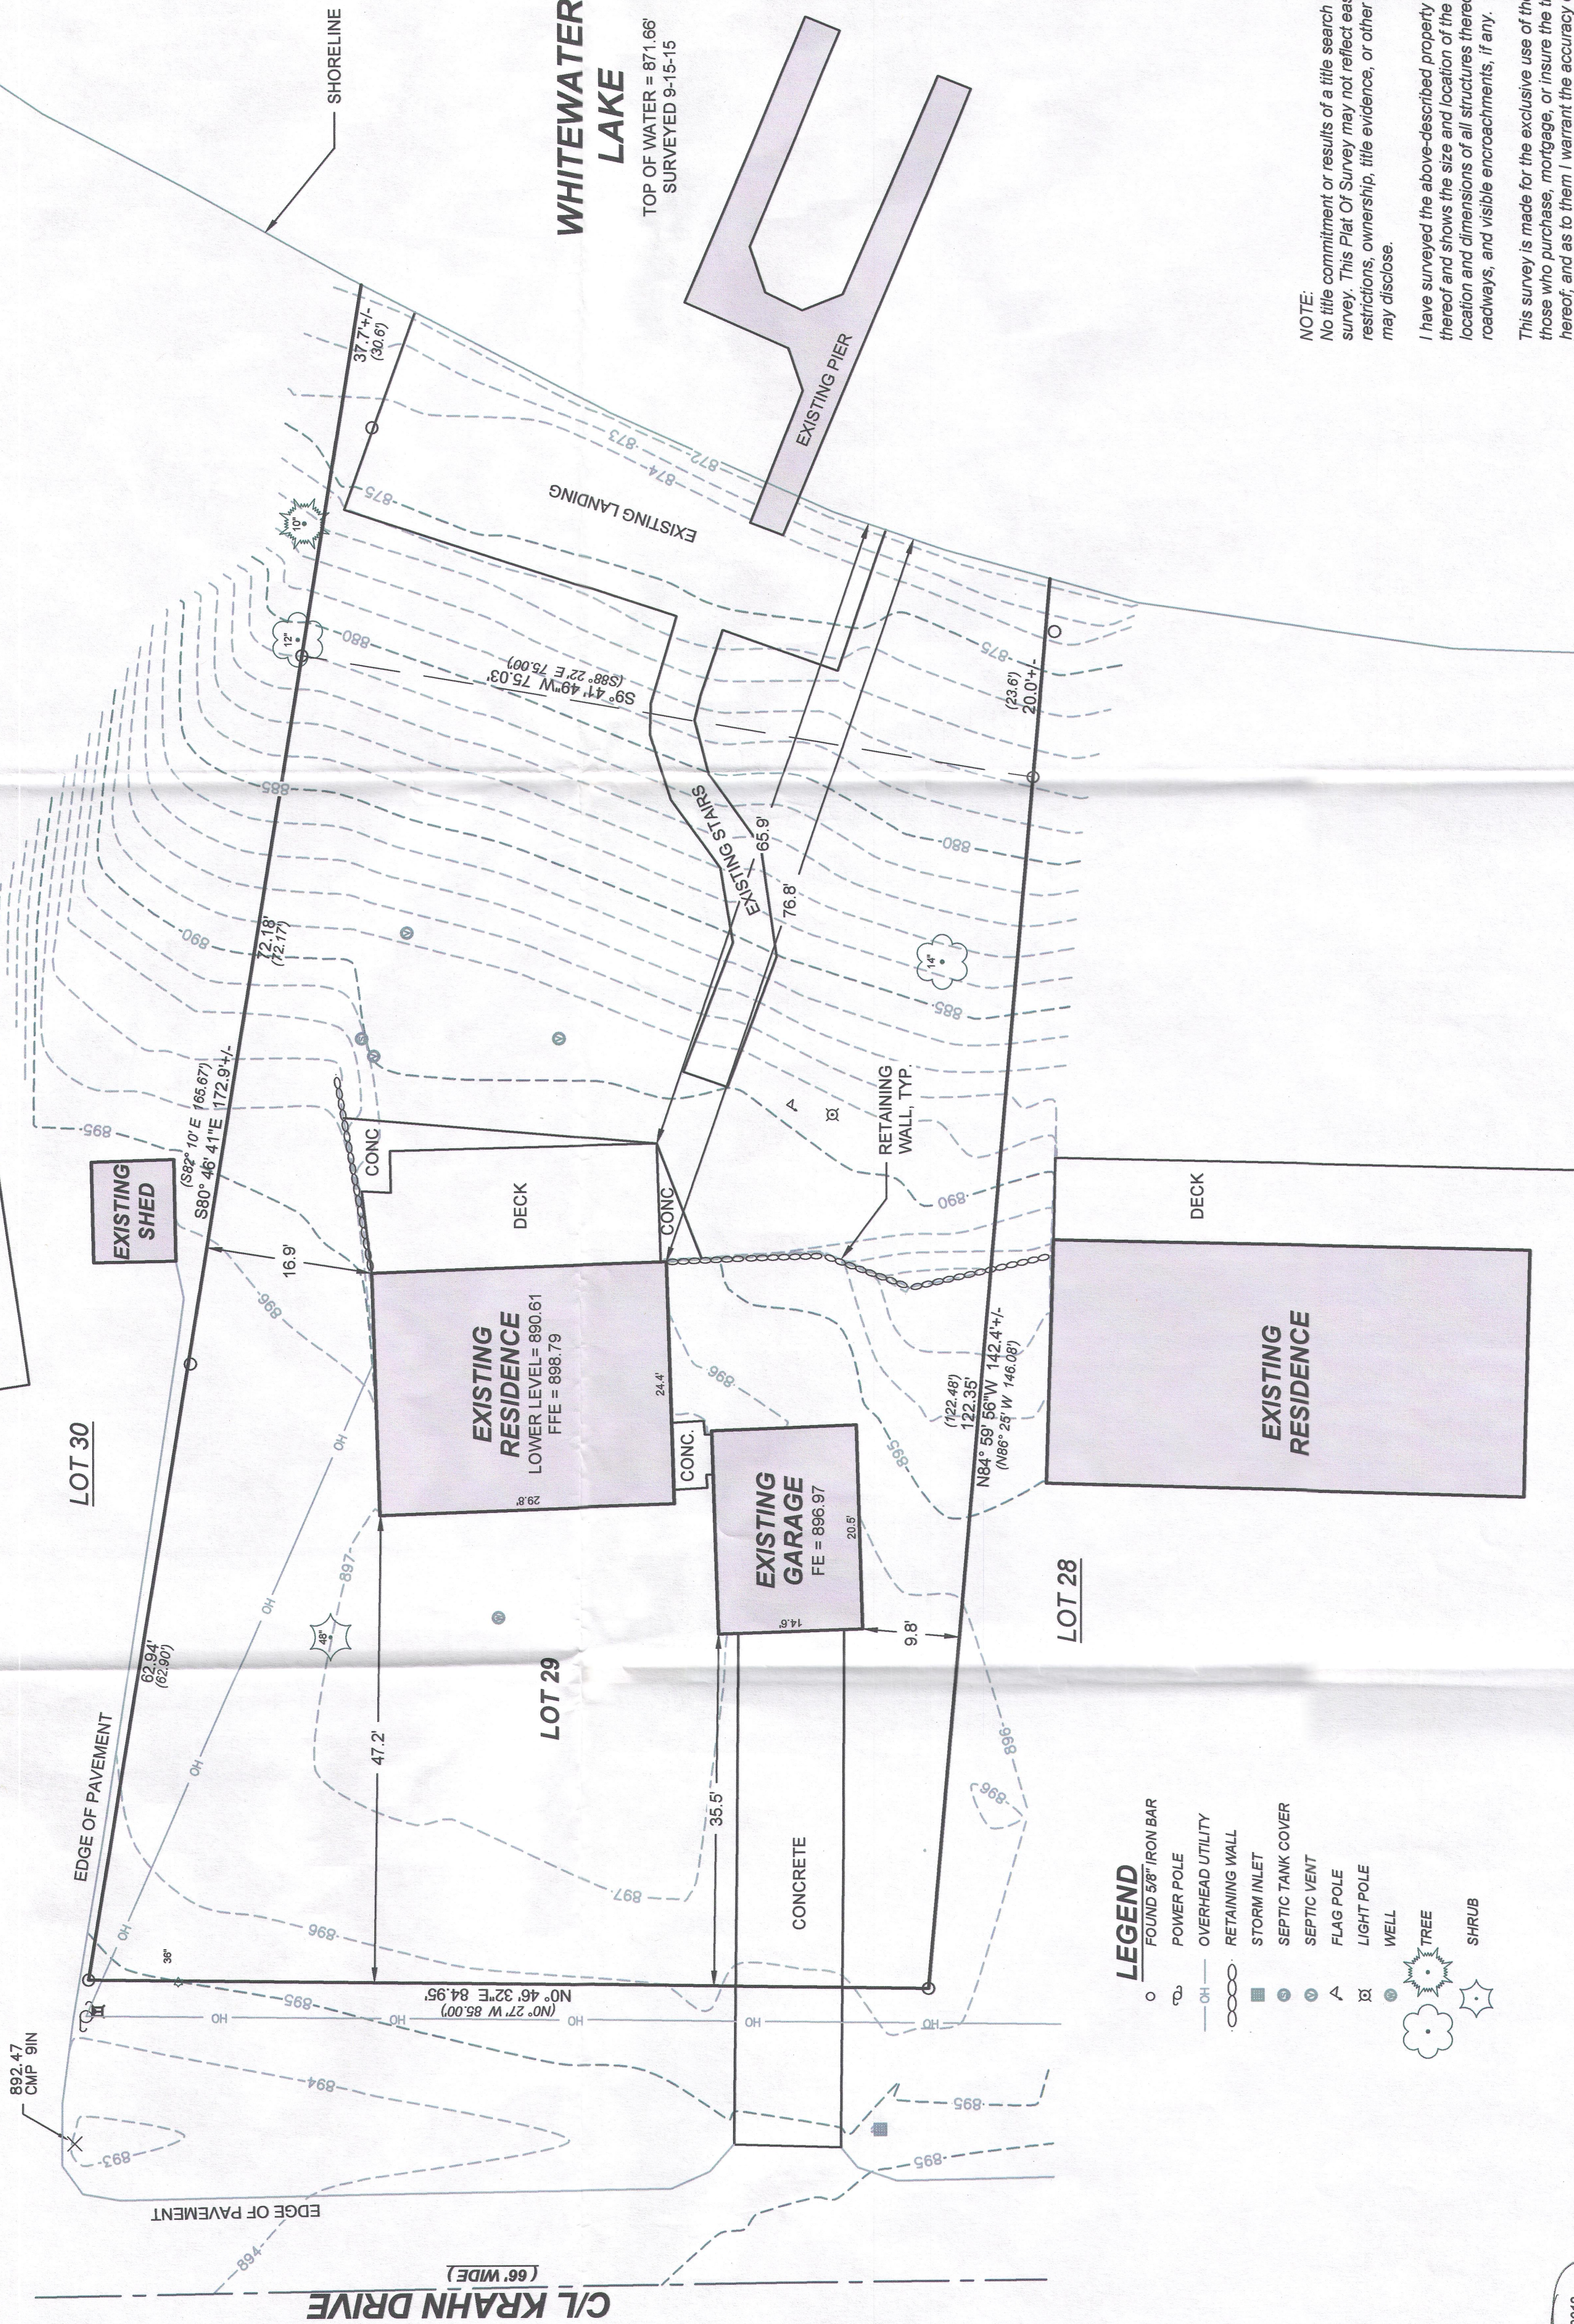

EXISTING SETBACKS FROM SHORELINE (FIELD LOCATED - NOT MAPPED HEREON)	

TOPOGRAPHIC PLAT OF SURVEY
- OF -
N7364 KRAHN DRIVE
TOWN OF WHITEWATER, WALWORTH COUNTY, WISCONSIN

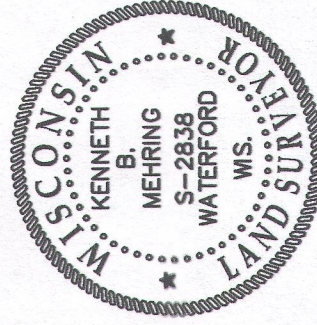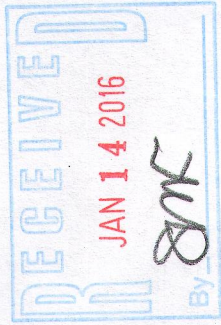

NOTE:
No life commitment or results of a title search were provided to this office pertaining to this
survey. This Plat Of Survey may not reflect easements of record, encumbrances,
restrictions, ownership, title evidence, or other facts that a current and accurate title search
may disclose.

I have surveyed the above-described property and the above map is a true representation
thereof and shows the size and location of the property, its exterior boundaries, the
location and dimensions of all structures thereon, fences, apparent easements and
roadways, and visible encroachments, if any.

This survey is made for the exclusive use of the present owners of the property, and also
those who purchase, mortgage, or insure the title thereto within one (1) year from date
hereof, and as to them I warrant the accuracy of said survey map.

KENNETH B. MEHRING S-2838
WISCONSIN REGISTERED
LAND SURVEYOR
(original if signed in red)

TAXID # DOK 00012

FILENAME: c:\Egnyte\Shared\Y - Projects\2015\15.641 Lowell N7364 Krahn Dr [CAD] Sheets\15.641 Plat of Survey.dwg

PLOT DATE: 10/11/2015 7:01 PM

415-1371