
GEORGE T. DUNHAM
SURVEYING & SUBDIVIDING
DELAVAN, WISCONSIN



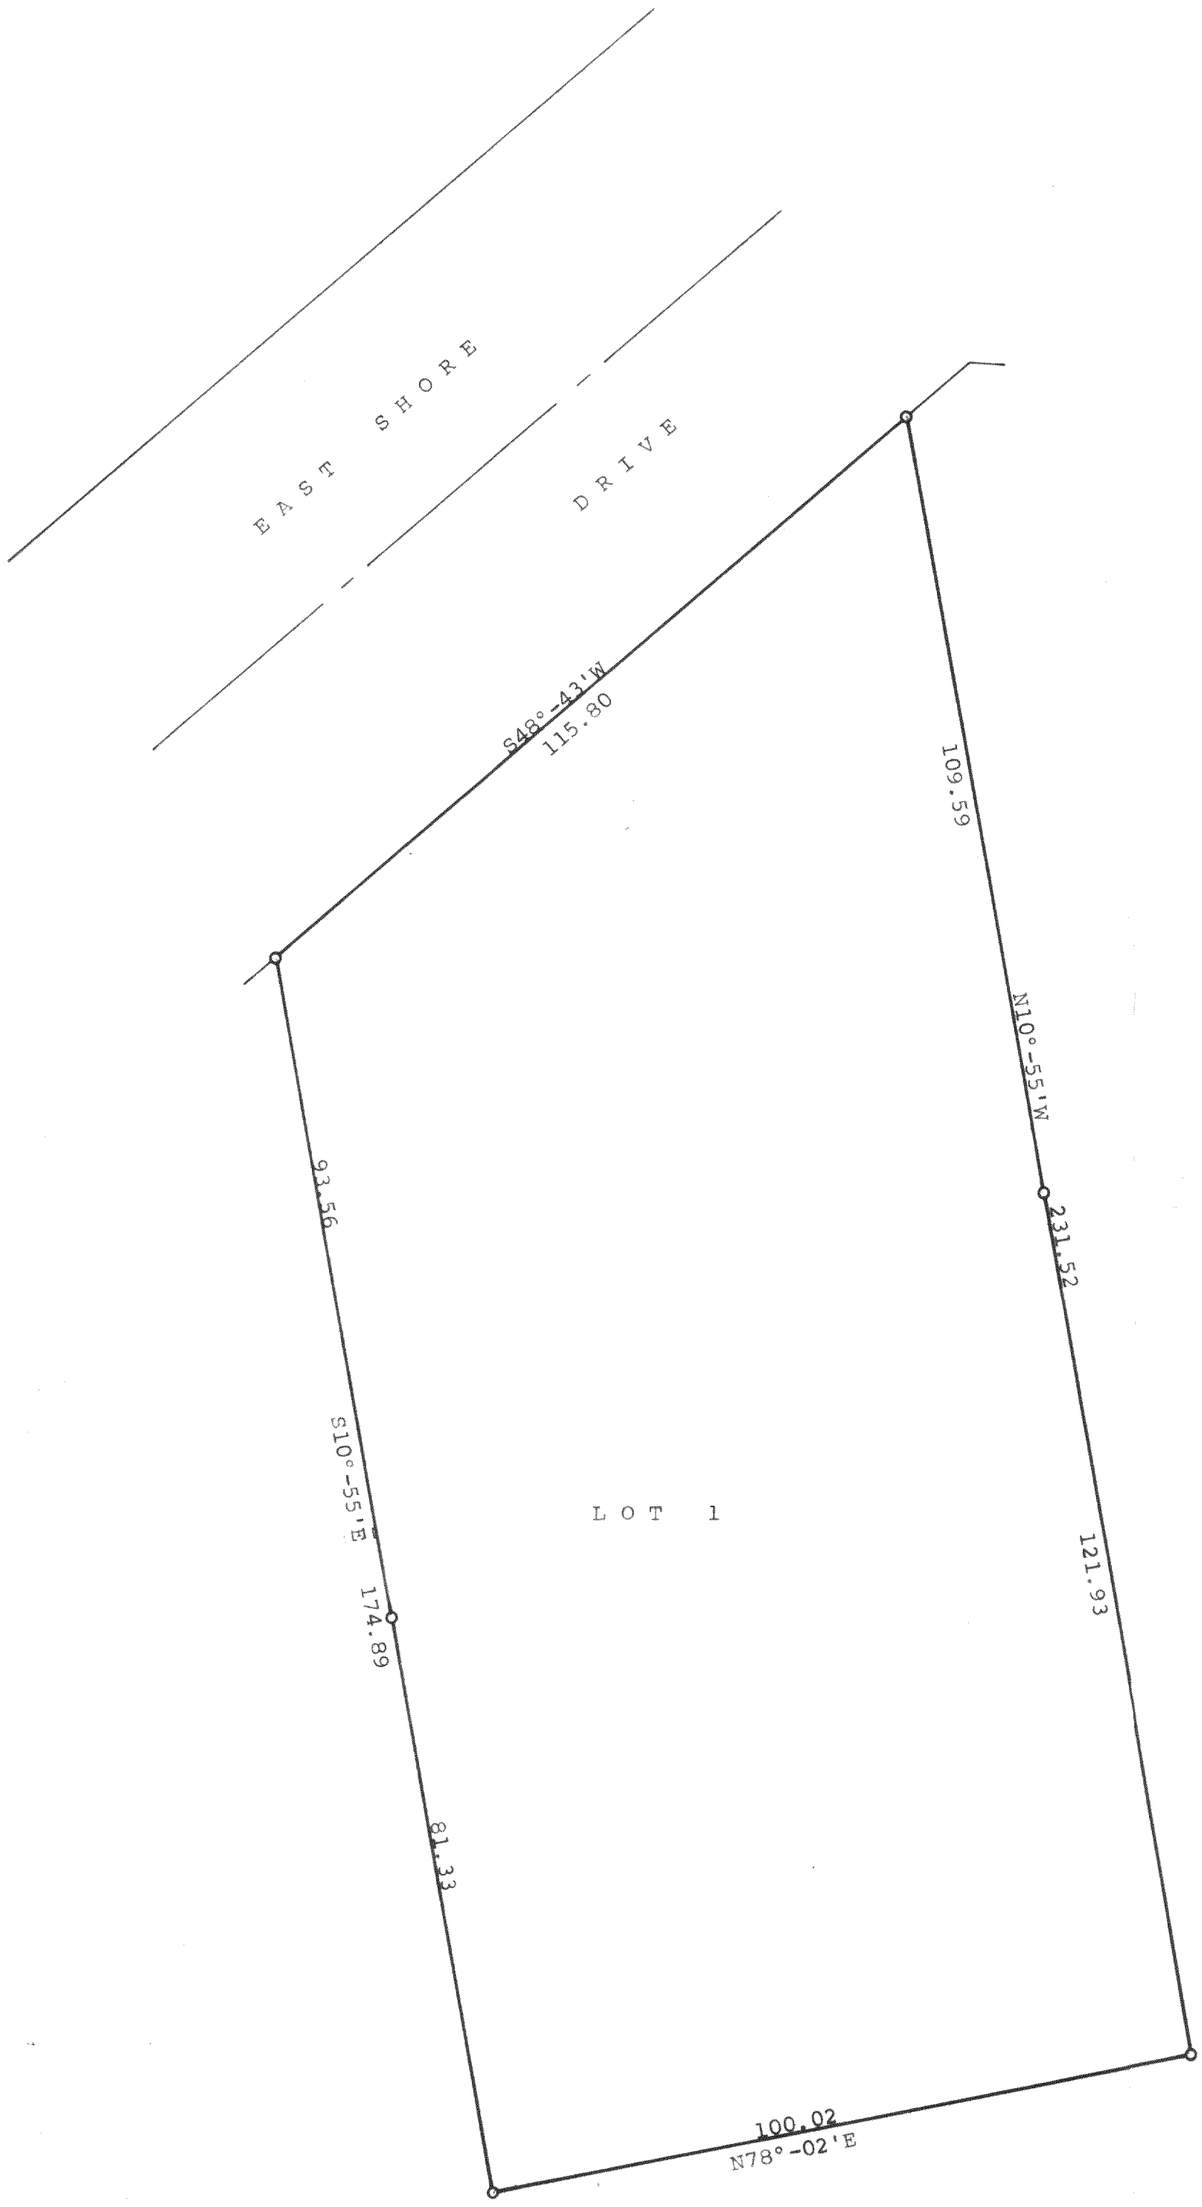

Scale - 1" = 20'
o = Iron Rods found

Plat of survey of Lot 1 of Certified Survey No. 10
of Walworth County records, located in the Northeast
¼ of Section 35, T 4 N, R 15 E, Walworth County, Wisconsin
August 9, 1974

George T. Dunham, Surveyor


WISCONSIN
GEORGE T. DUNHAM
DELAVAN, WIS.
LAND SURVEYOR

DA 10-1

K & E 10-9195 250-7-73

415-138

GEORGE T. DUNHAM
SURVEYING & SUBDIVIDING
DELAVAN, WISCONSIN

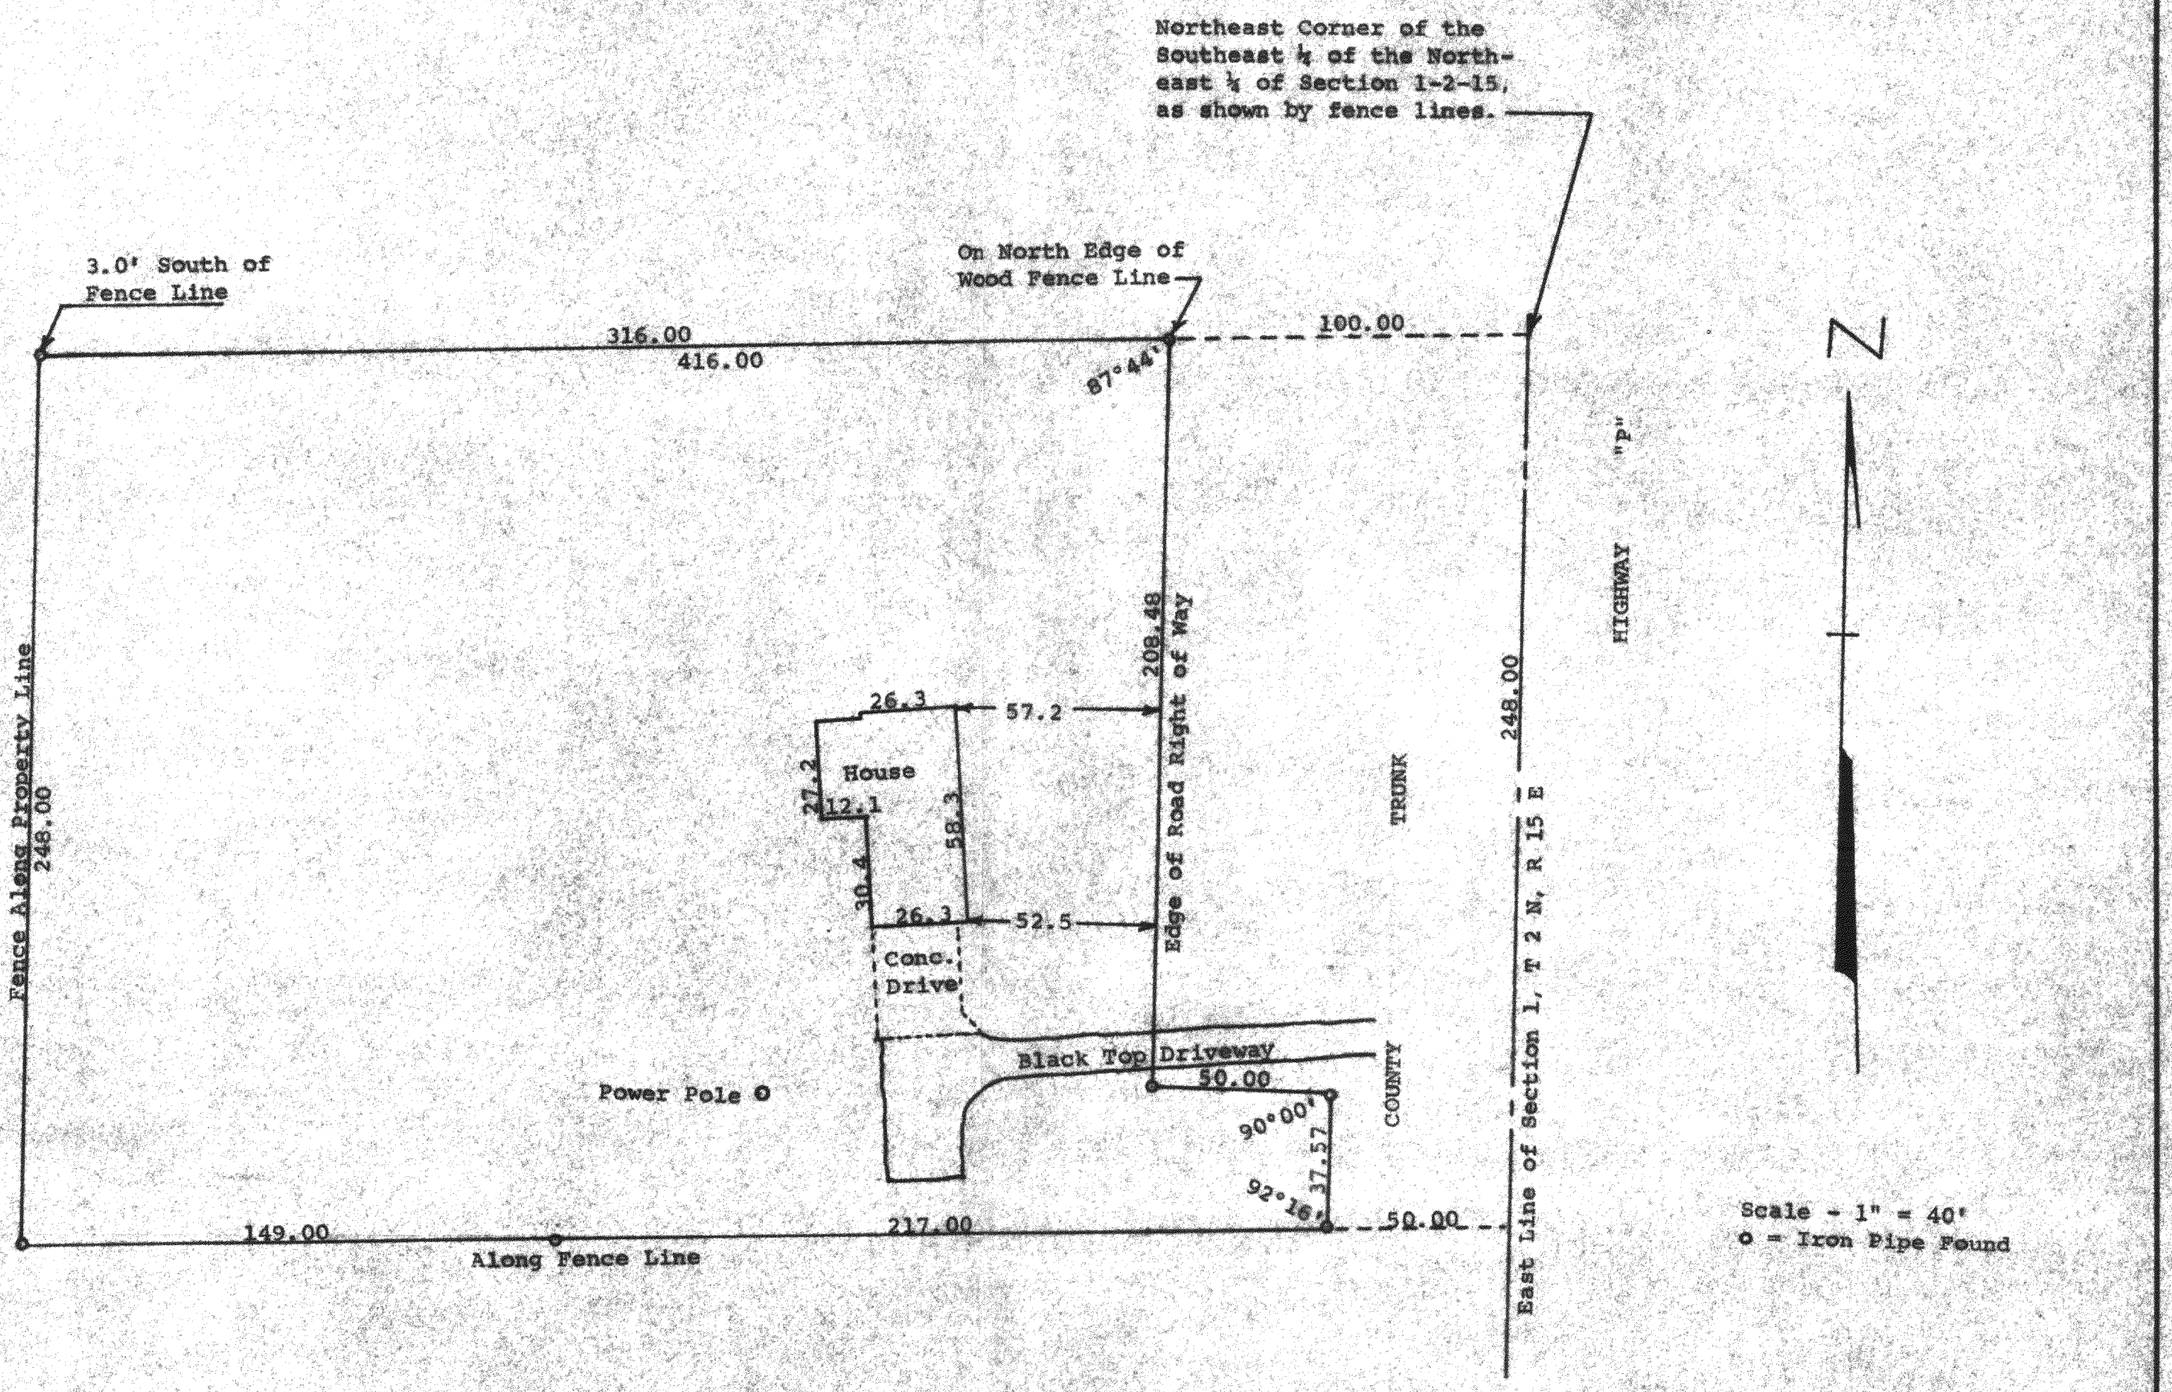

STATE OF WISCONSIN) SS
COUNTY OF WALWORTH)

I, George T. Dunham, Surveyor, certify that I have surveyed the property described as follows,

A parcel of land located in the Southeast ¼ of the Northeast ¼ of Section 1, T 2 N, R 15 E, Walworth County, Wisconsin, described as follows: Beginning at the northeast corner of said Southeast ¼ of the Northeast ¼ of said Section 1; thence South along the centerline of County Trunk Highway "P" and the east line of said Northeast ¼, 248.00 feet; thence West parallel with the north line of said Southeast ¼ of the Northeast ¼ as fenced, 416.00 feet; thence North parallel with the east line of said Northeast ¼, 248.00 feet; thence East along the North line of said Southeast ¼ of the Northeast ¼ as fenced 416.00 feet to the place of beginning EXCEPTING therefrom all land described in Volume 504 of Deeds on Page 89, Document No. 485423 - Conveyance of Land for Highway Purposes, Dated October 18, 1956,

and the above map is a true representation thereof and shows the size and location of the property, its exterior boundaries, the location and dimensions of all structures thereon, fences, apparent easements and roadways and visible encroachments, if any.

This survey is made for the exclusive use of the present owners of the property, and also those who purchase, mortgage, or guarantee the title thereto within one (1) year from date hereof; and as to them I warrant the accuracy of said survey and map.

May 25, 1976

George T. Dunham, Surveyor

D-1-2B

WISCONSIN
GEORGE T. DUNHAM
DELAVAN, WIS.
LAND SURVEYOR

K & E 10-9189 250-6-75

215-138