LAND-MARK SURVEYING
Mark L. Miritz
Wisconsin Professional Land Surveyor S-2582

~~N9330 Knuteson Drive~~
Whitewater, WI 53190
~~Phone:(262)495-3284~~
MARKMIRITZ@
LAND-MARKSURVEYING.COM


PLAT OF SURVEY

LOT 27, BLOCK 1 OF MORAINE HEIGHTS SUBDIVISION, LOCATED IN PART OF THE NORTHWEST 1/4 AND PART OF THE NORTHEAST 1/4 OF SECTION 35, TOWN 4 NORTH, RANGE 15 EAST, WHITEWATER TOWNSHIP, WALWORTH COUNTY, WISCONSIN.

OWNERS:
DANIEL M. GREISING
REBECCA R. GREISING
918 N. CARLYE LANE
ARLINGTON HEIGHTS, IL 60004

RECEIVED
JUL 31 2017
By jan

WISCONSIN
MARK L. MIRITZ
S-2582
WHITEWATER, WI
LAND SURVEYOR

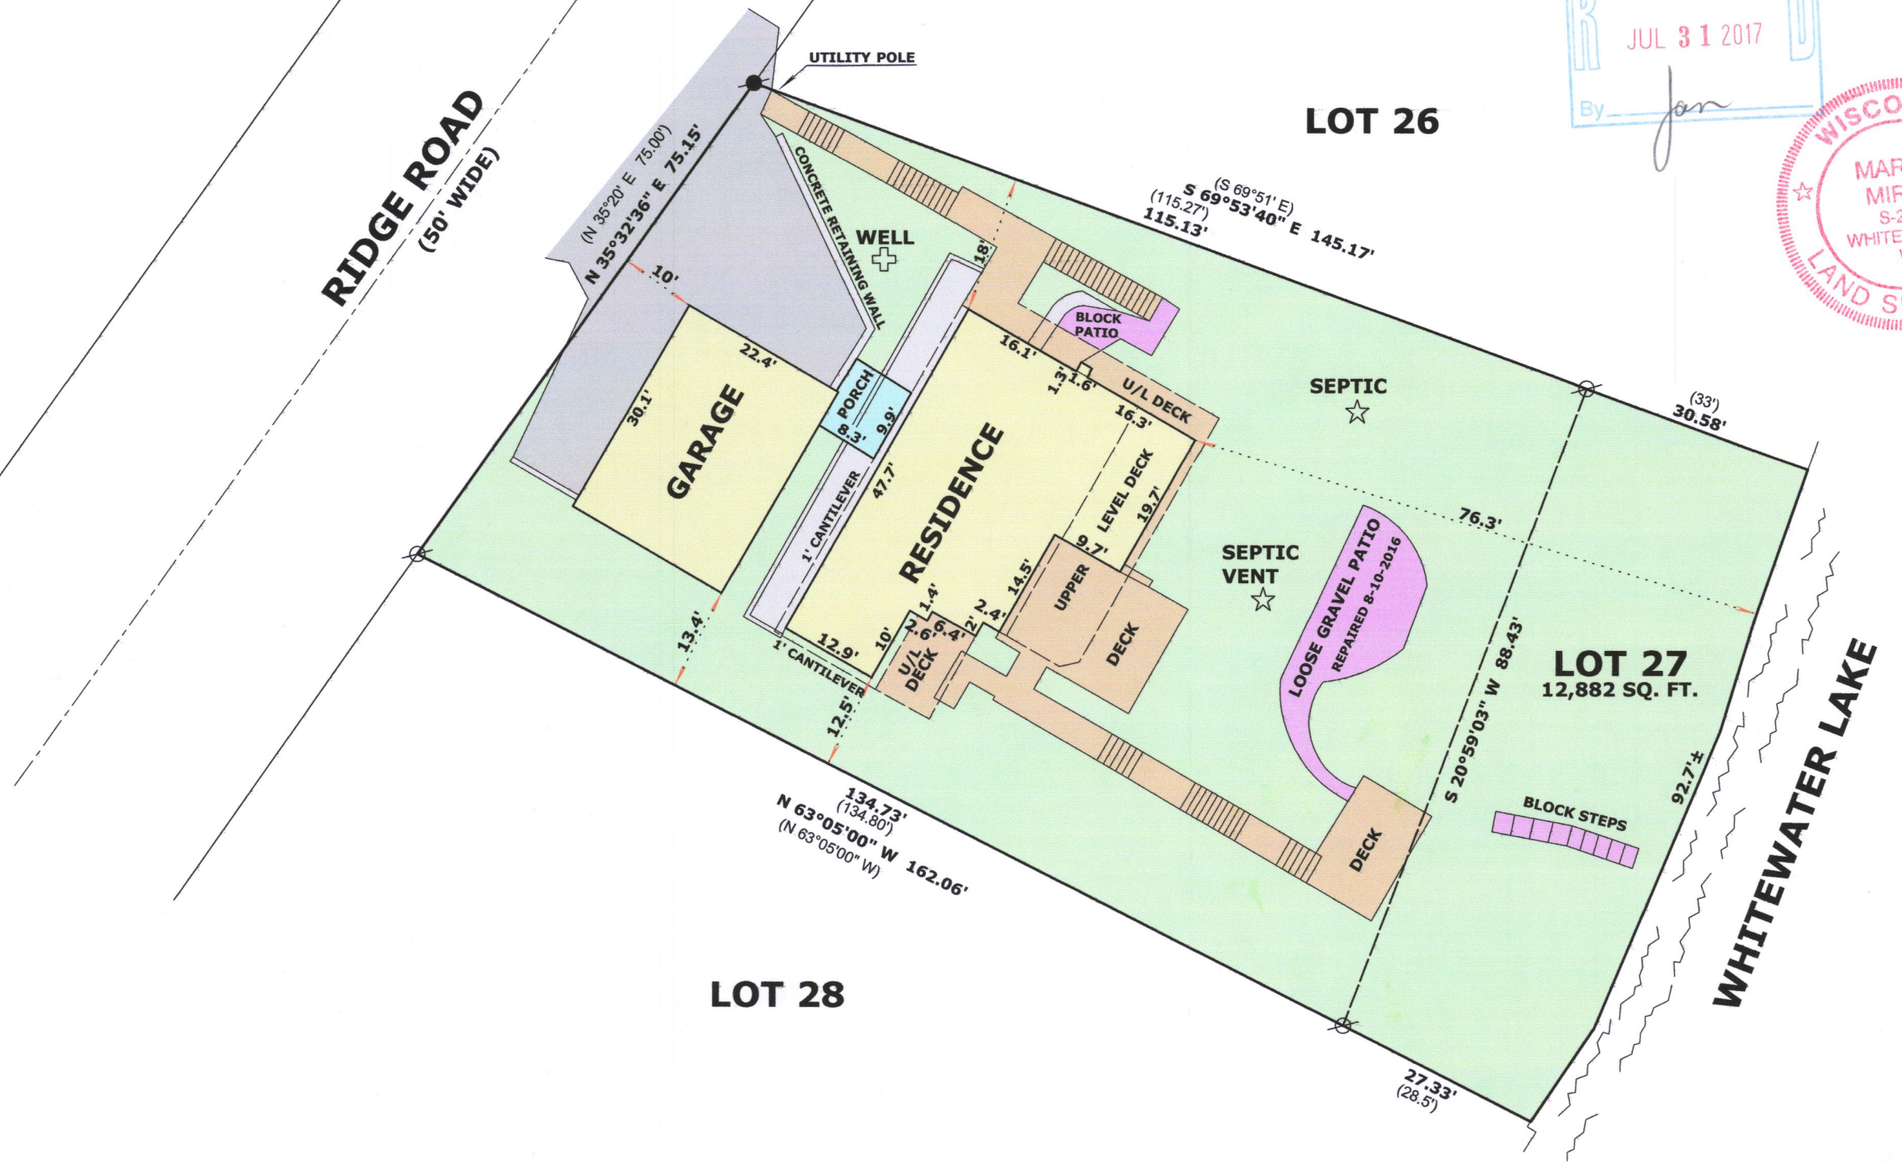

LEGEND

- ⌀ FOUND IRON PIPE
- ● FOUND IRON ROD
- (x x) RECORDED AS DIMENSION

SCALE: 1 INCH = 20 FEET

"I hereby certify that the above described property has been surveyed by me or under my direction and that the above map is a true representation thereof and shows the size and location of the property, its exterior boundaries, the location of all visible structures and dimensions of all principal buildings thereon, boundary fences, apparent easements, roadways and visible encroachments, if any."
"This survey is made for the use of the present owners of the property, and also those who purchase, mortgage, or guarantee the title thereto within one year from date hereof."

Mark L. Miritz

MARK L. MIRITZ
WISCONSIN PROFESSIONAL
LAND SURVEYOR S-2582

DATE: APRIL 9, 2017 **JOB NO.** 17.310

dmH-27 415-1421