LAND-MARK SURVEYING
Mark L. Miritz
Wisconsin Professional Land Surveyor S-2582


N9330 Knuteson Drive
Whitewater, WI 53190
Phone:(262)495-3284
MARKMIRITZ@
LAND-MARKSURVEYING.COM

PLAT OF SURVEY

LEGAL DESCRIPTION:

LOT 10, BLK. 1, CHAPEL HILLS SUBDIVISION
LOCATED IN THE SOUTHEAST 1/4 OF THE SOUTHEAST 1/4, SECTION 34,
TOWNSHIP 4 NORTH, RANGE 15 EAST, IN THE TOWN OF WHITEWATER,
WALWORTH COUNTY, WISCONSIN

OWNER: ERNEST J ROY TRUST
LILLIAN D. ROY TRUST
N7350 CHAPEL DRIVE
WHITEWATER, WI. 53190

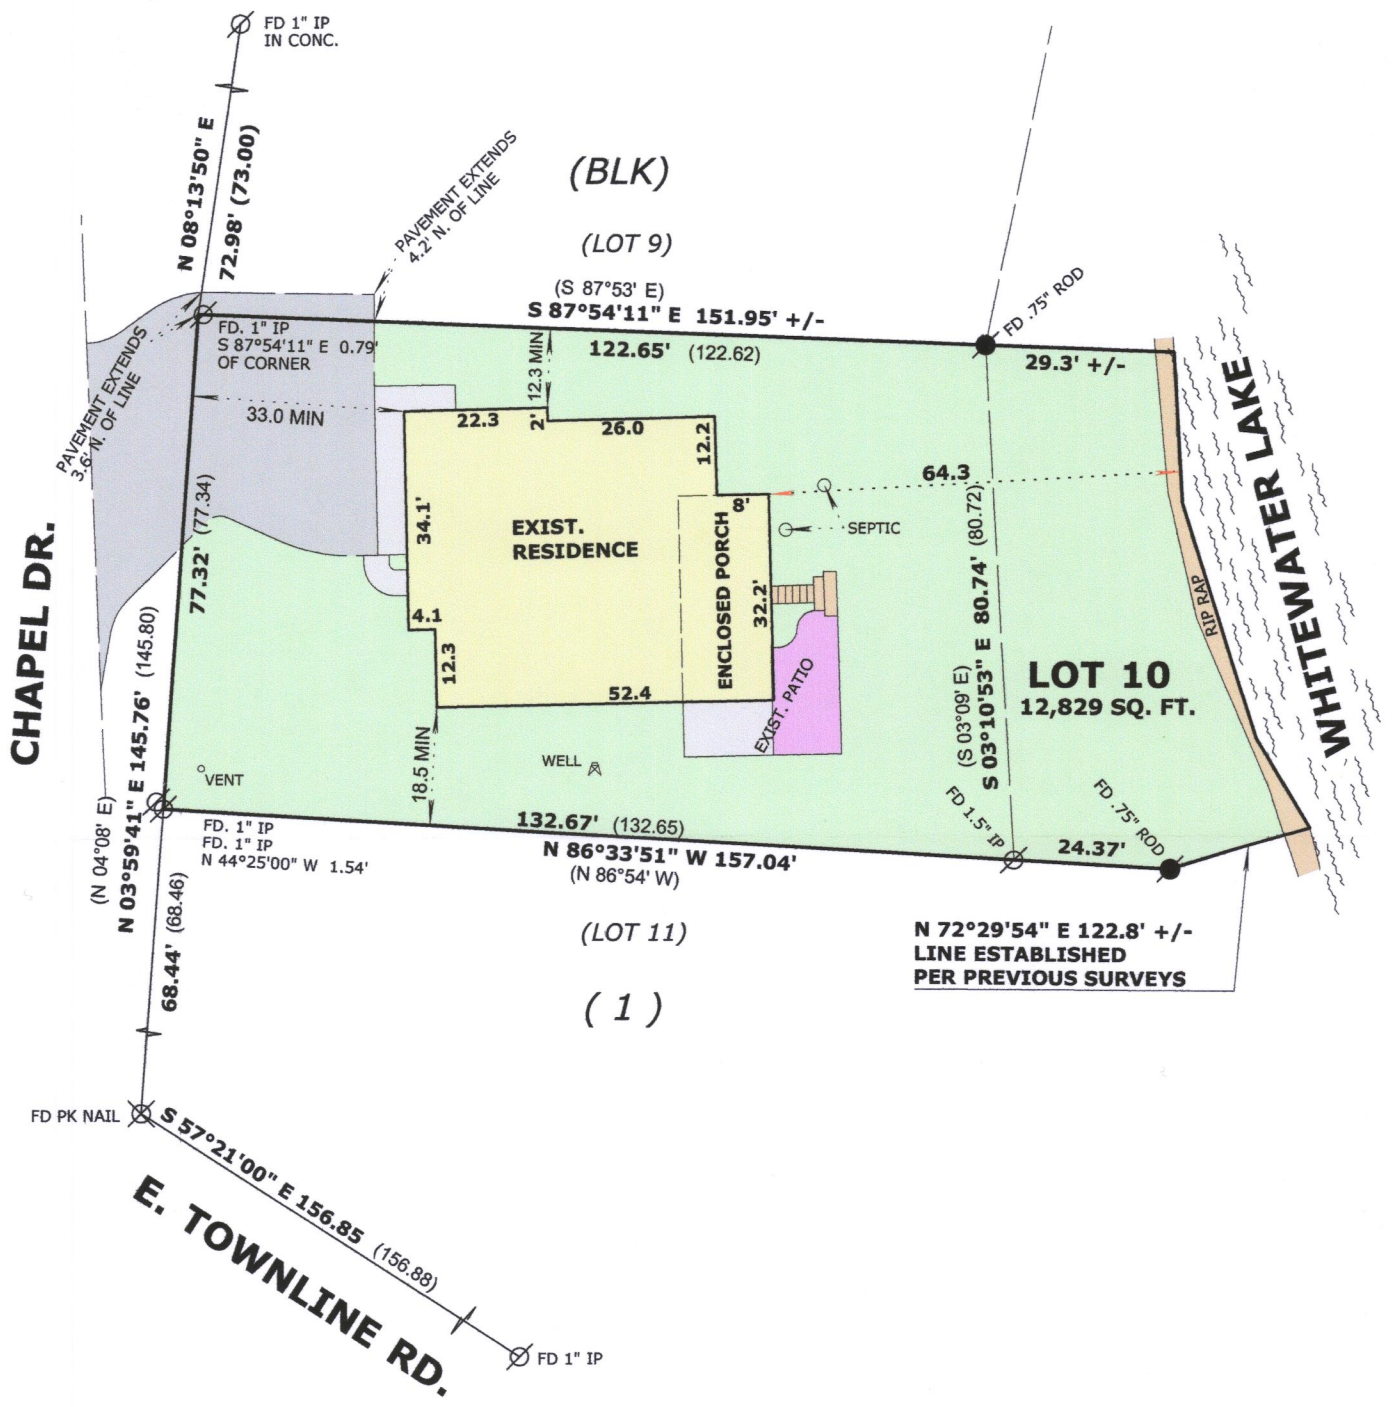

BASIS OF BEARINGS:
THE N'LY LINE OF TOWNLINE RD.
BEING S 57°21'00" E

LEGEND

- ⌀ FOUND IRON PIPE
- ● FOUND IRON ROD

(x x) RECORDED AS DIMENSION

SCALE: 1 INCH = 30 FEET

"I hereby certify that the above described property has been surveyed by me or under my direction and that the above map is a true representation thereof and shows the size and location of the property, its exterior boundaries, the location of all visible structures and dimensions of all principal buildings thereon, boundary fences, apparent easements, roadways and visible encroachments, if any."
"This survey is made for the use of the present owners of the property, and also those who purchase, mortgage, or guarantee the title thereto within one year from date hereof."

Mark L. Miritz

MARK L. MIRITZ
WISCONSIN PROFESSIONAL
LAND SURVEYOR S-2582

DATE: APRIL 30, 2017 **JOB NO. 17.414**

RECEIVED
JUL 31 2017
By

WISCONSIN
MARK L. MIRITZ
S-2582
WHITEWATER, WI
LAND SURVEYOR

dcH-10 415-1427