
PLAT OF SURVEY

OUT LOT ONE, COUNTRY ACRES, BEING A PART OF THE NORTHWEST 1/4 OF SECTION 25, TOWN 4 NORTH, RANGE 15 EAST, WALWORTH COUNTY, WISCONSIN.

SURVEYED FOR: ARTHUR THOMPSON
SURVEY ADDRESS: N8090 KRISTY LANE

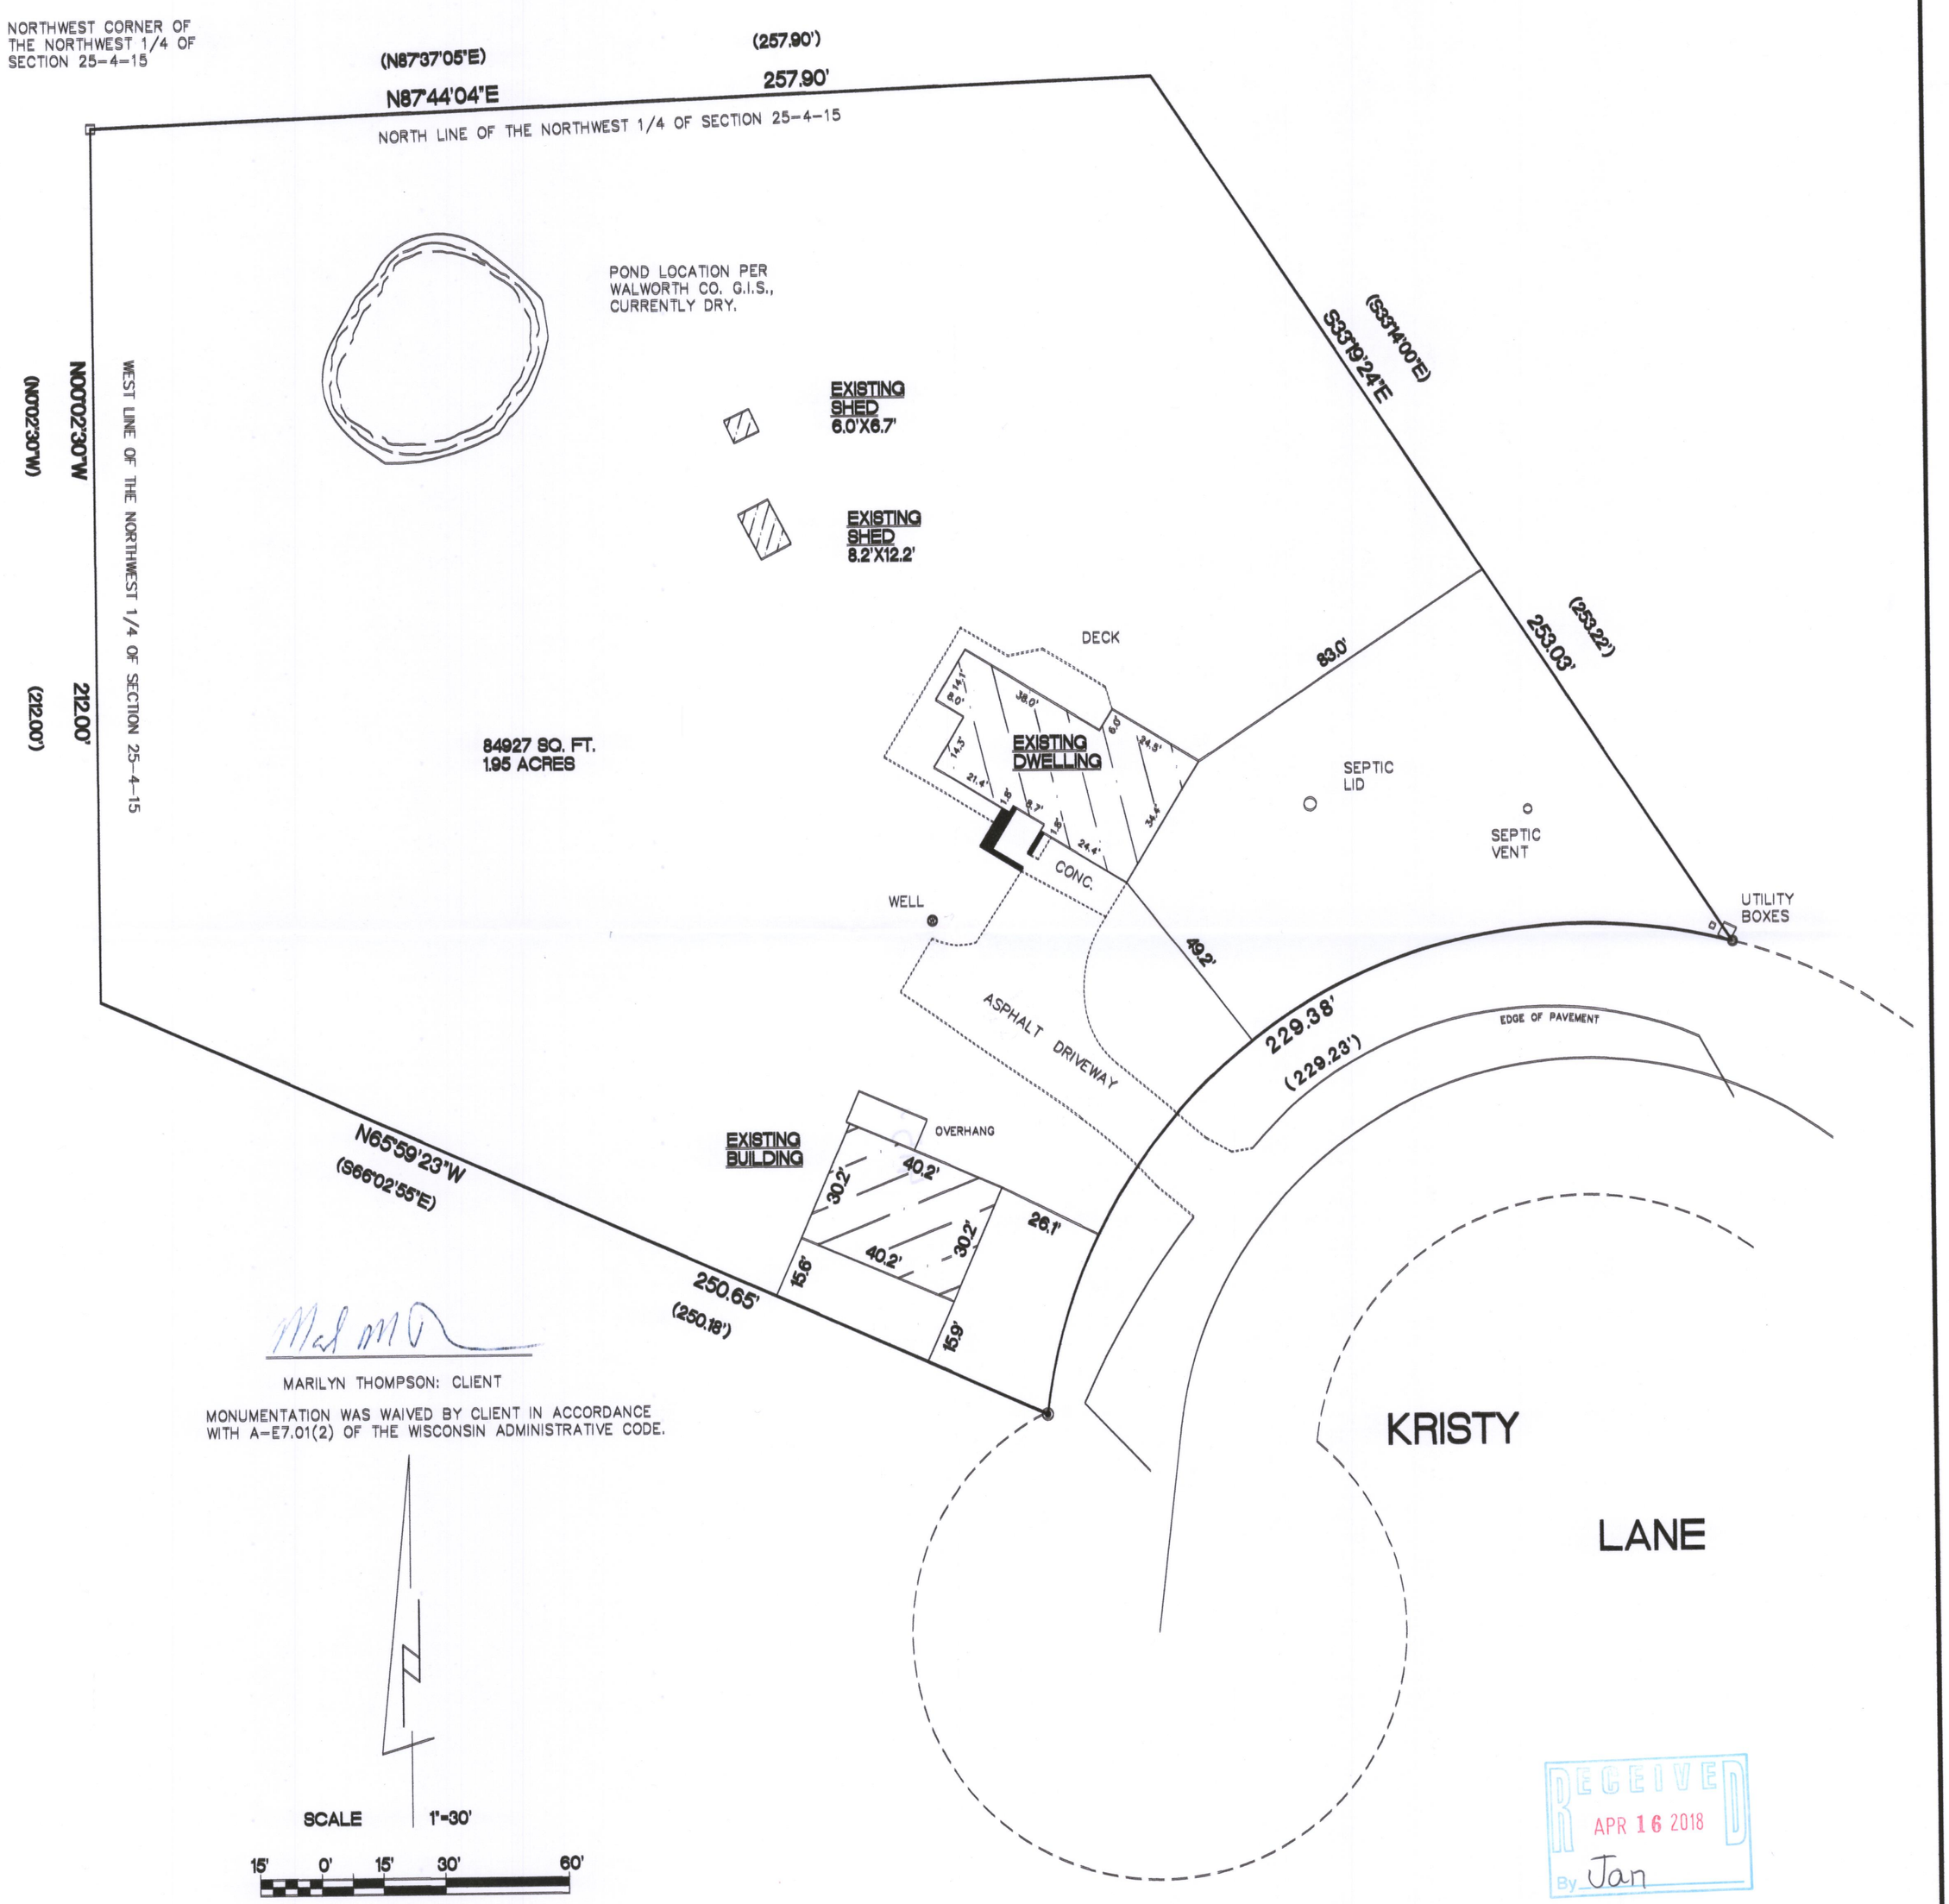

MARILYN THOMPSON: CLIENT

MONUMENTATION WAS WAIVED BY CLIENT IN ACCORDANCE WITH A-E7.01(2) OF THE WISCONSIN ADMINISTRATIVE CODE.

SCALE 1"=30'

15' 0' 15' 30' 60'

BEARINGS ARE REFERENCED TO THE WEST LINE OF THE NORTHWEST 1/4 OF SECTION 25-4-15 AND IS ASSUMED TO BEAR N00°02'30"W.

MEASURED CURVE DATA

RADIUS	LENGTH	CHORD	BEARING	DELTA
133.00'	229.38'	201.99'	S56°03'55"W	98°48'54"

RECORDED CURVE DATA

RADIUS	LENGTH	CHORD	BEARING	DELTA
133.00'	229.23'	201.89'	S56°08'33"W	98°45'06"

⊡ FOUND 6" CONC. MON. W/BRASS CAP

◉ FOUND 2" O.D. IRON PIPE

o FOUND 1 1/4" O.D. IRON PIPE

( ) RECORDED AS DIMENSIONS

Kettle Moraine Surveying Inc.
P.O. Box 357
Eagle WI. 53119
(262)594-3484
kettlemorainesurvey.com

"I hereby certify that I have surveyed the above property and that the above map is a true representation thereof and shows the size and location of the property, its exterior boundaries, the location of all visible structures and dimensions of all principal buildings thereon, boundary fences, apparent easements, roadways and encroachments if any."

"This survey is made for the use of the present owners of the property, and also those who purchase, mortgage or guarantee the title thereto within one year from date hereof."

WISCONSIN TERRANCE E. PISAREK S-1930 EAGLE, WISCONSIN LAND SURVEYOR

THIS IS NOT AN ORIGINAL SURVEY UNLESS THE SEAL IS RED.

REV. 1/29/18 10/5/17	TEP	TEP	17119
DATE	FIELD WORK BY	DRAWN BY	JOB NUMBER

RECEIVED
APR 16 2018
By Jan

DCM-11 415-1447