
PLAT OF SURVEY

BEING LOT 14 AND PART OF LOT 15, THORNE HEIGHTS SUBDIVISION, LOCATED IN PART OF THE SOUTHEAST ¼ AND IN THE SOUTHWEST ¼ OF SECTION 35, TOWNSHIP 4 NORTH, RANGE 15 EAST, WALWORTH COUNTY, WISCONSIN.

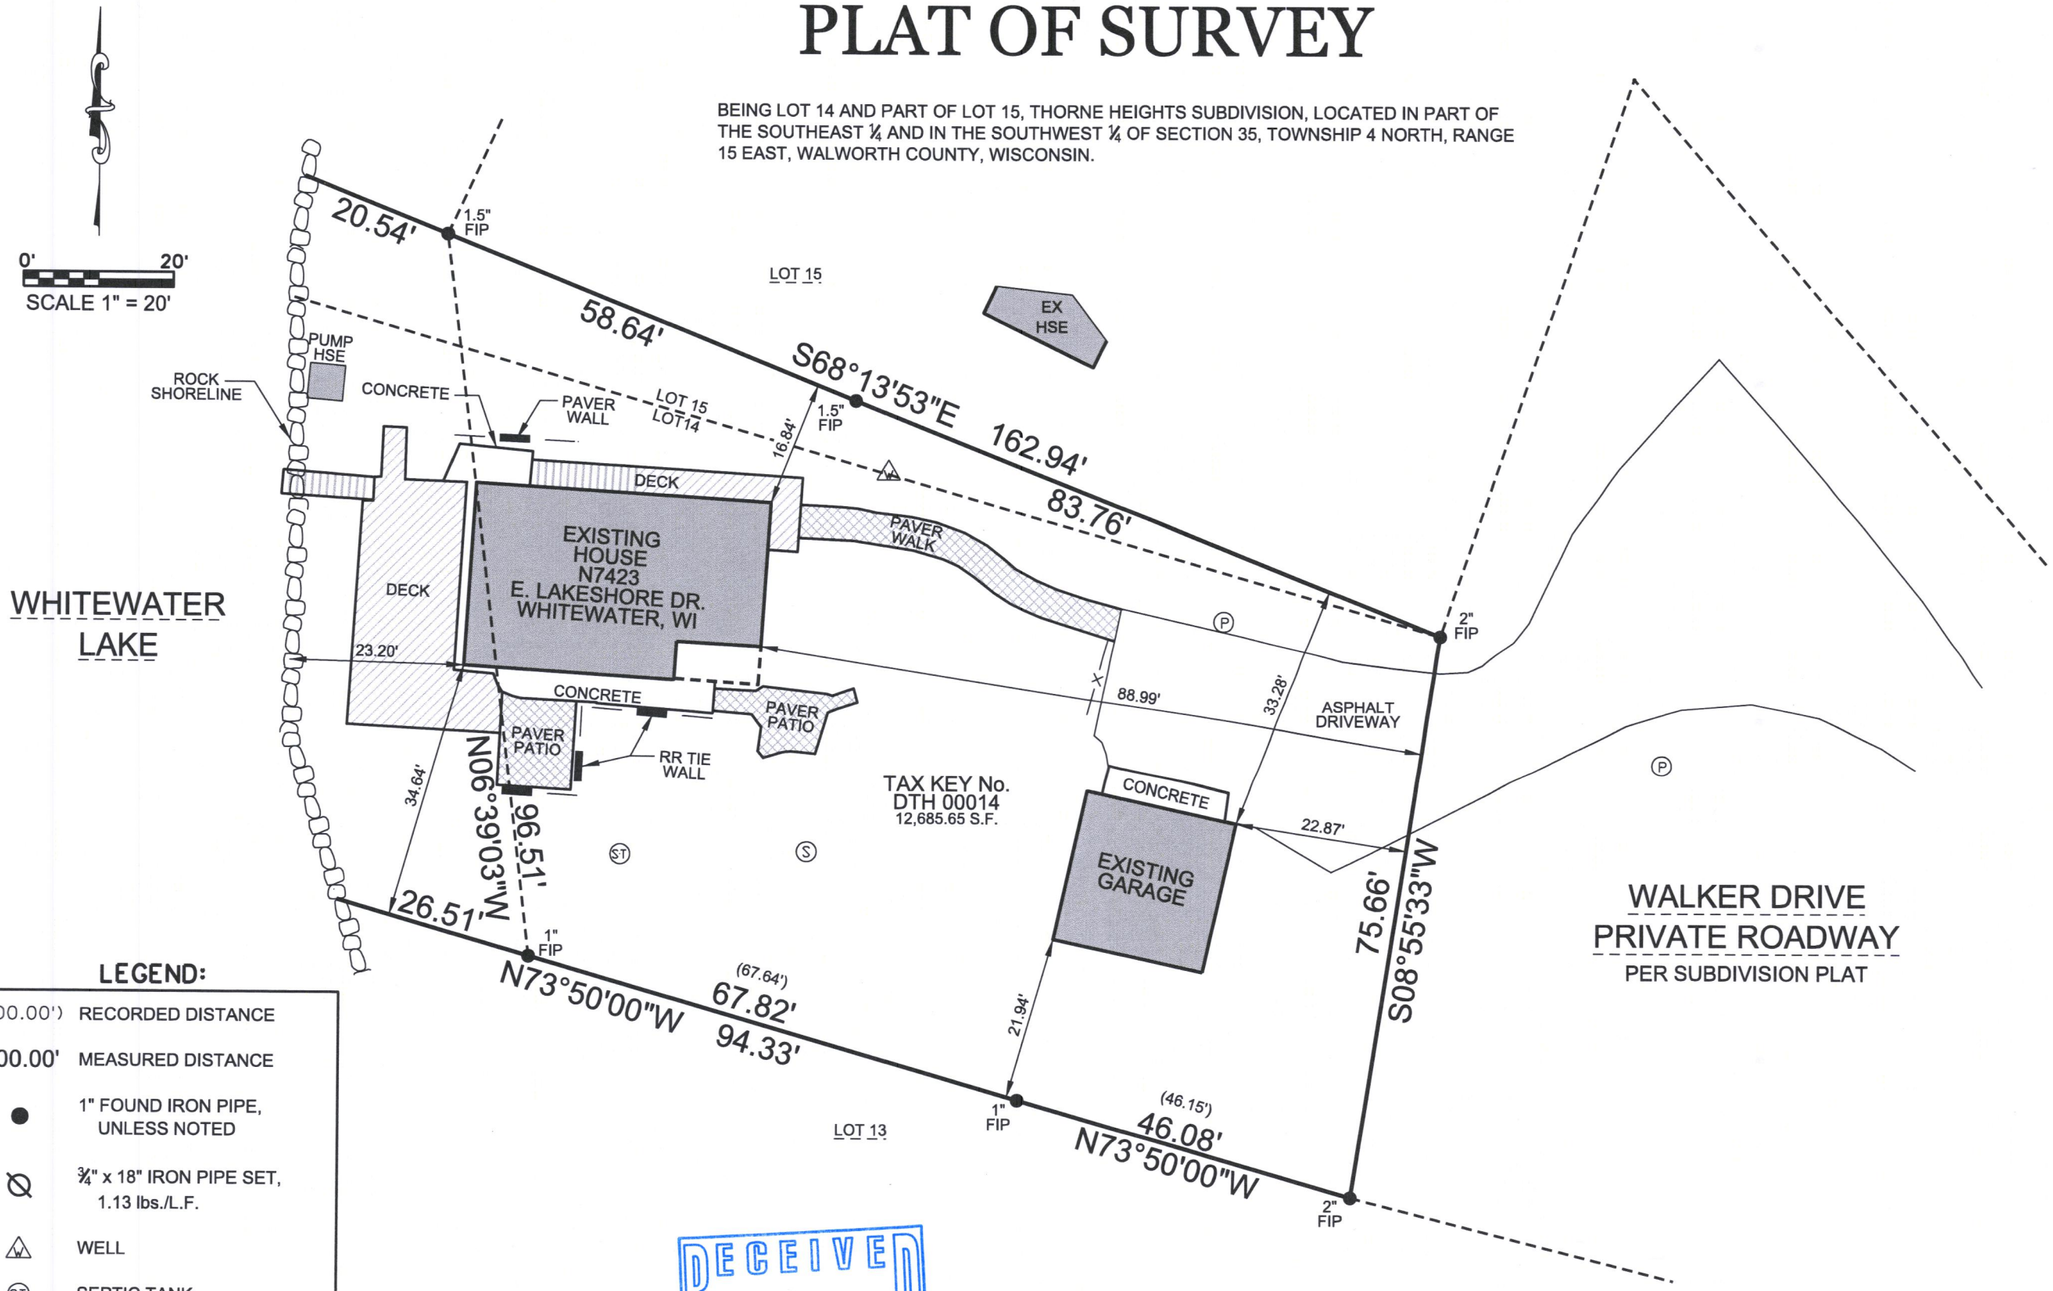

LEGEND:

(100.00')	RECORDED DISTANCE
100.00'	MEASURED DISTANCE
●	1" FOUND IRON PIPE, UNLESS NOTED
⌀	¾" x 18" IRON PIPE SET, 1.13 lbs./L.F.
⚠	WELL
(ST)	SEPTIC TANK
(S)	SEPTIC VENT
(P)	POWER POLE

RECEIVED
OCT - 1 2020
By

WISCONSIN
Michael A. Greeson
S-2770
East Troy
Wis
LAND SURVEYOR

I, MICHAEL A. GREESON P.L.S. #2770, HEREBY CERTIFY THAT THIS SURVEY WAS DONE UNDER MY DIRECTION AND THAT THE ABOVE MAP IS A TRUE REPRESENTATION THEREOF AND SHOWS THE SIZE AND LOCATION OF THE PROPERTY, ITS EXTERIOR BOUNDARIES, THE LOCATION OF ALL VISIBLE STRUCTURES AND DIMENSIONS OF ALL PRINCIPAL BUILDINGS THEREON, BOUNDARY FENCES, APPARENT EASEMENTS, ROADWAYS AND VISIBLE ENCROACHMENTS, IF ANY.

THIS SURVEY IS MADE FOR THE USE OF THE PRESENT OWNERS OF THE PROPERTY, AND ALSO THOSE WHO PURCHASE, MORTGAGE OR GUARANTEE TITLE TO WITHIN ONE (1) YEAR FROM DATE HERETO.

SURVEY MADE FOR:
SALLIE AND GEORGE MEYER
14940 JUNOEAU BLVD.
ELM GROVE, WI 53122

DATE	ITEM
07/07/2020	ORIGINAL SURVEY

V2G SURVEYING, LLC
123 WOLF RUN - SUITE 4
MUKWONAGO, WI 53149
(262) 378-5097

FILE NAME: V2G PROJECTS?2-105 George and Sallie Meyer N7423 E Lakeshore Dr Town of Whitewater

PLOT DATE: 07/07/2020

V2G JOB#: 2020-105

DTH-14

415-1509