


PLAT OF SURVEY  
LOT 6 MORaine HEIGHTS SUBDIVISION

BEING PART OF THE SW 1/4 OF THE SW 1/4 OF SECTION 25, TOWN 4 NORTH, RANGE 15 EAST,  
TOWN OF WHITEWATER, WALWORTH COUNTY, WISCONSIN

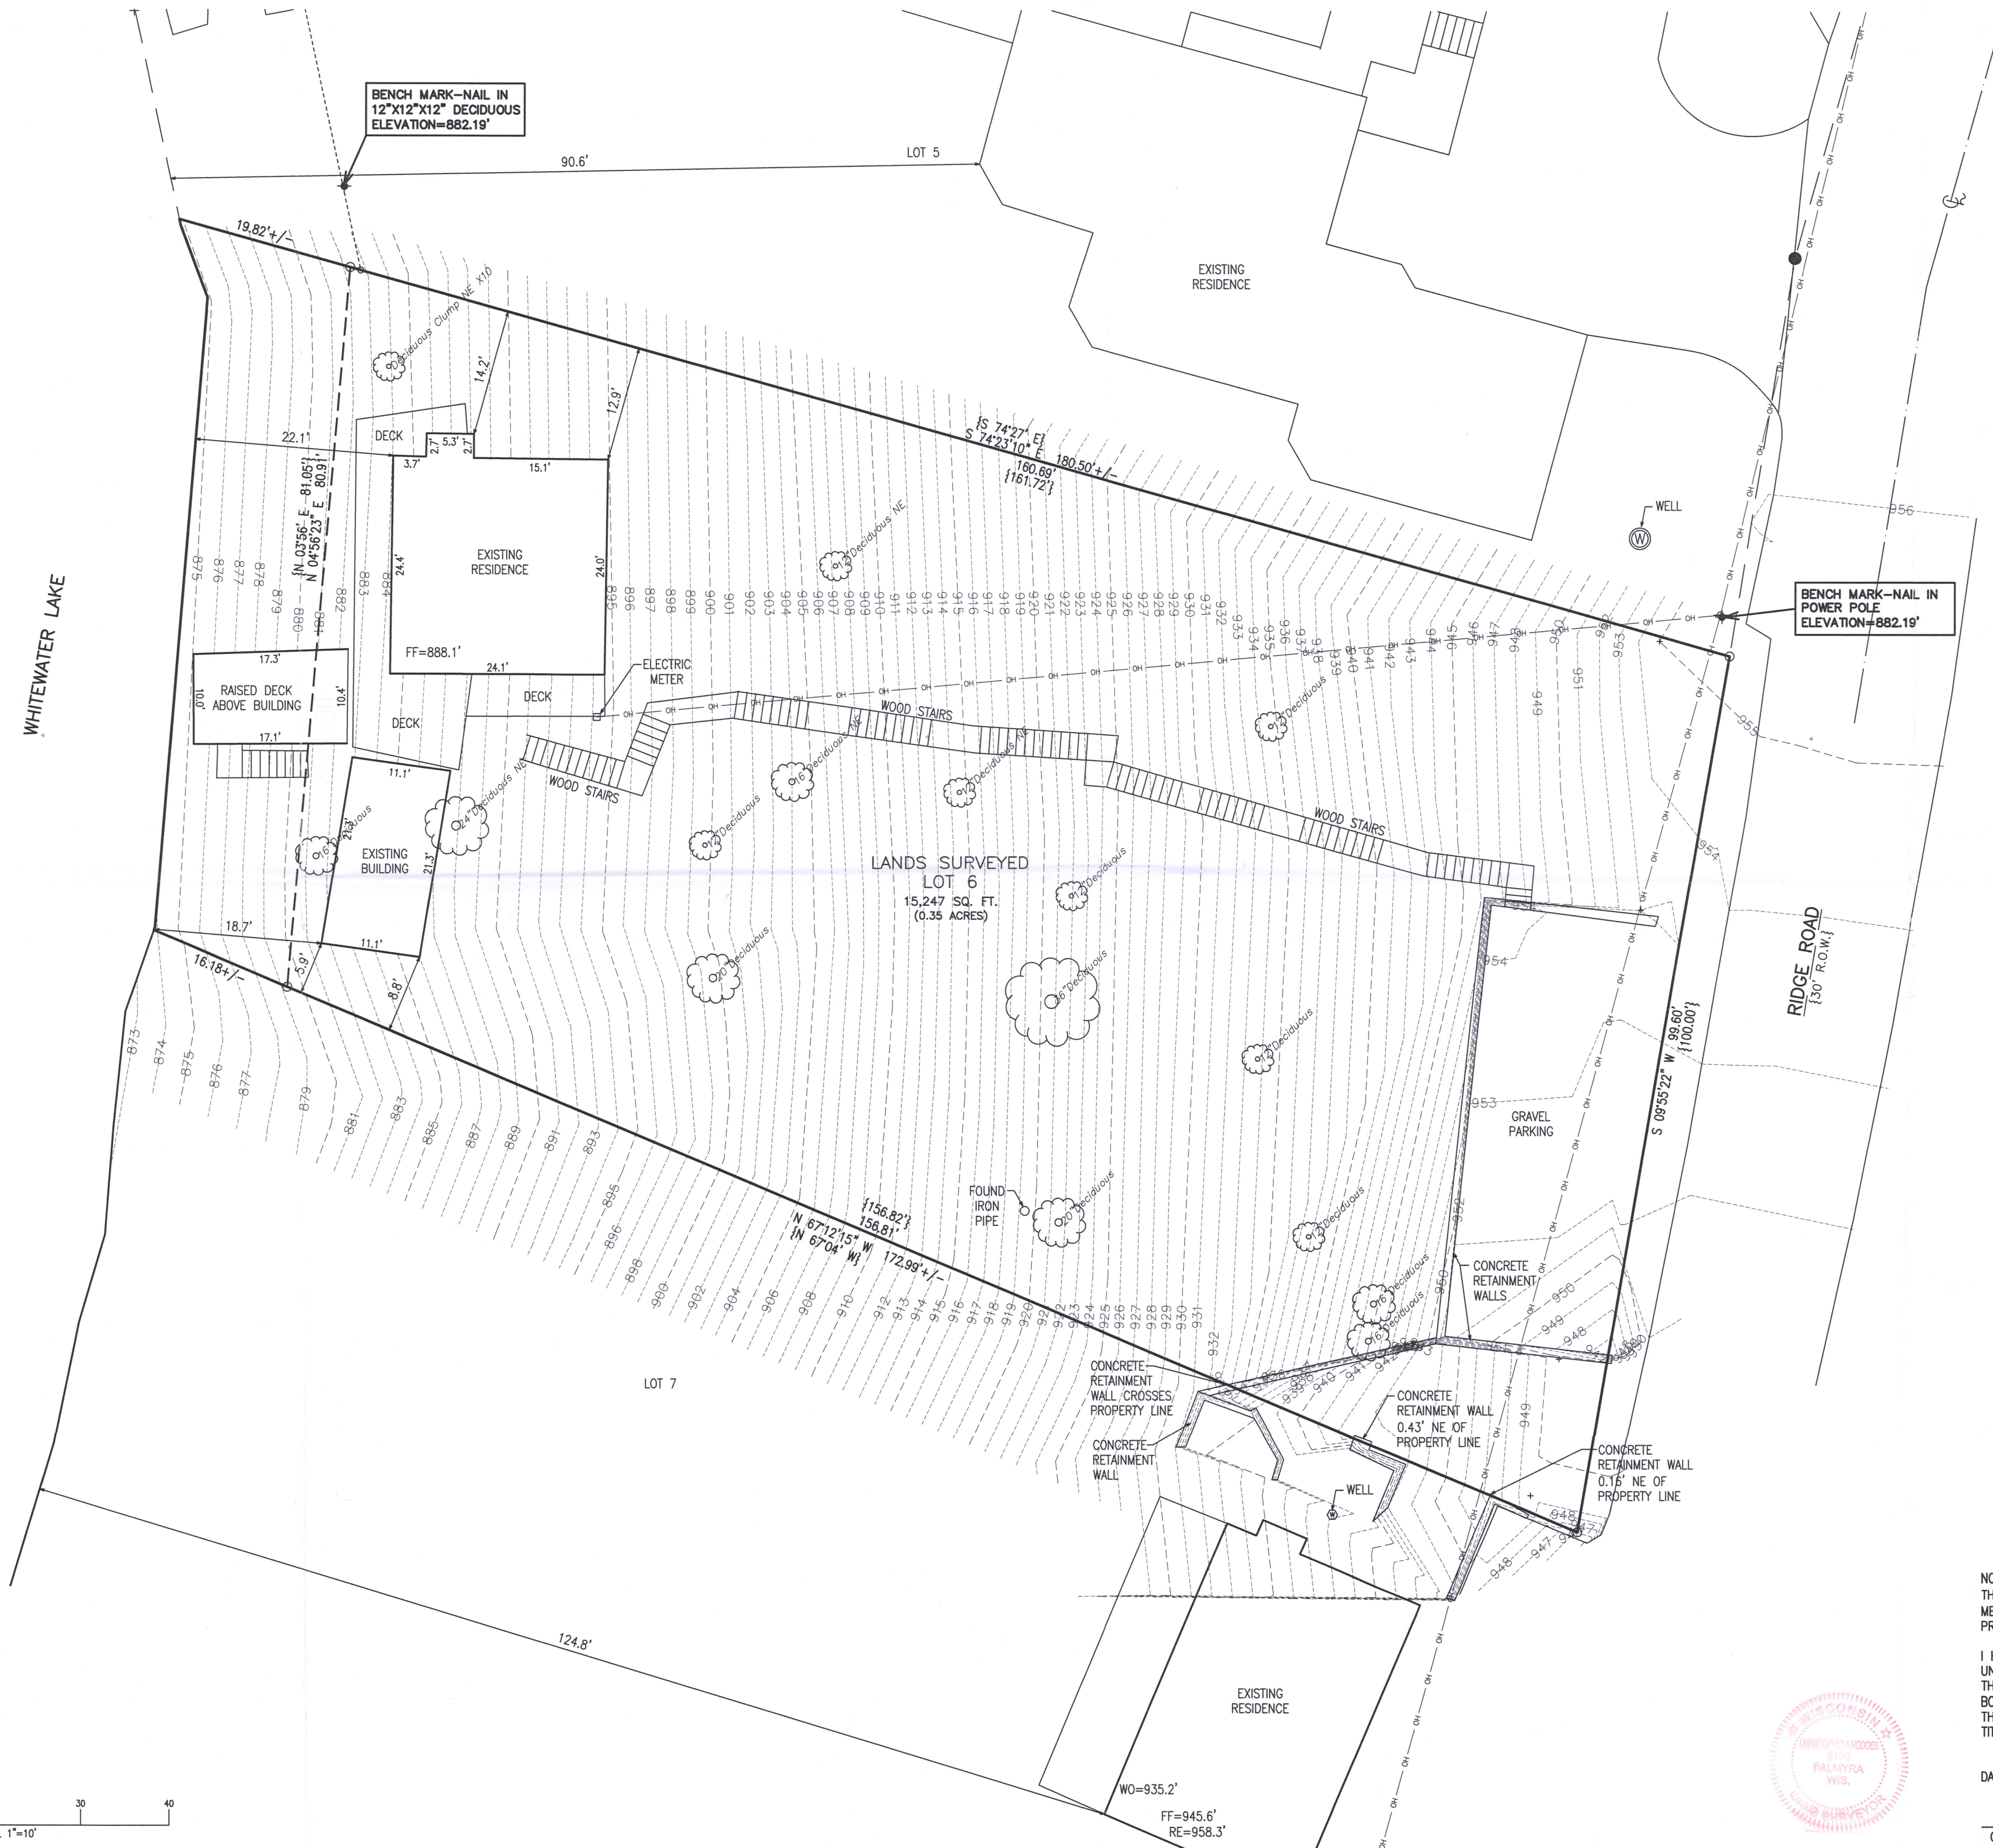

- LEGEND
- = IRON PIPE FOUND 1 3/8" O.D.
  - ◆ = BENCHMARK
  - ⊕ = UTILITY POLE
  - {xxx} = RECORDED AS
  - R.E. = TOP OF ROOF ELEVATION
  - F.F. = FIRST FLOOR ELEVATION
  - W.O. = LOWER LEVEL WALKOUT
  - OH— = OVERHEAD UTILITY WIRES
  - XXXX--- = EXISTING LAND CONTOURS


RECEIVED  
NOV 14 2022  
CH

NOTE: COPIES OF THIS MAP TO WHICH THE FOLLOWING CERTIFICATE WILL APPLY SHOW THE SURVEYOR'S ORIGINAL SEAL AND SIGNATURE IN RED INK. COPIES BY ANY OTHER MEANS MAY HAVE ALTERATIONS WHICH DO NOT REPRESENT THE SURVEYOR'S WORK PRODUCT.

I HEREBY CERTIFY THAT THE ABOVE DESCRIBED PROPERTY HAS BEEN SURVEYED UNDER MY DIRECTION AND THAT THE ABOVE MAP IS A TRUE REPRESENTATION THEREOF AND SHOWS THE SIZE AND LOCATION OF THE PROPERTY AND ITS EXTERIOR BOUNDARIES. THIS SURVEY IS MADE FOR THE USE OF THE PRESENT OWNERS OF THE PROPERTY, AND ALSO THOSE WHO PURCHASE, MORTGAGE, OR GUARANTEE THE TITLE THERETO WITHIN ONE YEAR FROM THE DATE HEREOF.

DATE: 10/06/2022

CHRISTOPHER A. HODGES P.L.S. 2760

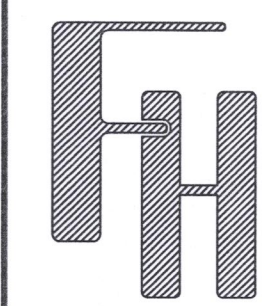

N7735 RIDGE ROAD  
PLAT OF SURVEY  
N7735 RIDGE ROAD - TOWN OF WHITEWATER

WORK ORDERED BY -  
THOMAS HANNON  
N7741 RIDGE ROAD  
WHITEWATER, WI

FARRIS, HANSEN & ASSOCIATES, INC.  
ENGINEERING - ARCHITECTURE - SURVEYING  
7 RIDGWAY COURT P.O. BOX 437  
ELKHORN, WISCONSIN 53121  
OFFICE: (262) 723-2098 FAX: (262) 723-5886

REVISIONS

PROJECT NO.  
10784

DATE  
10/06/2022

SHEET NO.  
1 OF 1

X:\Acad\_Std\Corison\TITLE BLOCKS\THA 24x36.dwg

MAP SCALE IN FEET - ORIGINAL 1"=10'

DM14-40

415-1588