
LAND-MARK SURVEYING
Mark L. Miritz
Wisconsin Professional Land Surveyor S-2582

N9330 Knuteson Drive
Whitewater, WI 53190
Phone:(262)495-3284
MARKMIRITZ@
LAND-MARKSURVEYING.COM

PLAT OF SURVEY

LOT 10, BLOCK 4, GRAND VIEW SUBDIVISION LOCATED IN THE SOUTHEAST 1/4 OF SECTION 34, TOWN 4 NORTH, RANGE 15 EAST, TOWN OF WHITEWATER, WALWORTH COUNTY, WISCONSIN.

OWNERS:
JAMES A. ZAJAC
MARY L. ZAJAC
4106 FLORENCE AVE.
DOWNERS GROVE, IL 60515

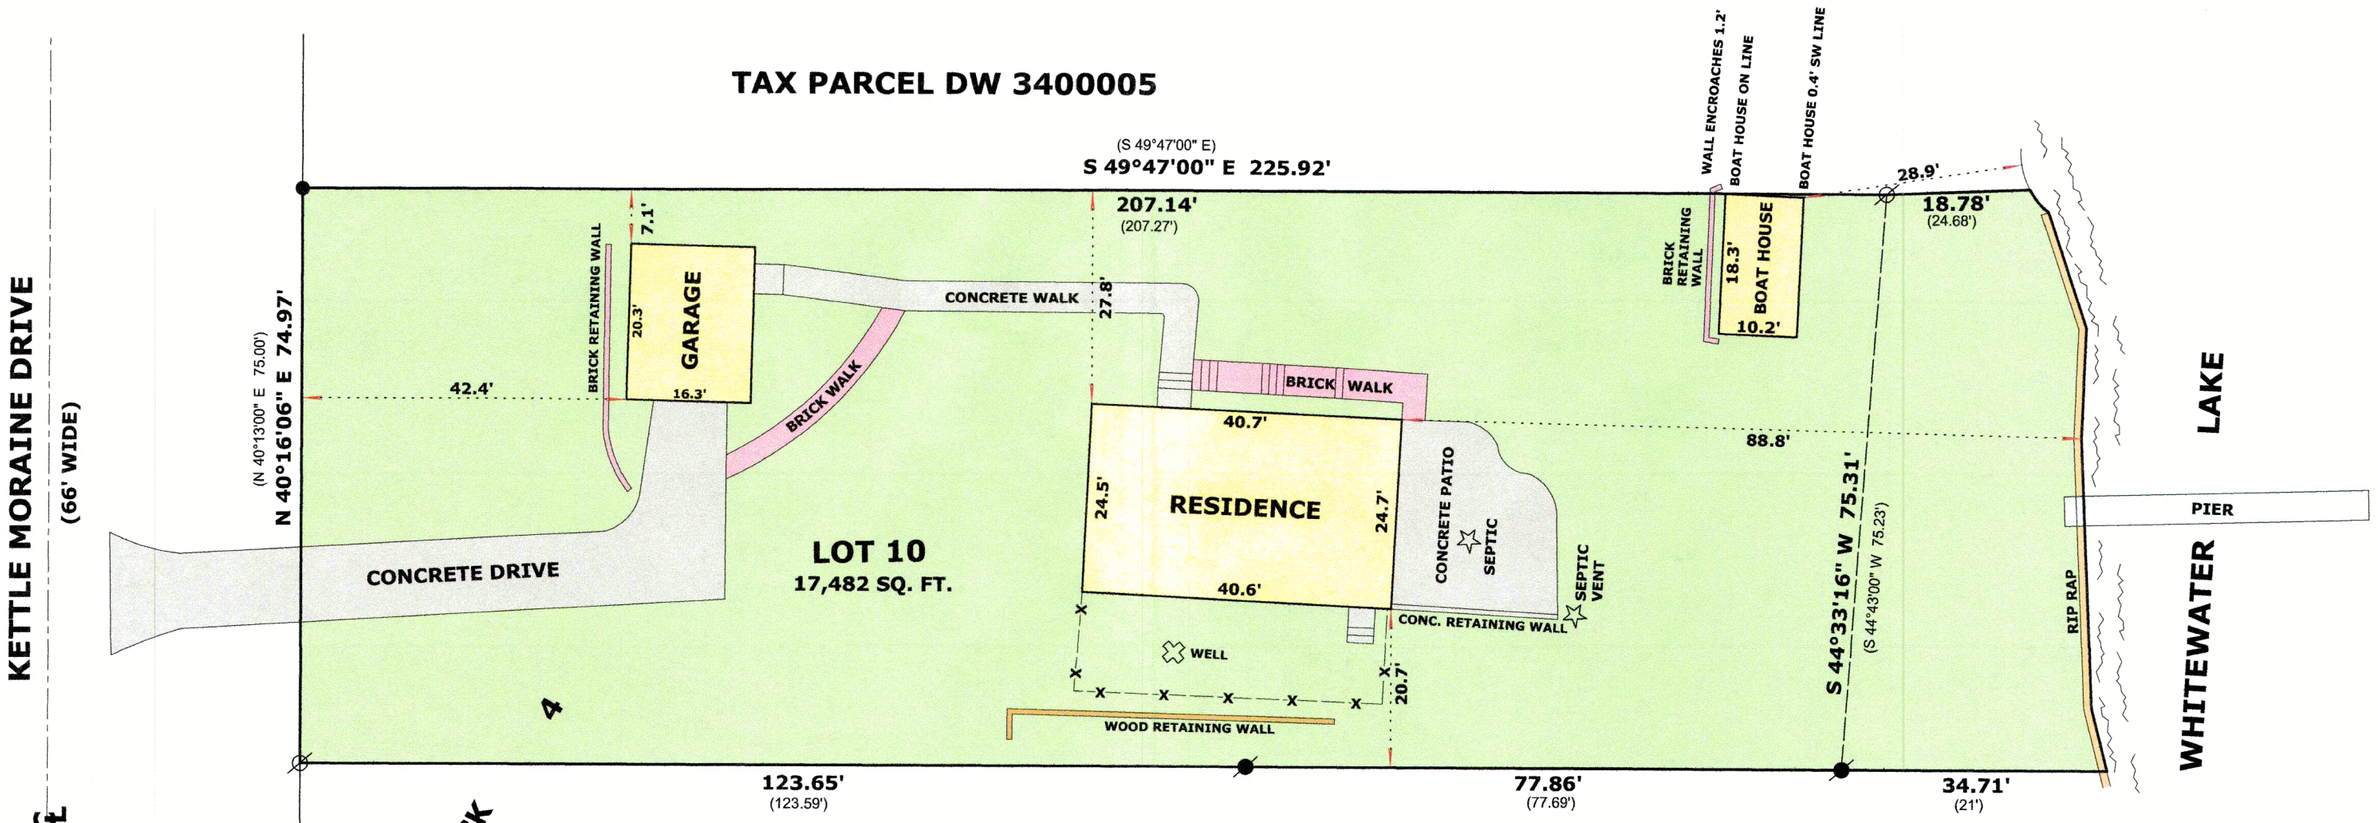

LEGEND

- ⌀ FOUND IRON PIPE 2"
- ● FOUND IRON PIPE 1 1/4"
- ● FOUND IRON ROD 3/4"
- (x x) RECORDED AS DIMENSION
- —x—x— EXISTING CHAIN LINK FENCE

SCALE: 1 INCH = 20 FEET

"I hereby certify that the above described property has been surveyed by me or under my direction and that the above map is a true representation thereof and shows the size and location of the property, its exterior boundaries, the location of all visible structures and dimensions of all principal buildings thereon, boundary fences, apparent easements, roadways and visible encroachments, if any."
"This survey is made for the use of the present owners of the property, and also those who purchase, mortgage, or guarantee the title thereto within one year from date hereof."

Mark L. Miritz

MARK L. MIRITZ
WISCONSIN PROFESSIONAL
LAND SURVEYOR S-2582

DATE: MAY 17, 2023 **JOB NO.** 23.503

RECEIVED
SEP 20 2023
By

WISCONSIN
MARK L. MIRITZ
S-2582
WHITEWATER, WI
LAND SURVEYOR

DGD-58

415-1619