

HAROLD H. KOLB


REGISTERED PROFESSIONAL LAND SURVEYOR
LAKE GENEVA, WISCONSIN

PLAT OF SURVEY OF

Lots 18-23, Block 1, Indian Trail
Subdivision, T4N, R15E, Walworth
County, Wisconsin.

NOTE: This is a lot line adjustment.

OWNER: Vern Ludtke

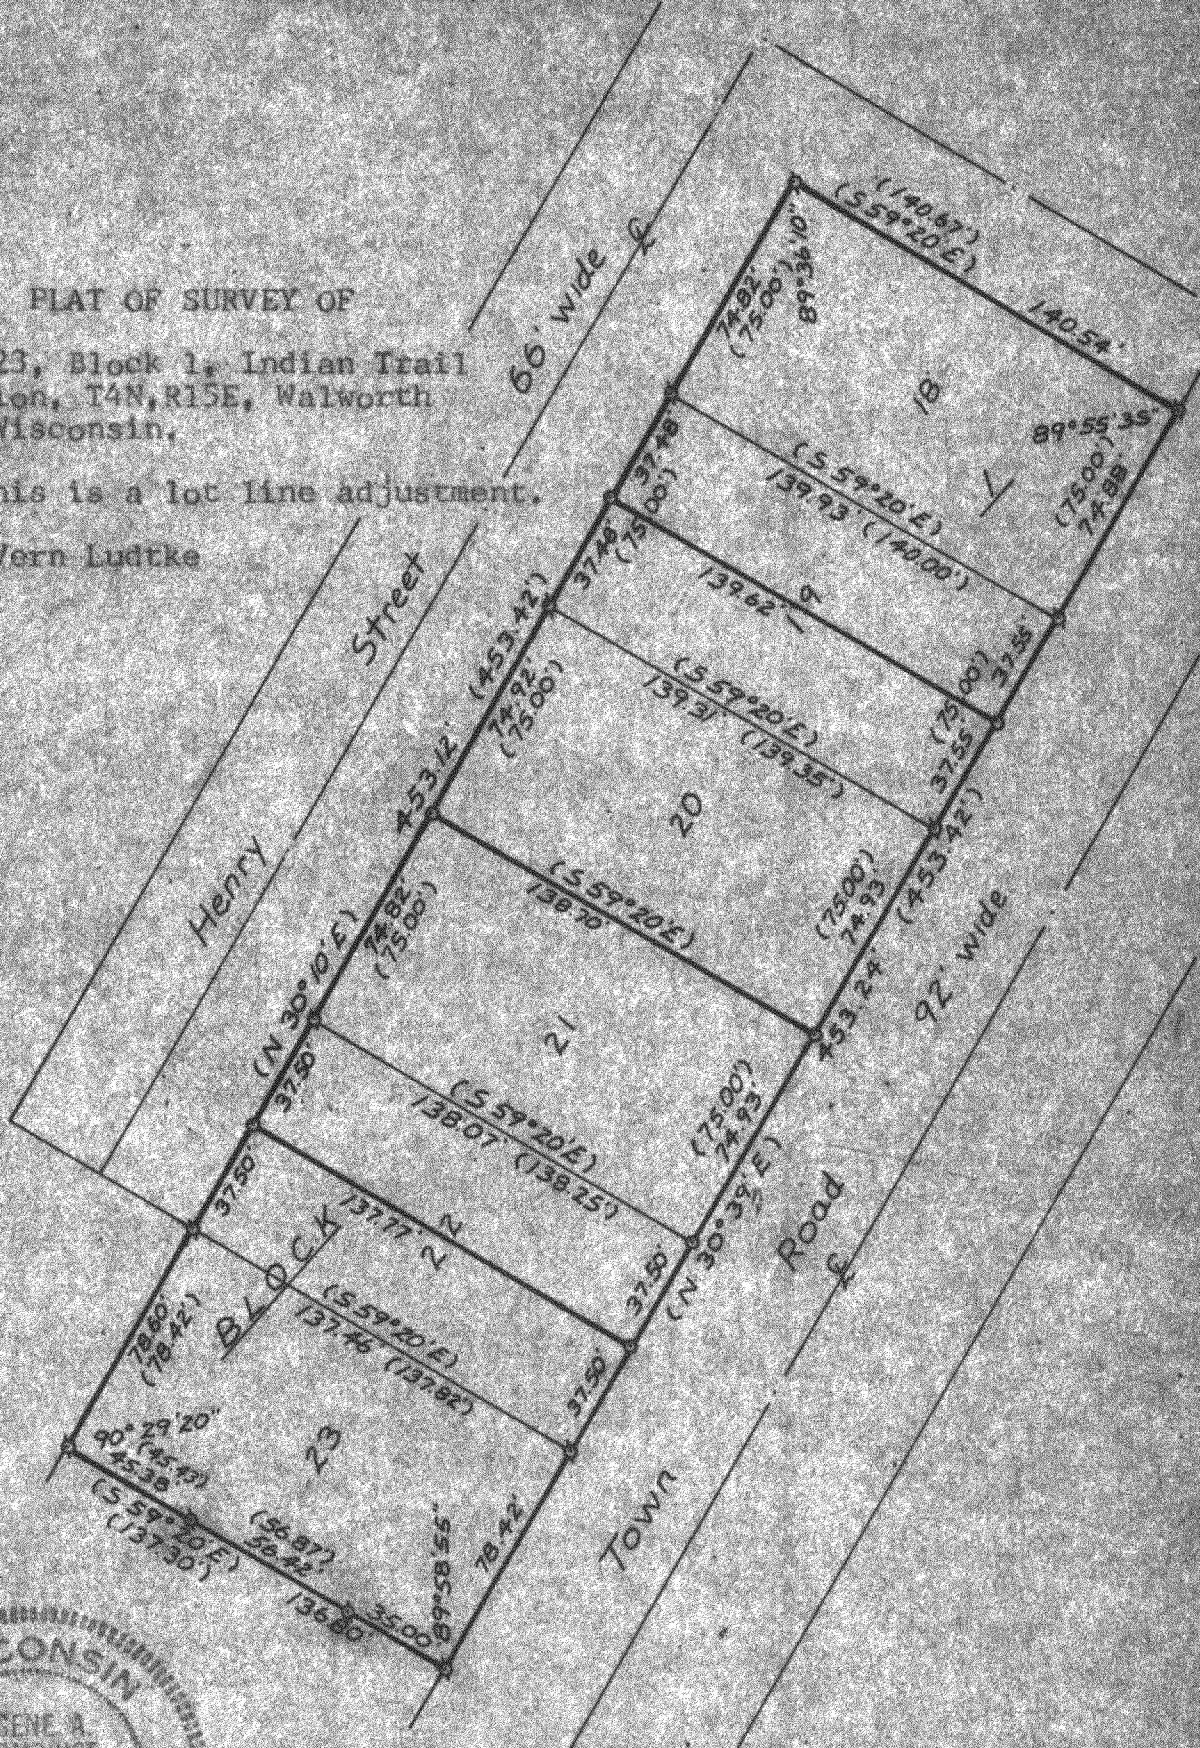

Scale 1" = 60'

LEGEND

- O — IRON PIPE PLACED, 1" x 24" 1.13 LB./LIN. FT.
- — CONCRETE MONUMENT, 5" DIA. x 30"
- ⊘ — Iron Pipe Found () — As Platted

I, Eugene A. Blomquist, do hereby certify
that I have surveyed the property hereon
described according to the official records
and that the plat hereon is a correct re-
presentation of the lot lines.

Eugene A. Blomquist
Eugene A. Blomquist

WISCONSIN REGISTERED LAND SURVEYOR, S-1279

DATE Sept 1, 1977

415-191