
DUNHAM SURVEYING, S. C.
SURVEYING & SUBDIVIDING
DELAVAN, WISCONSIN 53115

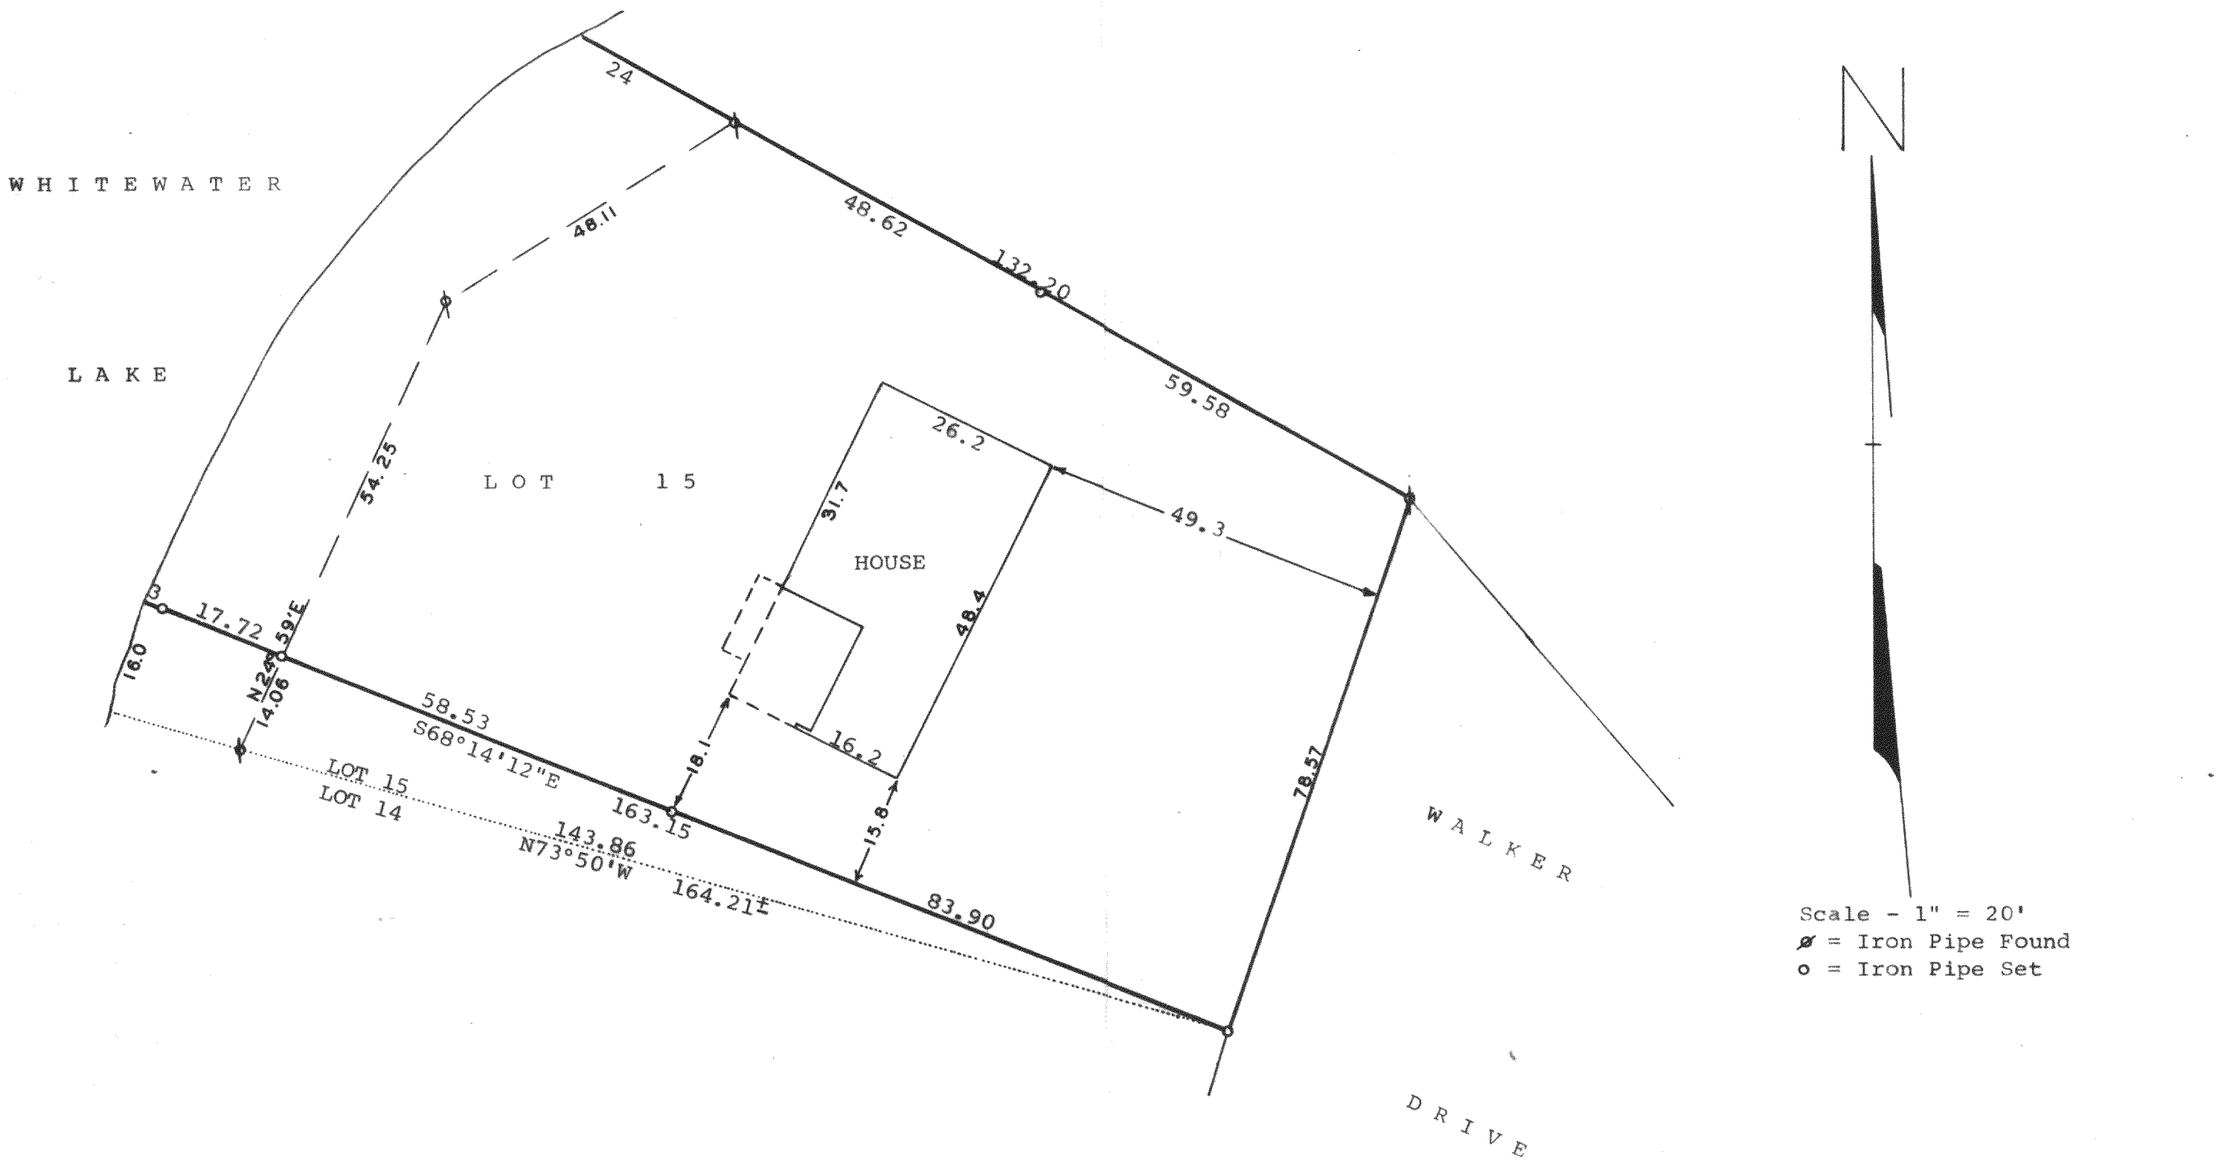

STATE OF WISCONSIN)
COUNTY OF WALWORTH) SS

I, George T. Dunham, Surveyor, certify that I have surveyed the property described as follows,

Lot 15 of Thorne Heights, a subdivision located in Section 35, T 4 N, R 15 E, Walworth County, Wisconsin, EXCEPT therefrom beginning at the southeast corner of said Lot 15; thence N73°-50'W along the south line of said Lot, 164.21 feet more or less to the shore of Whitewater Lake; thence Northerly along the shore of Whitewater Lake 16.0 feet; thence Southeasterly to the place of beginning,

and that the above map is a true representation thereof and shows the size and location of the property, its exterior boundaries, the location of all visible structures and dimensions of all principal buildings thereon, boundary fences, apparent easements, roadways and visible encroachments, if any. This survey is made for the use of the present owners of the property, and also those who purchase, mortgage, or guarantee the title thereto within one (1) year from date hereof.

September 2, 1981

George T. Dunham, Surveyor

WISCONSIN
GEORGE T. DUNHAM
DELAVAN, WIS.
LAND SURVEYOR

DTH -15

K & E 10-9155