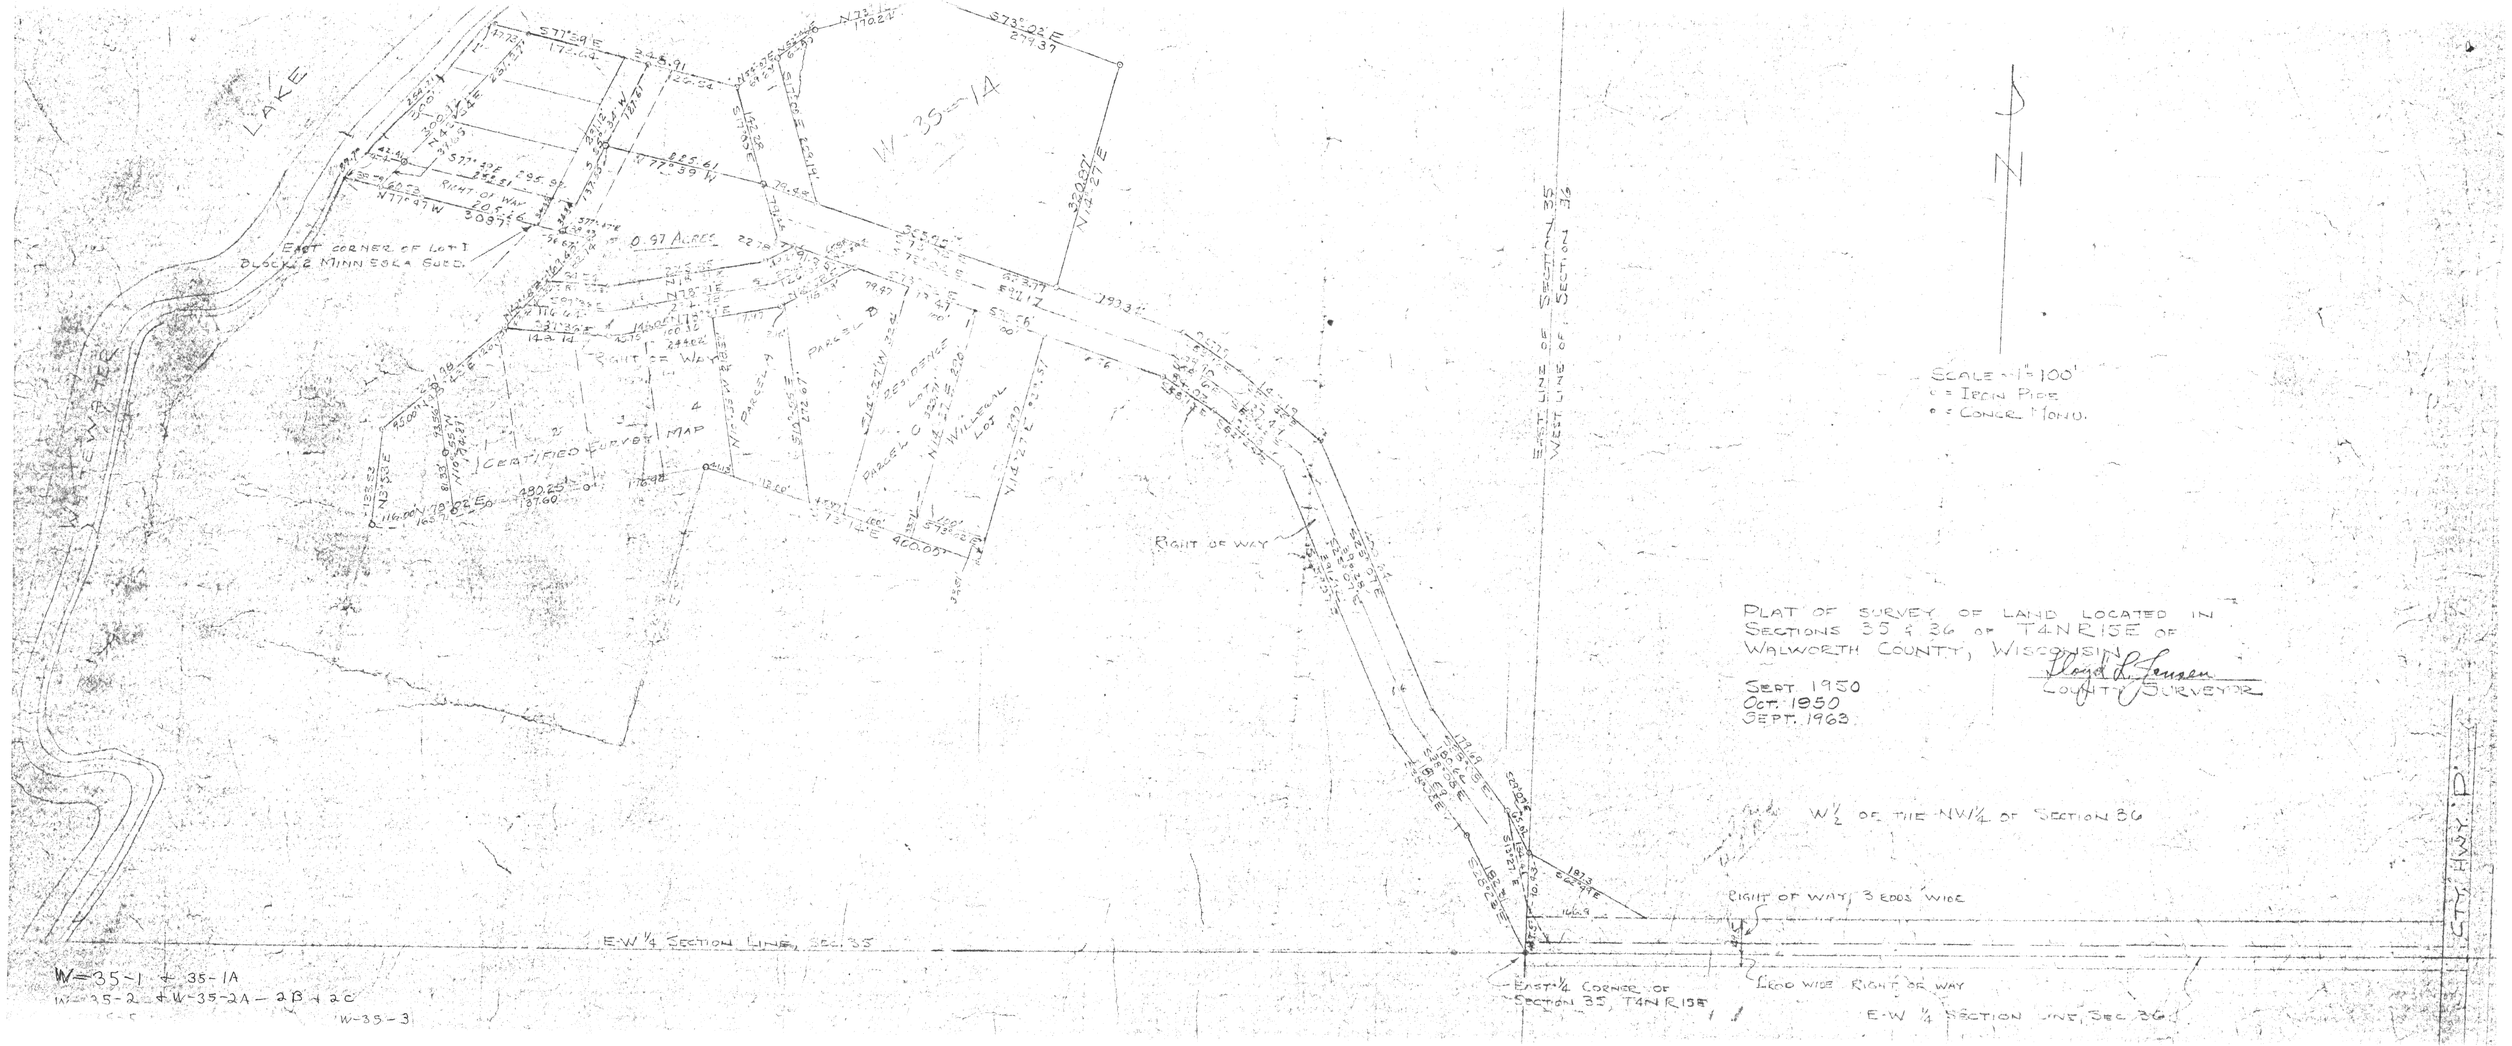
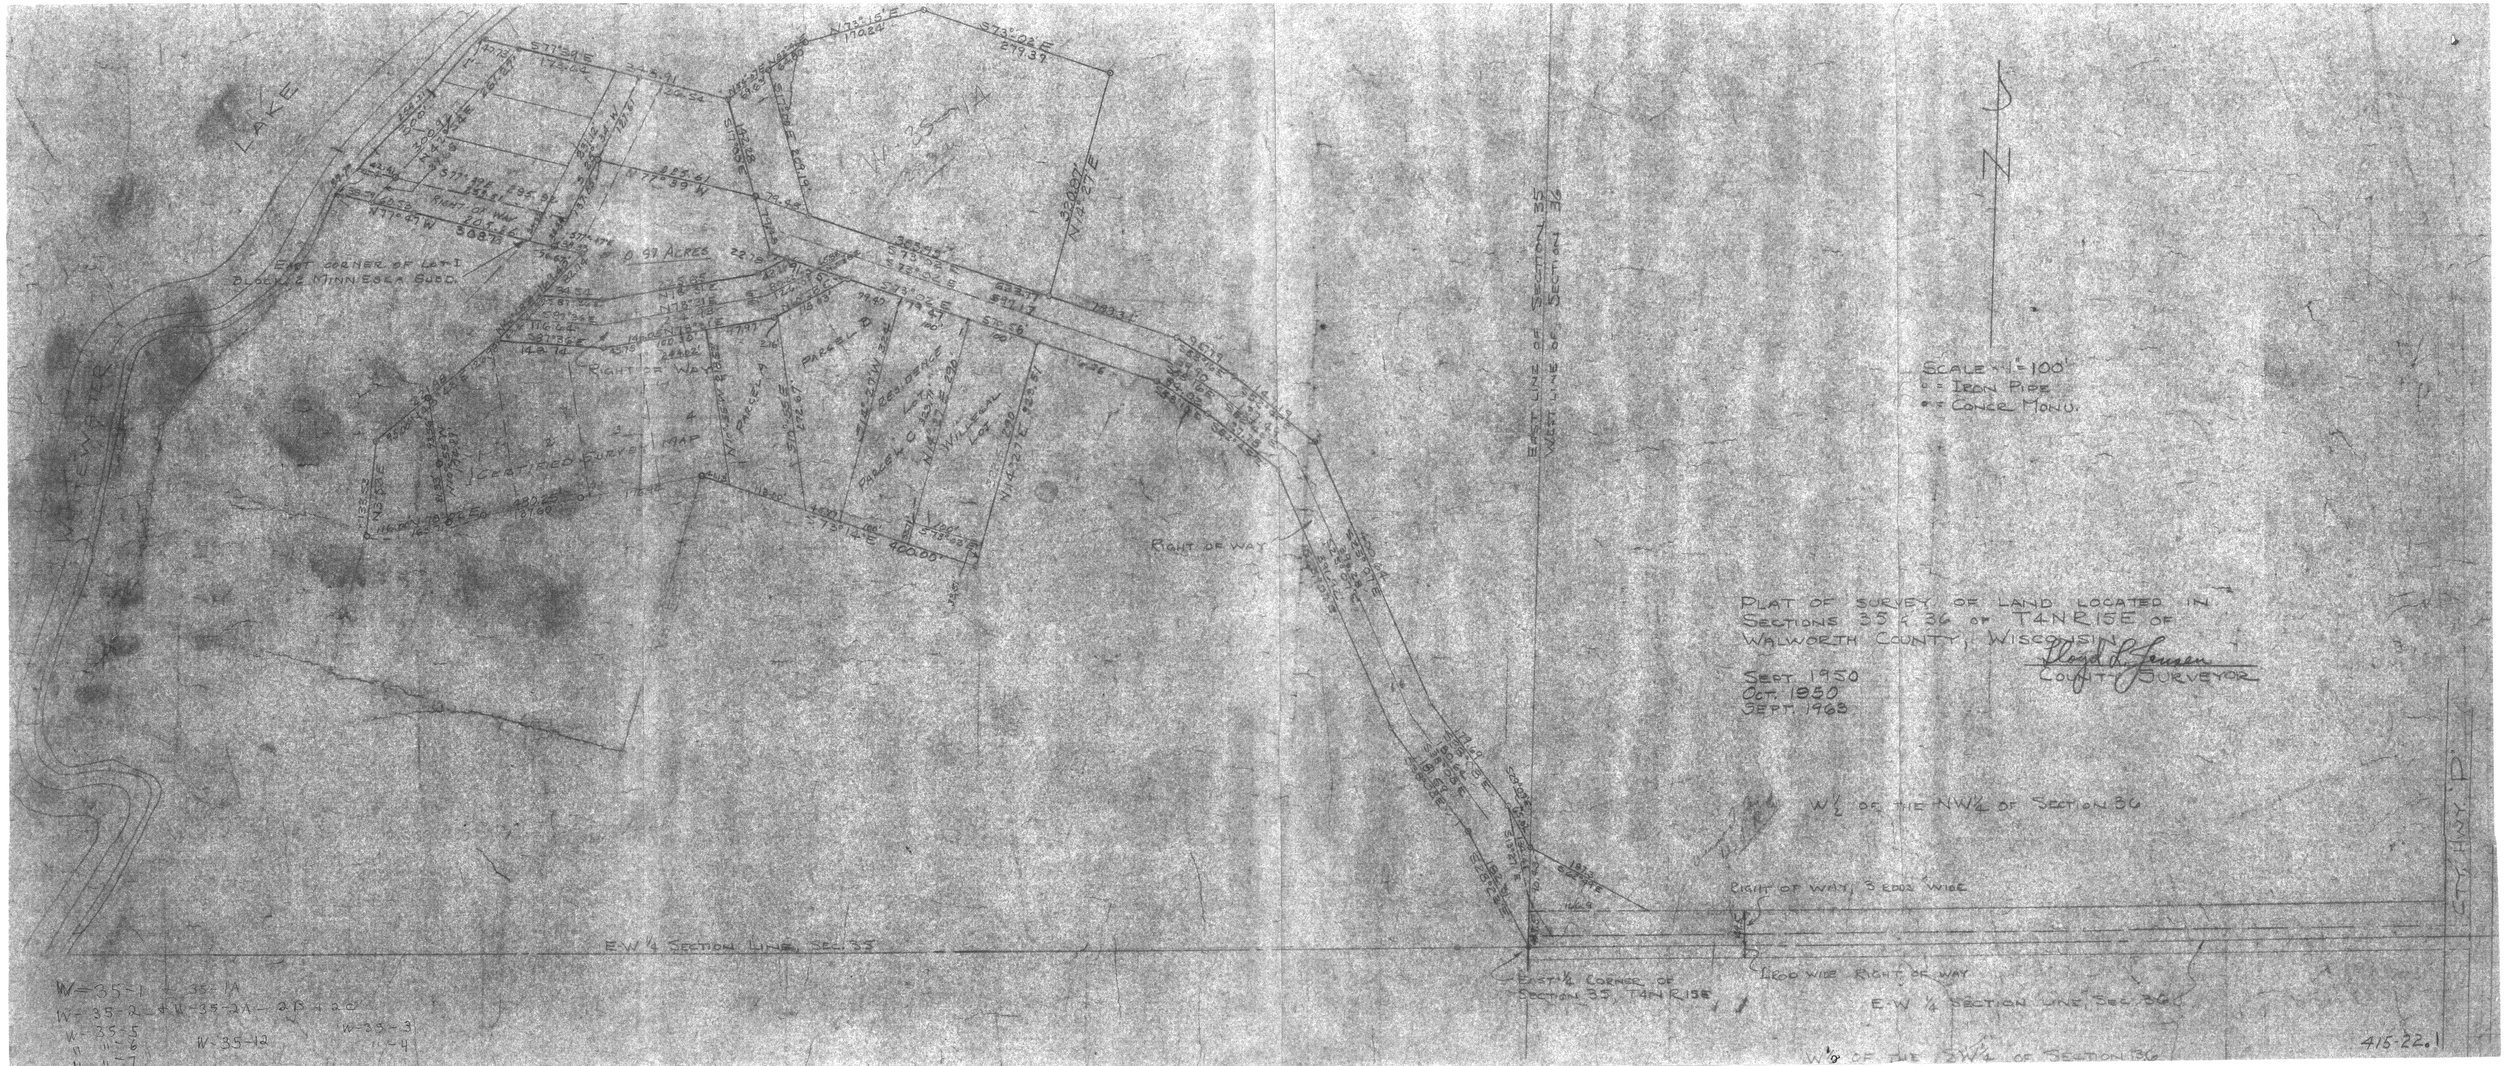


PLAT OF SURVEY OF LAND LOCATED IN SECTIONS 35 & 36 OF T4N R15E OF WALWORTH COUNTY, WISCONSIN

Floyd D. Jensen
COUNTY SURVEYOR

SEPT. 1950
OCT. 1950
SEPT. 1963


LAKE
EAST CORNER OF LOT 1 BLOCK 2 MINNESOTA SUBD.
0.97 ACRES
PARCEL A
PARCEL B
PARCEL C
RIGHT OF WAY
E-W 1/4 SECTION LINE, SEC. 35
SCALE 1" = 100'
= IRON PIPE
= CONCR. MONU.
PLAT OF SURVEY OF LAND LOCATED IN SECTIONS 35 & 36 OF T4N R15E OF WALWORTH COUNTY, WISCONSIN
SEPT. 1950
OCT. 1950
Lloyd A. Jensen
COUNTY SURVEYOR
W½ OF THE NW¼ OF SECTION 36
RIGHT OF WAY, 3 RODS WIDE
E-W ¼ SECTION LINE, SEC. 36
W½ OF THE SW¼ OF SECTION 36
EAST ¼ CORNER OF SECTION 35, T4N R15E
W=35-1
W=35-1A
W=35-2
W=35-2A
W=35-2B
W=35-3
W=35-4
W=35-5
W=35-6
W=35-7
W=35-12
415-22.1