Plat of Survey

Survey For: First State Savings of Wisconsin
Location: 5412 Lower Ridge Road

Description: LOT 1 in BLOCK 1 in "MOLAINE HEIGHTS SUBDIVISION", located in the S.W. 1/4 of the S.E. 1/4 of Section 26, and the S.E. 1/4 of Section 35, and the N.E. 1/4 of Section 2, and the S.E. 1/4 of Section 35, T. 1 N., R. 15 E., Walworth County, as recorded in the Register of Deeds office in and for the County of Walworth, on the 20th day of October, 1918. Vol. 12 of Plts on page 19, 20 and 21.

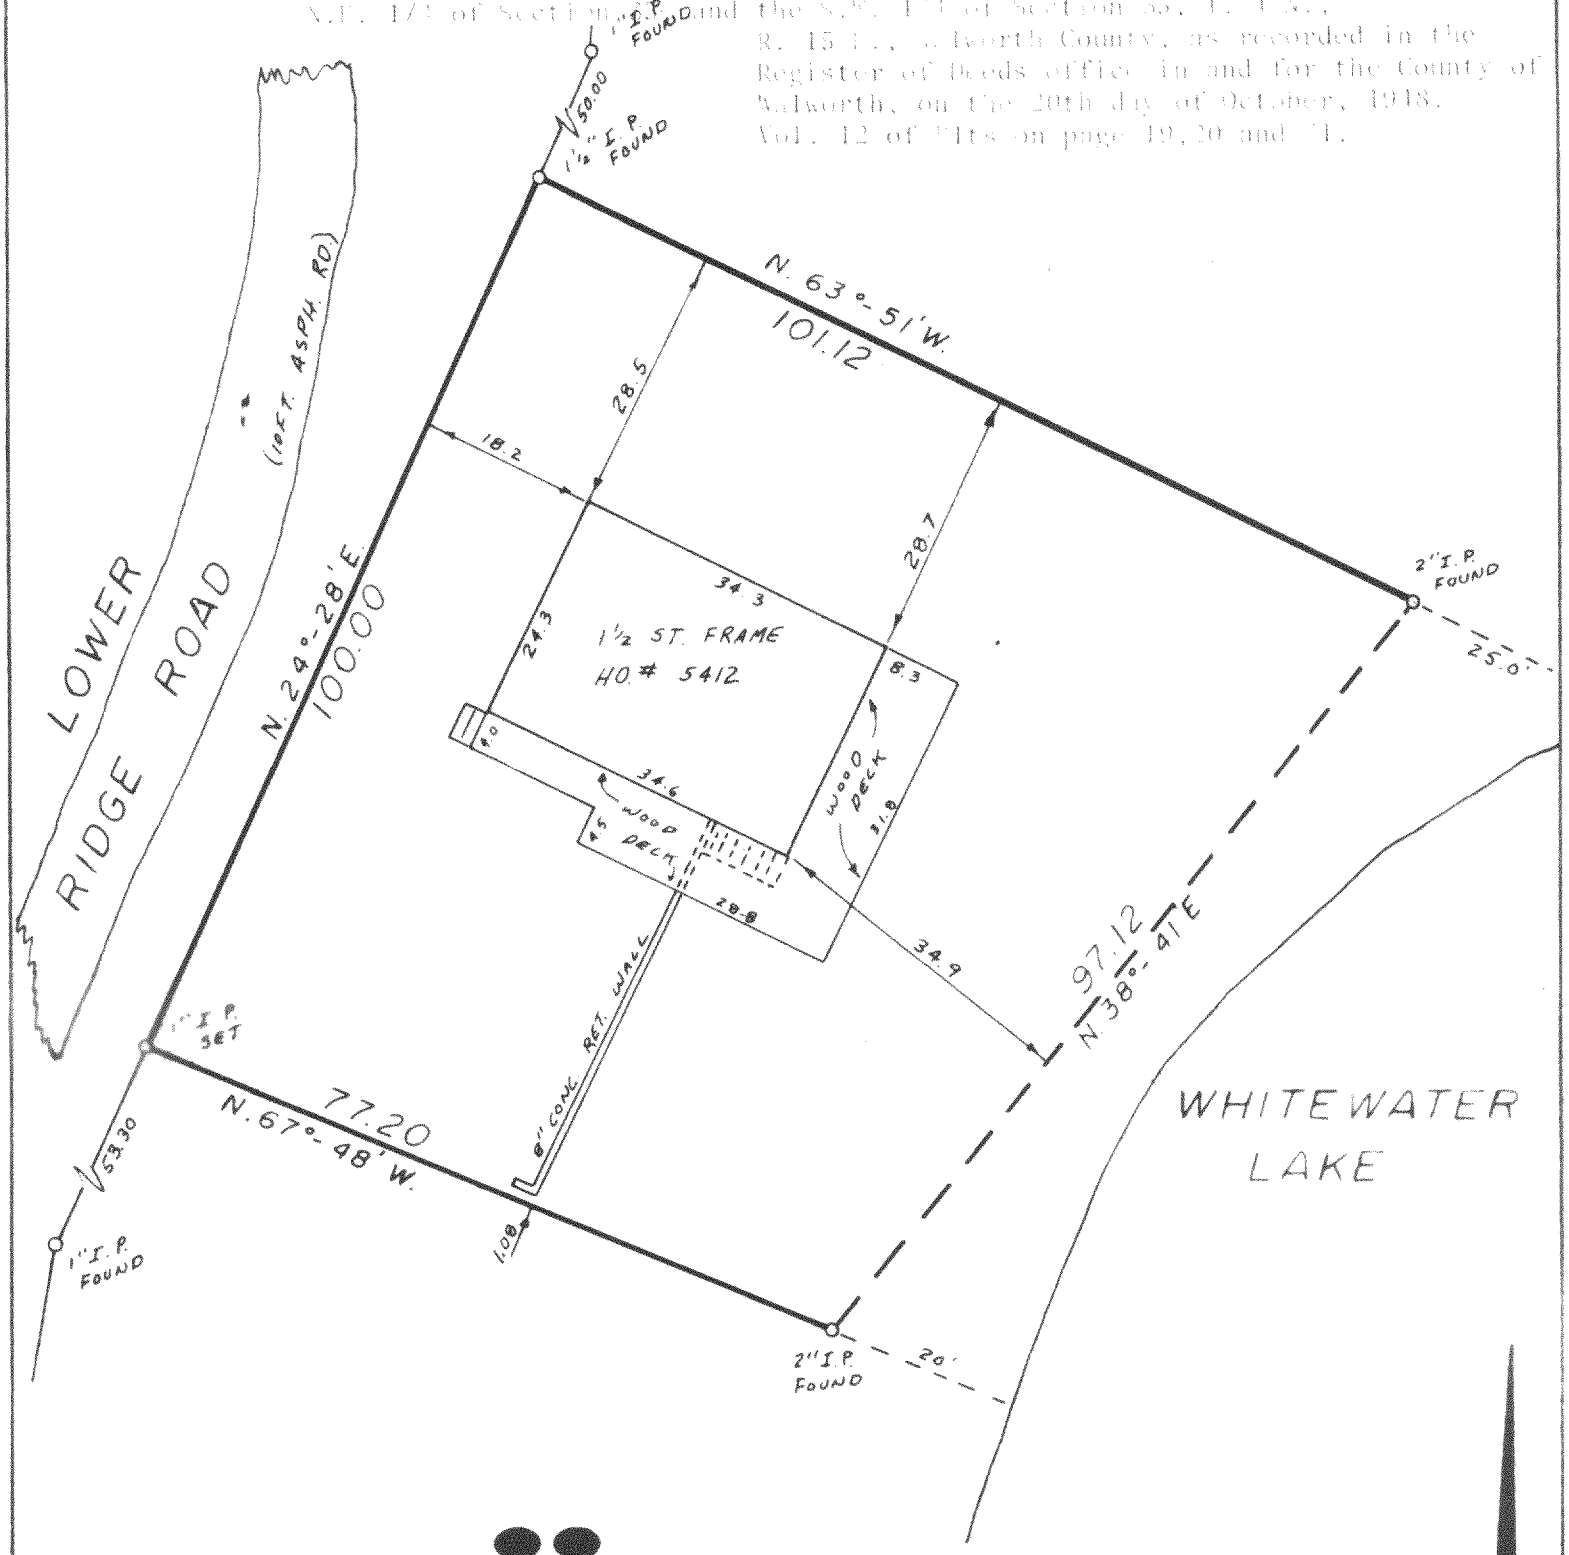

WISCONSIN
THOMAS INMAN
S-959
MILWAUKEE, WIS.
LAND SURVEYOR

INMAN SURVEY

Scale 1" = 20'

WEST OFFICE:
P.O. BOX 286
EAST TROY, WI 53120
(414) 642-3113

EAST OFFICE
11221 W. FOREST HOME AVE
MILWAUKEE, WI 53130
(414) 425-2060

SURVEY CERTIFICATE

State of Wisconsin)
Milwaukee County ss I certify that I have surveyed the above described (property) and the above map is a true representation thereof and shows the size and location of the Property, its exterior boundaries, the location and dimensions of all visible structures thereon, fences, apparent easements and roadways and visible encroachments, if any.

This survey is made for the exclusive use of the present owners of the Property, and also those who purchase, mortgage, or guarantee the title thereto within one (1) year from date hereof;

Thomas Inman

THOMAS INMAN, Registered Land Surveyor

DATE: 11-30-82
JOB NO.: 9987

DMH-4

Plat of Survey

Survey For: First State Savings of Wisconsin
Location: 5412 Lower Ridge Road



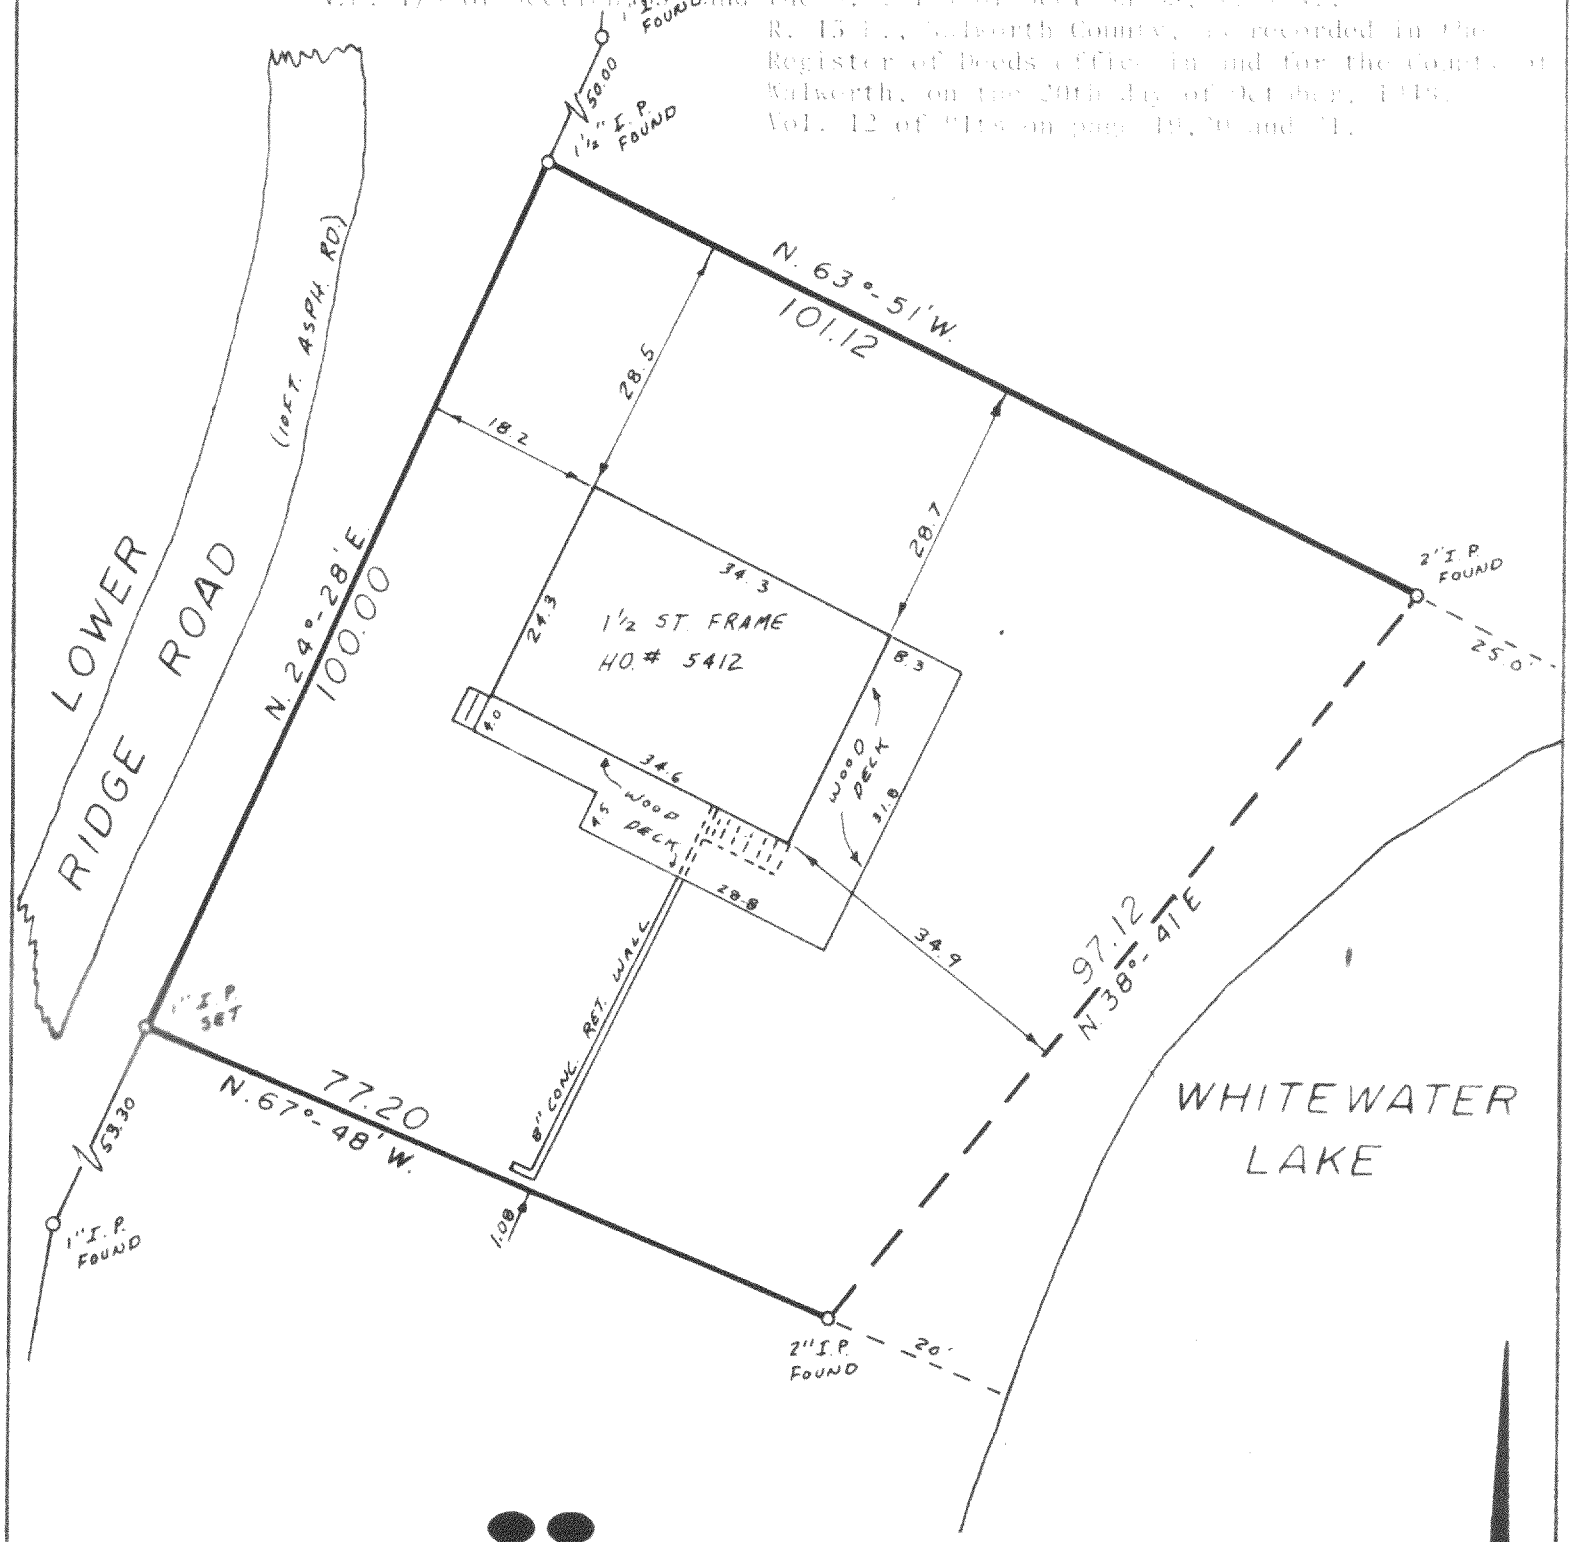

WISCONSIN
THOMAS INMAN
S-959
MILWAUKEE, WIS.
LAND SURVEYOR

INMAN SURVEY

Scale 1" = 20'

WEST OFFICE:
P.O. BOX 286
EAST TROY, WI 53120
(414) 642-3113

EAST OFFICE:
11221 W. FOREST HOME AVE
MILWAUKEE, WI 53130
(414) 425-2060

SURVEY CERTIFICATE

State of Wisconsin) ss
Milwaukee County

I certify that I have surveyed the above described (property) and the above map is a true representation thereof and shows the size and location of the Property, its exterior boundaries, the location and dimensions of all visible structures thereon, fences, apparent easements and roadways and visible encroachments, if any.

This survey is made for the exclusive use of the present owners of the Property, and also those who purchase, mortgage, or guarantee the title thereto within one (1) year from date hereof.

Thomas Inman

THOMAS INMAN, Registered Land Surveyor

DATE: 11-30-82
JOB NO.: 9987

Plat of Survey

Survey For: First State Savings of Wisconsin
Location: 5412 Lower Ridge Road


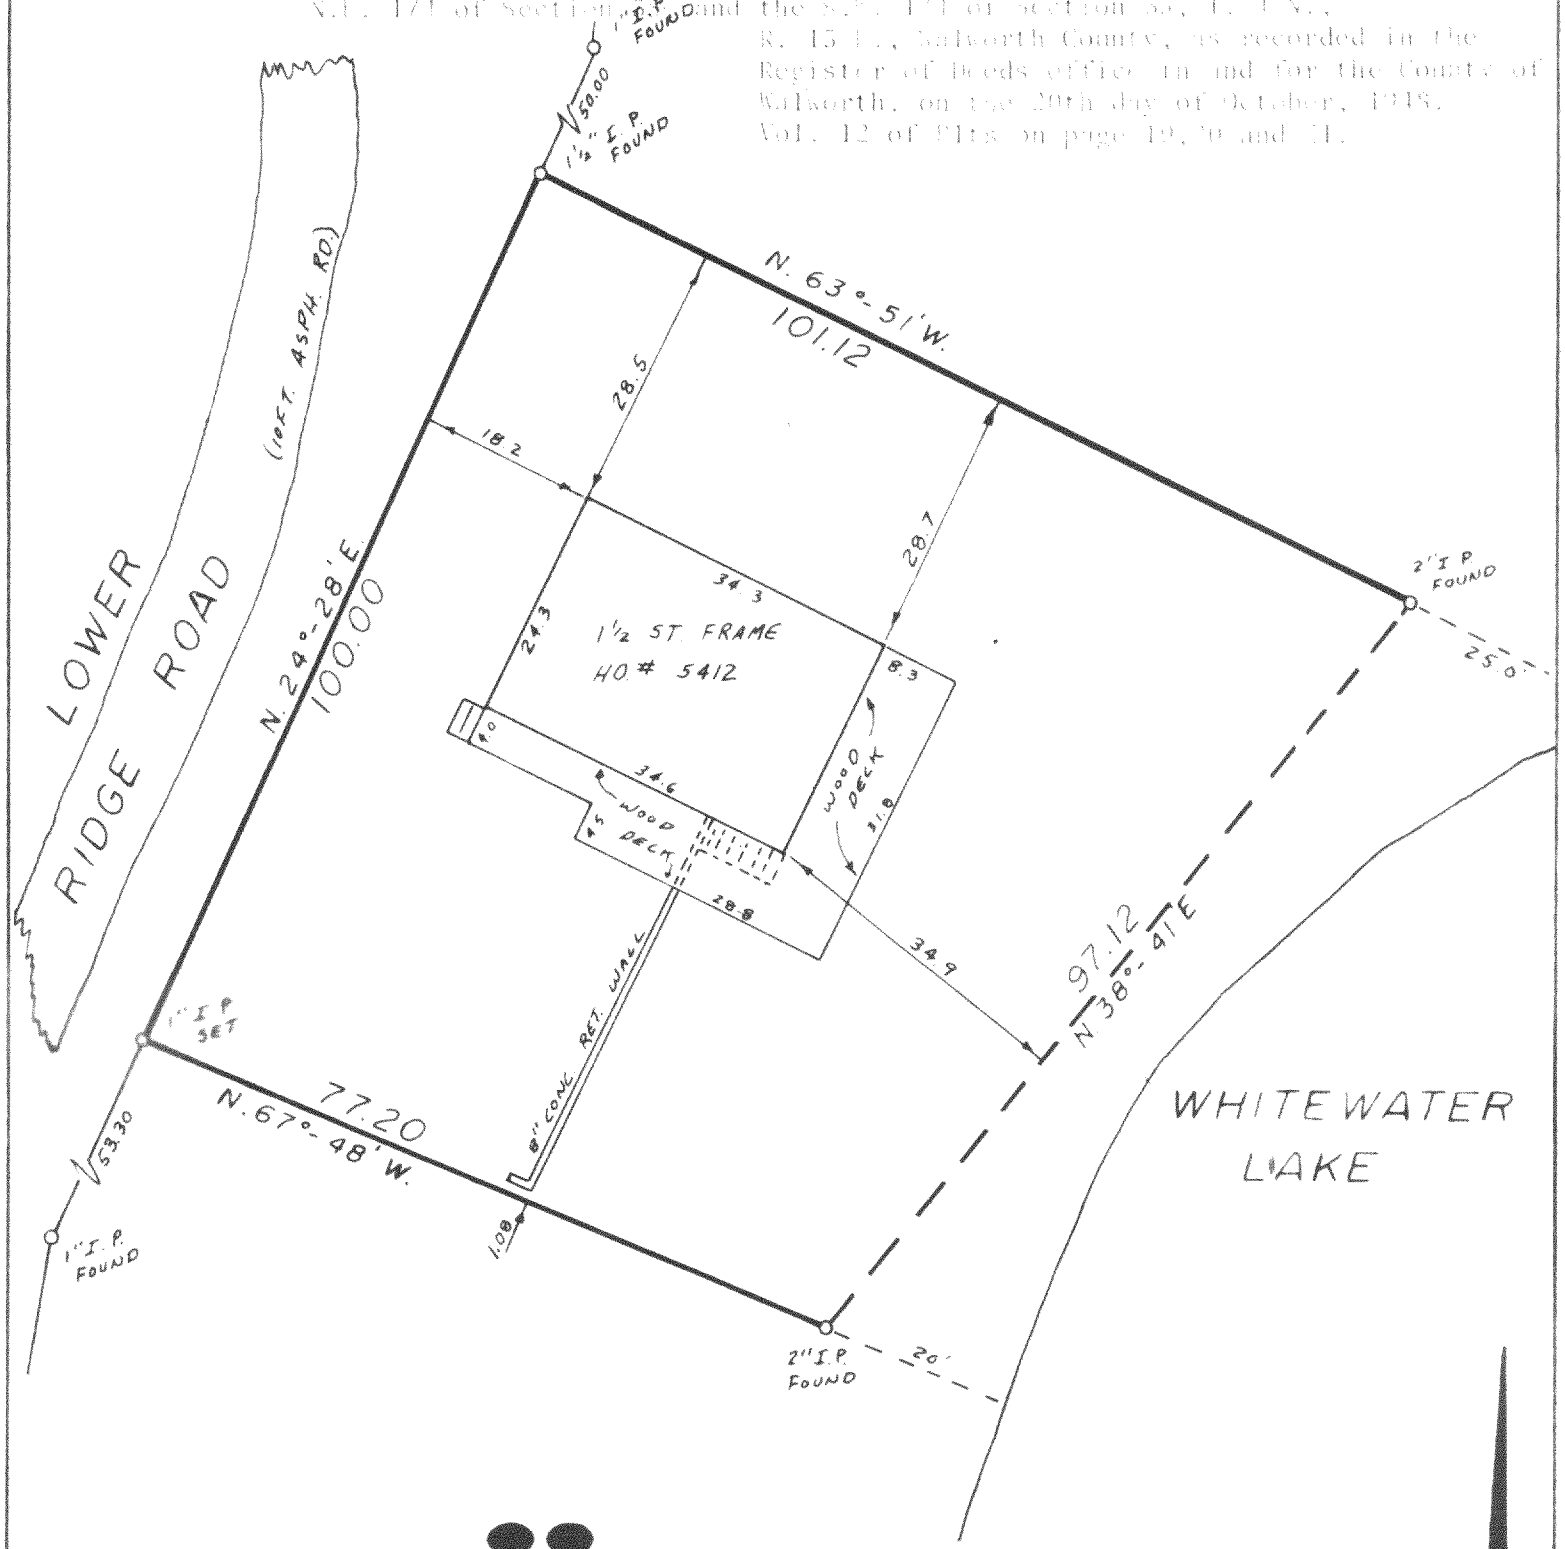

WISCONSIN
THOMAS INMAN
S-959
MILWAUKEE, WIS.
LAND SURVEYOR

INMAN SURVEY

Scale 1" = 20'

WEST OFFICE:
P.O. BOX 286
EAST TROY, WI 53120
(414) 642-3113

EAST OFFICE
11221 W. FOREST HOME AVE.
MILWAUKEE, WI 53130
(414) 425-2060

SURVEY CERTIFICATE

State of Wisconsin) ss
Milwaukee County

I certify that I have surveyed the above described (property) and the above map is a true representation thereof and shows the size and location of the Property, its exterior boundaries, the location and dimensions of all visible structures thereon, fences, apparent easements and roadways and visible encroachments, if any.

This survey is made for the exclusive use of the present owners of the Property, and also those who purchase, mortgage, or guarantee the title thereto within one (1) year from date hereof.

Thomas Inman

THOMAS INMAN, Registered Land Surveyor

DATE: 11-30-82
JOB NO.: 9987

415-227-I