
PLAT OF SURVEY

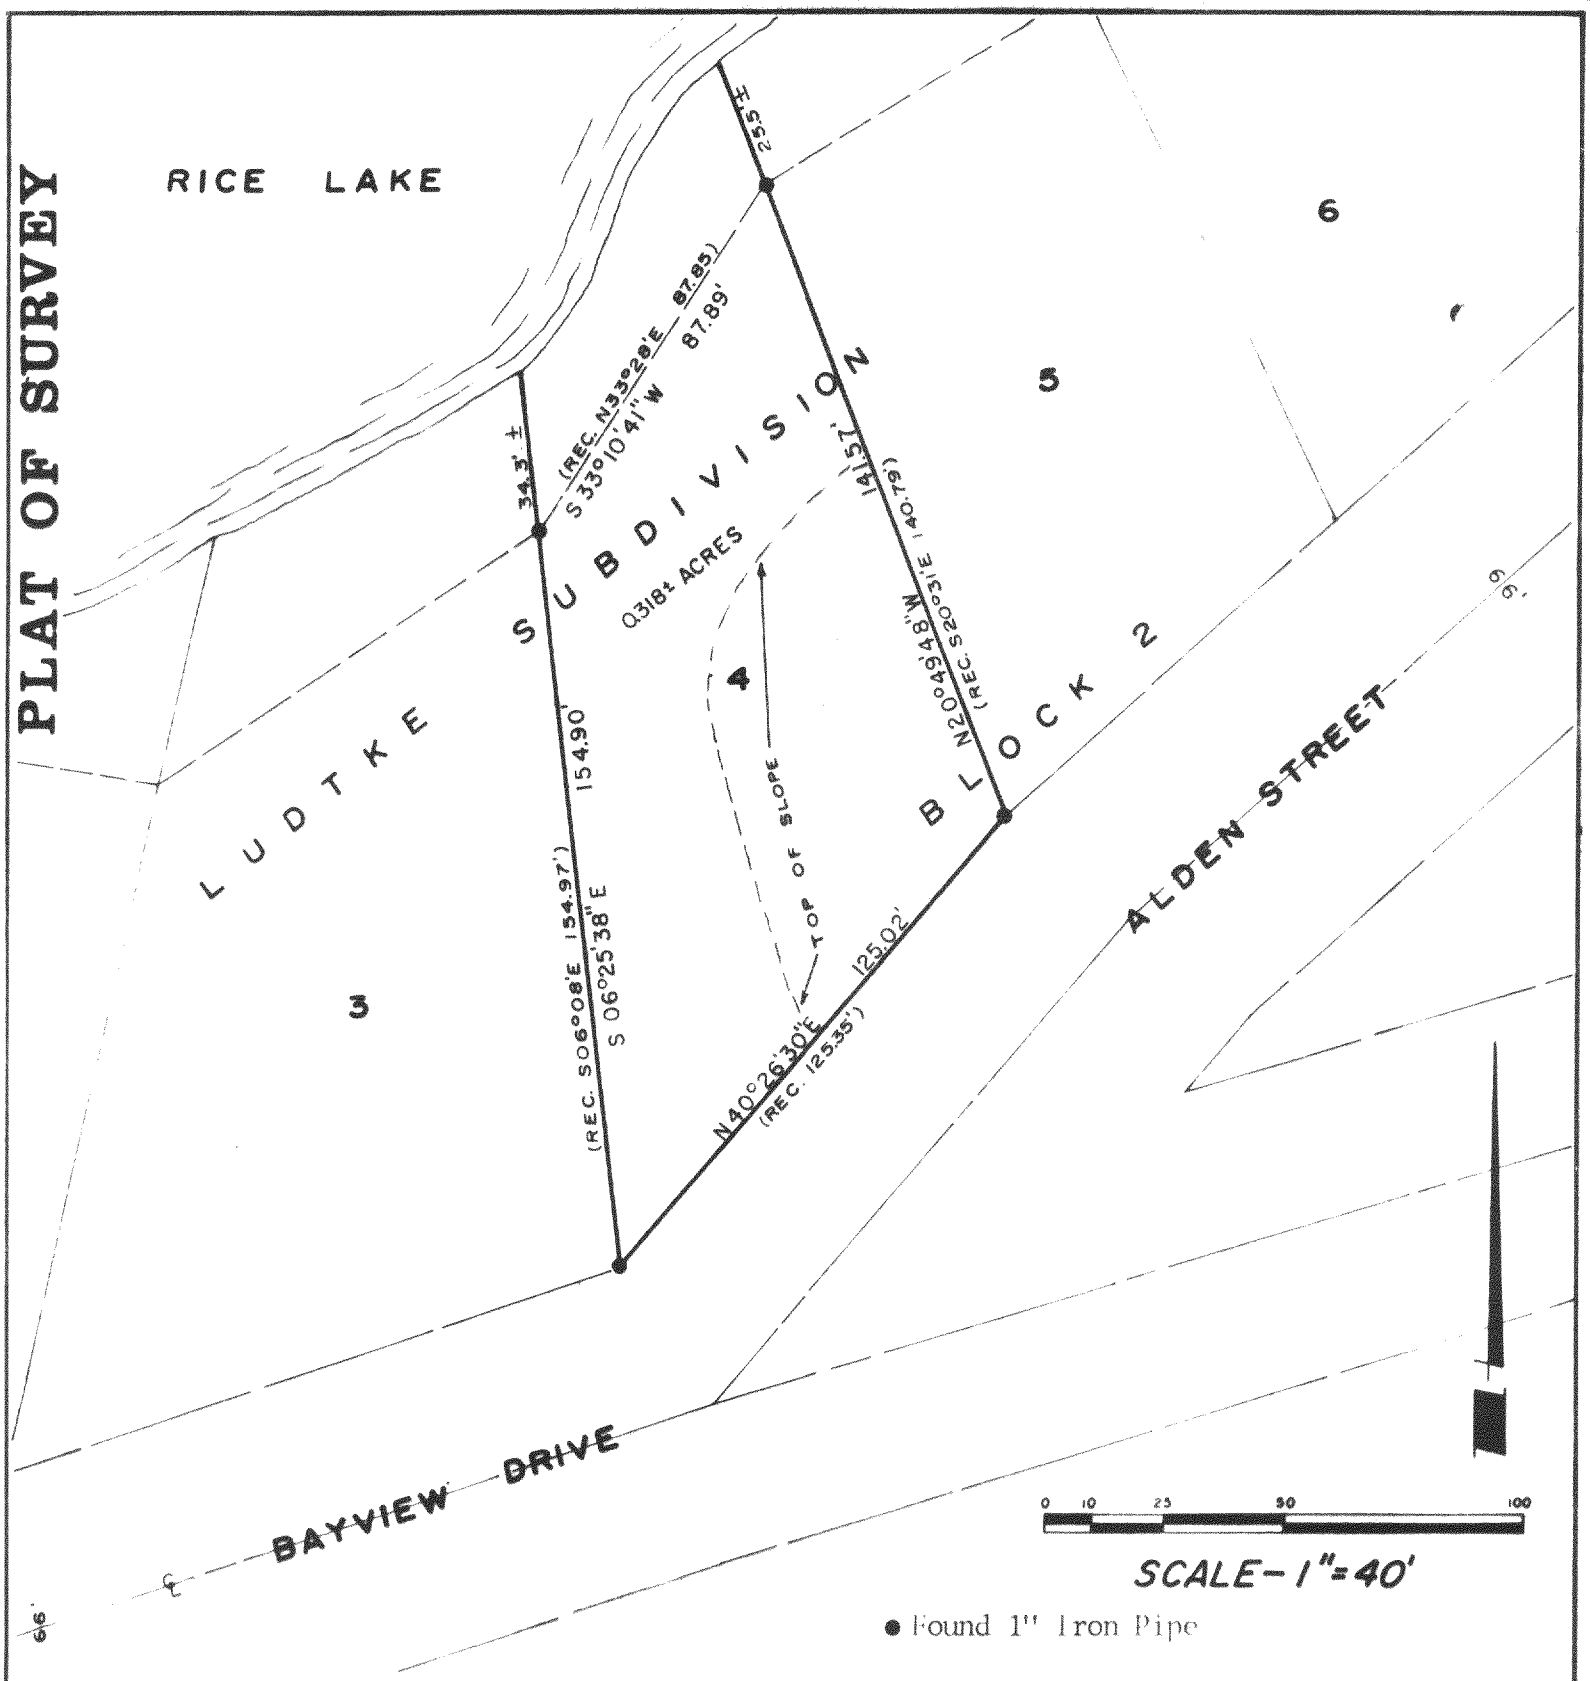

DESCRIPTION

Lot 4, Block 2, LUDTKE SUBDIVISION, in the SE¼ of Section 27 and the NE¼ of Section 34, T4N, R15E, Town of Whitewater, Walworth County, Wisconsin.

CERTIFICATION

I hereby certify that the property described above has been surveyed under my responsible direction and supervision and that this map is a correct representation of the lot lines and dimensions and the principle lines of the permanent structures thereon.

Date 8-20-79

James B. Woodman
Registered Land Surveyor S-1239

WISCONSIN JAMES B. WOODMAN S-1239 FORT ATKINSON, WIS. LAND SURVEYOR

Prepared For: Harry Devitt
Rauland Realty
112 South First Street
Whitewater, WI 53190

JN 79S-145

STRAND & WOODMAN ASSOCIATES
210 Madison Ave., Fort Atkinson, WI 53538
Land Surveyors & Engineers
Phone (414) 563-8162

DLS-7

415-240-8 ✓