
ROBERS & BOYD, INC.
CONSULTING ENGINEERS
LAND SURVEYORS

109 SOUTH SPRING STREET
BURLINGTON, WISCONSIN 53105
PHONE: 414-763-7834

PLAT OF SURVEY AND FOUNDATION RECERTIFICATION
FOR
EDWARD LANGE
OF

Lot 2 of Walworth County Certified Survey Map No. 1480 as recorded in Volume 7 of Certified Survey Maps on page 56 in the office of the Register of Deeds for Walworth County, said land being located in the Southwest 1/4 of the Northwest 1/4 of Section 2, Town 4 North, Range 15 East of the 4th Principal Meridian, Township of Whitewater, County of Walworth, State of Wisconsin.

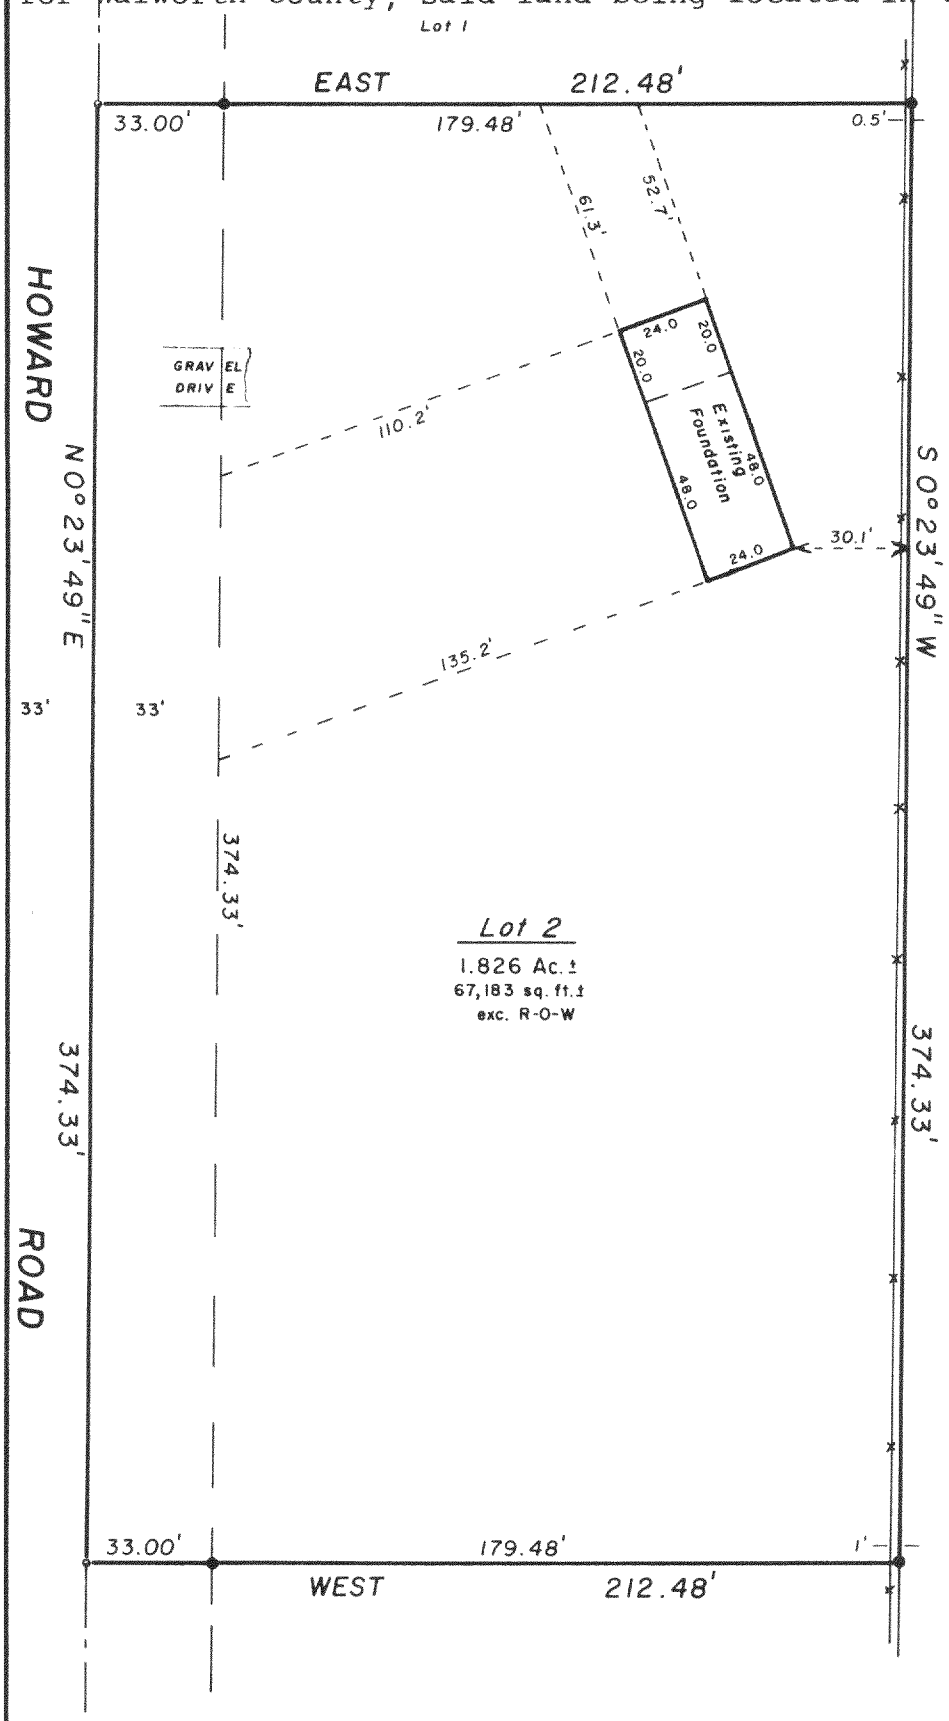

RECEIVED
JUL 31 1986

N

Bearings are based on the recorded map.

"I hereby certify that I have surveyed the above described property and that the above map is a true representation thereof and shows the size and location of the property, its exterior boundaries, the location of all visible structures and dimensions of all principal buildings thereon, boundary fences, apparent easements, roadways and visible encroachments, if any.

"This survey is made for the use of the present owners of the property, and also those who purchase, mortgage, or guarantee the title thereto within one year from date hereof."

NO MONUMENTATION HAS BEEN WAIVED IN ACCORDANCE WITH A-E 5.01(b) OF THE WISCONSIN ADMINISTRATIVE CODE.

WISCONSIN
GEORGE J. APPEL
S-1612
DELAVAN, WI
LAND SURVEYOR

LEGEND

+	CHISEL CUT IN CONCRETE
○	PK NAIL FOUND
●	FOUND IRON PIPE - 1"
◪	FOUND IRON PIPE -
○	SET IRON PIPE -
●	FOUND BRASS CAPPED MONUMENT
⊕	FOUND CONCRETE MONUMENT
—x—x—	FENCE
( )	RECORDED AS
/	EXISTING GROUND ELEVATION

SCALE - 1" = 50'

415-248 ✓

George J. Appel
WISCONSIN REGISTERED LAND SURVEYOR

7/2/86
DATE

FIELD WORK BY GJA, GS

DRAWN BY GJA

86156
JOB NUMBER

K & E DA1480-2