
RECEIVED
OCT 14 1986

DETAIL OF TREE LINE

LOCATED ALONG THE NORTHEASTLY LINE OF LOT 14 OF BLOCK 1 OF MINNIESKA SUBDIVISION, LOCATED IN THE N.E. ¼ OF SECTION 35, T4N, R15E, WALWORTH COUNTY, WISCONSIN

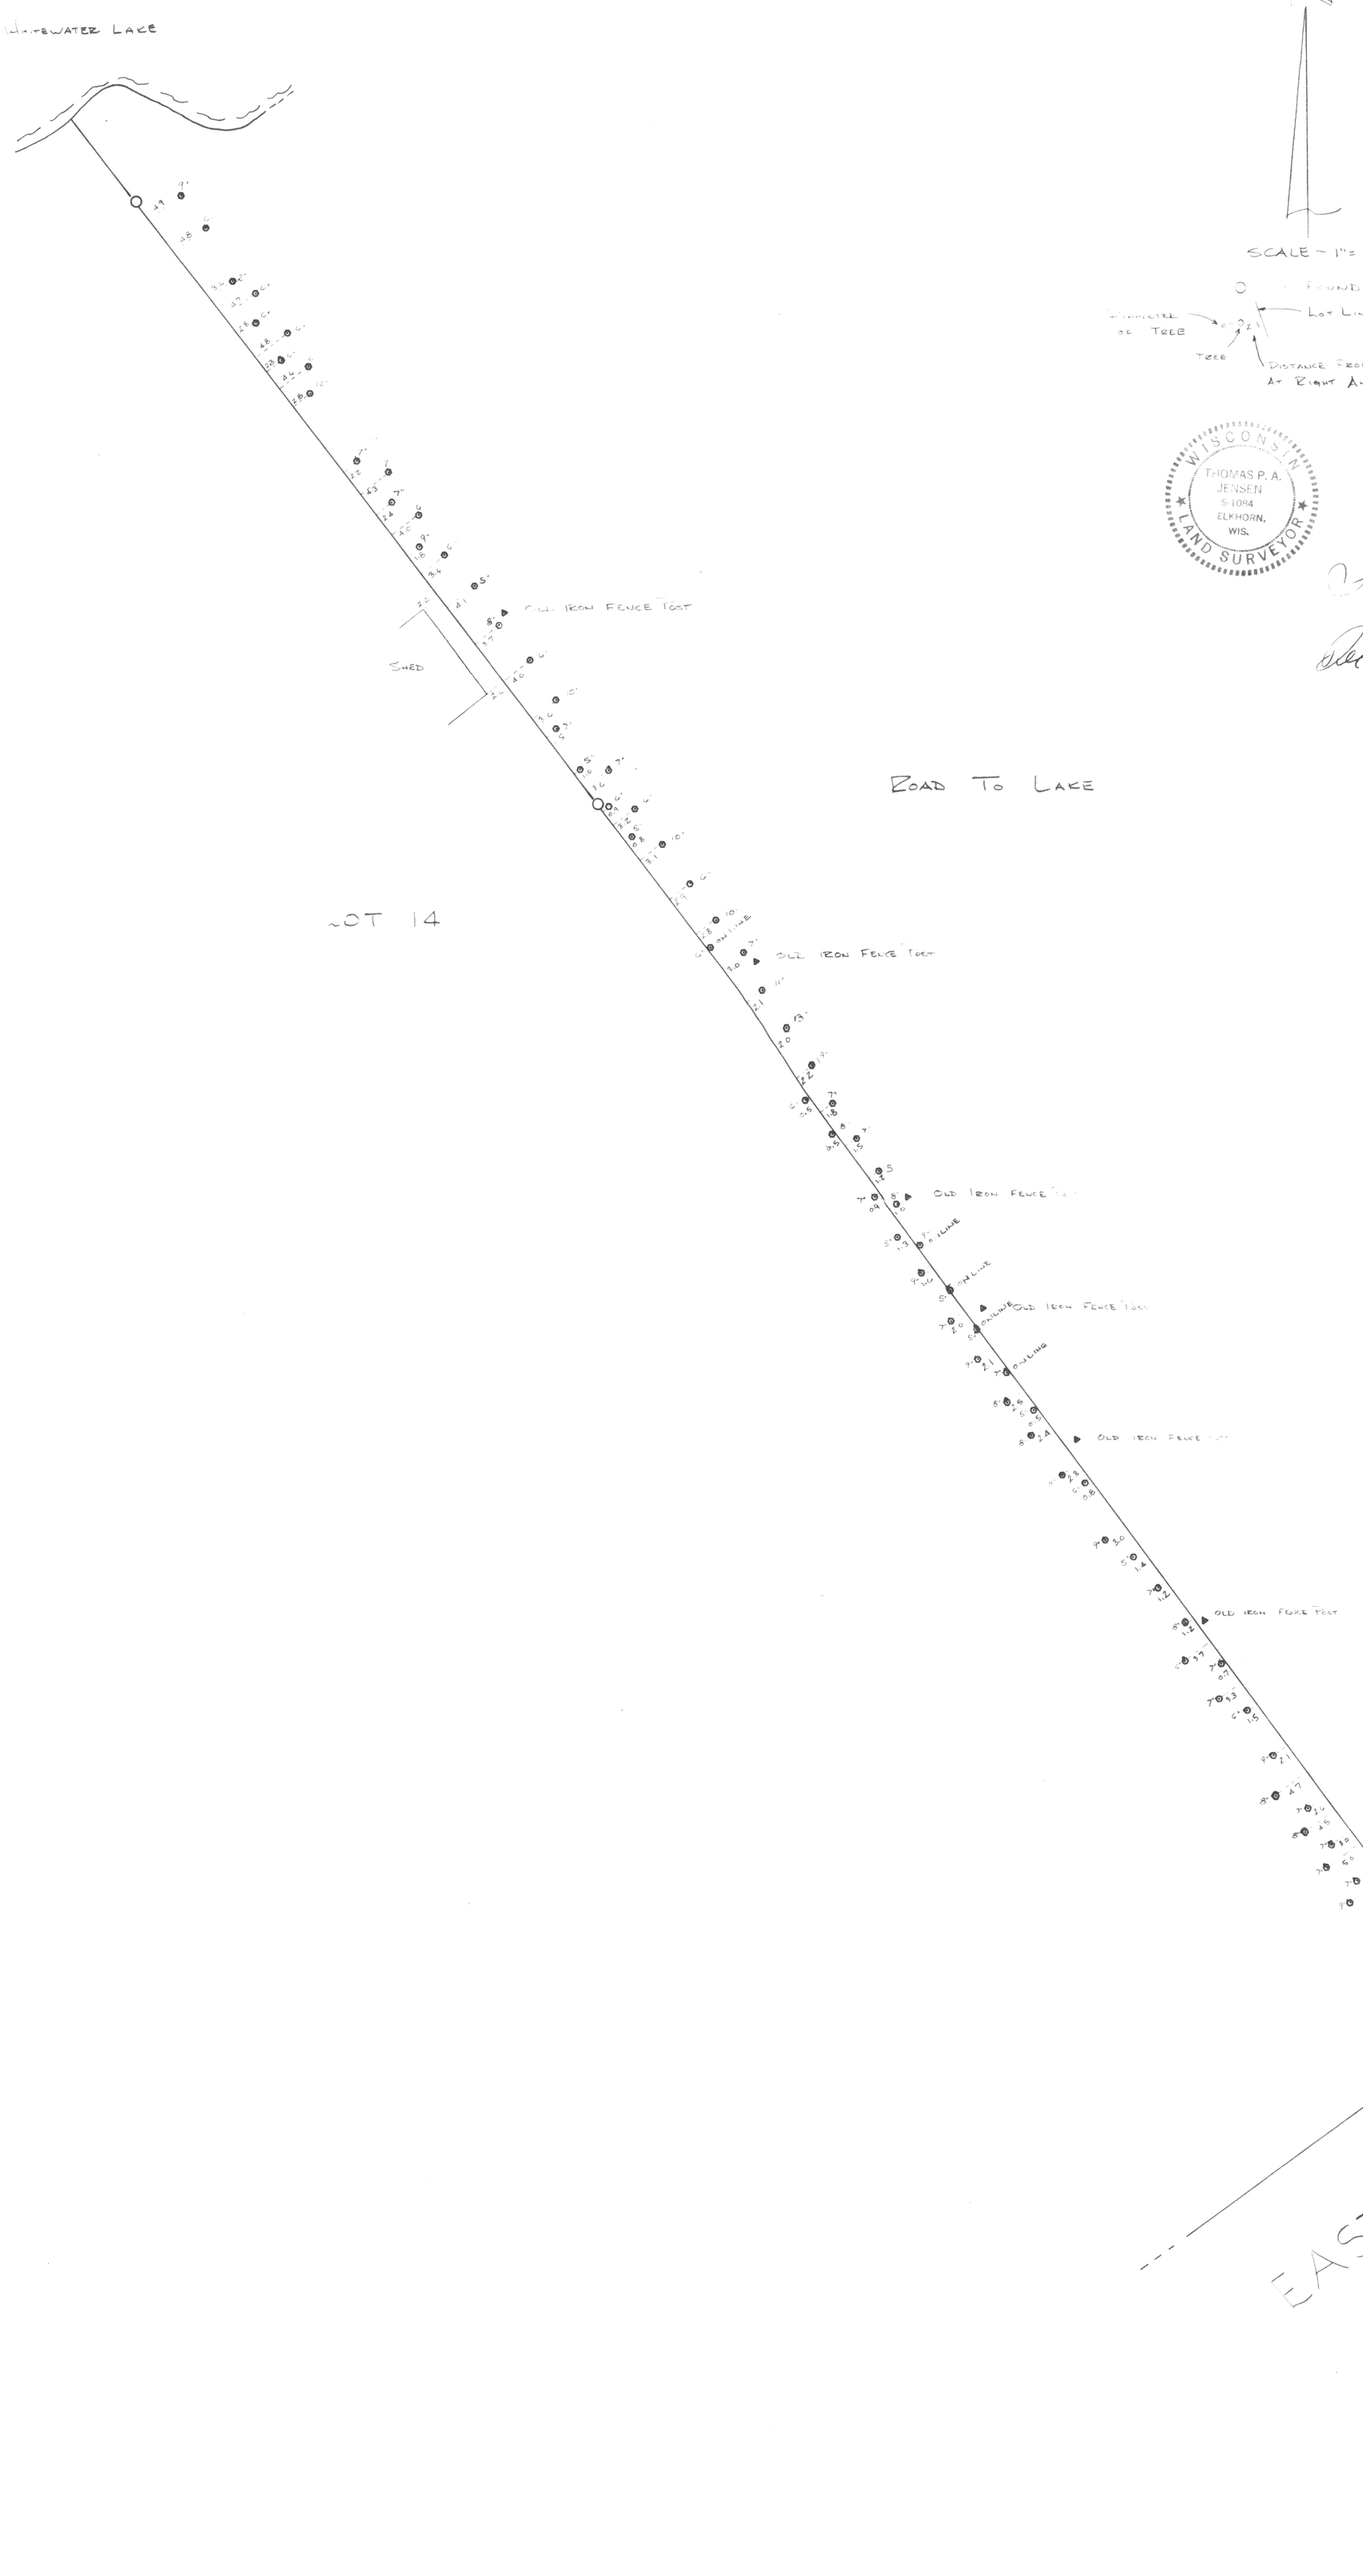

SCALE ~ 1" = 10

○ - FOUND IRON PIPE

LOT LINE

DISTANCE FROM LOT LINE AT RIGHT ANGLES

WISCONSIN
THOMAS P. A. JENSEN
S-1084
ELKHORN, WIS.
LAND SURVEYOR

Dec 10, 1985

1985102

41-257