
D. D. COOPER & CO., INC.
Daniel D. Cooper
Rt. 4 Box 508B
Elkhorn, WI 53121

RECEIVED
AUG 11 1987

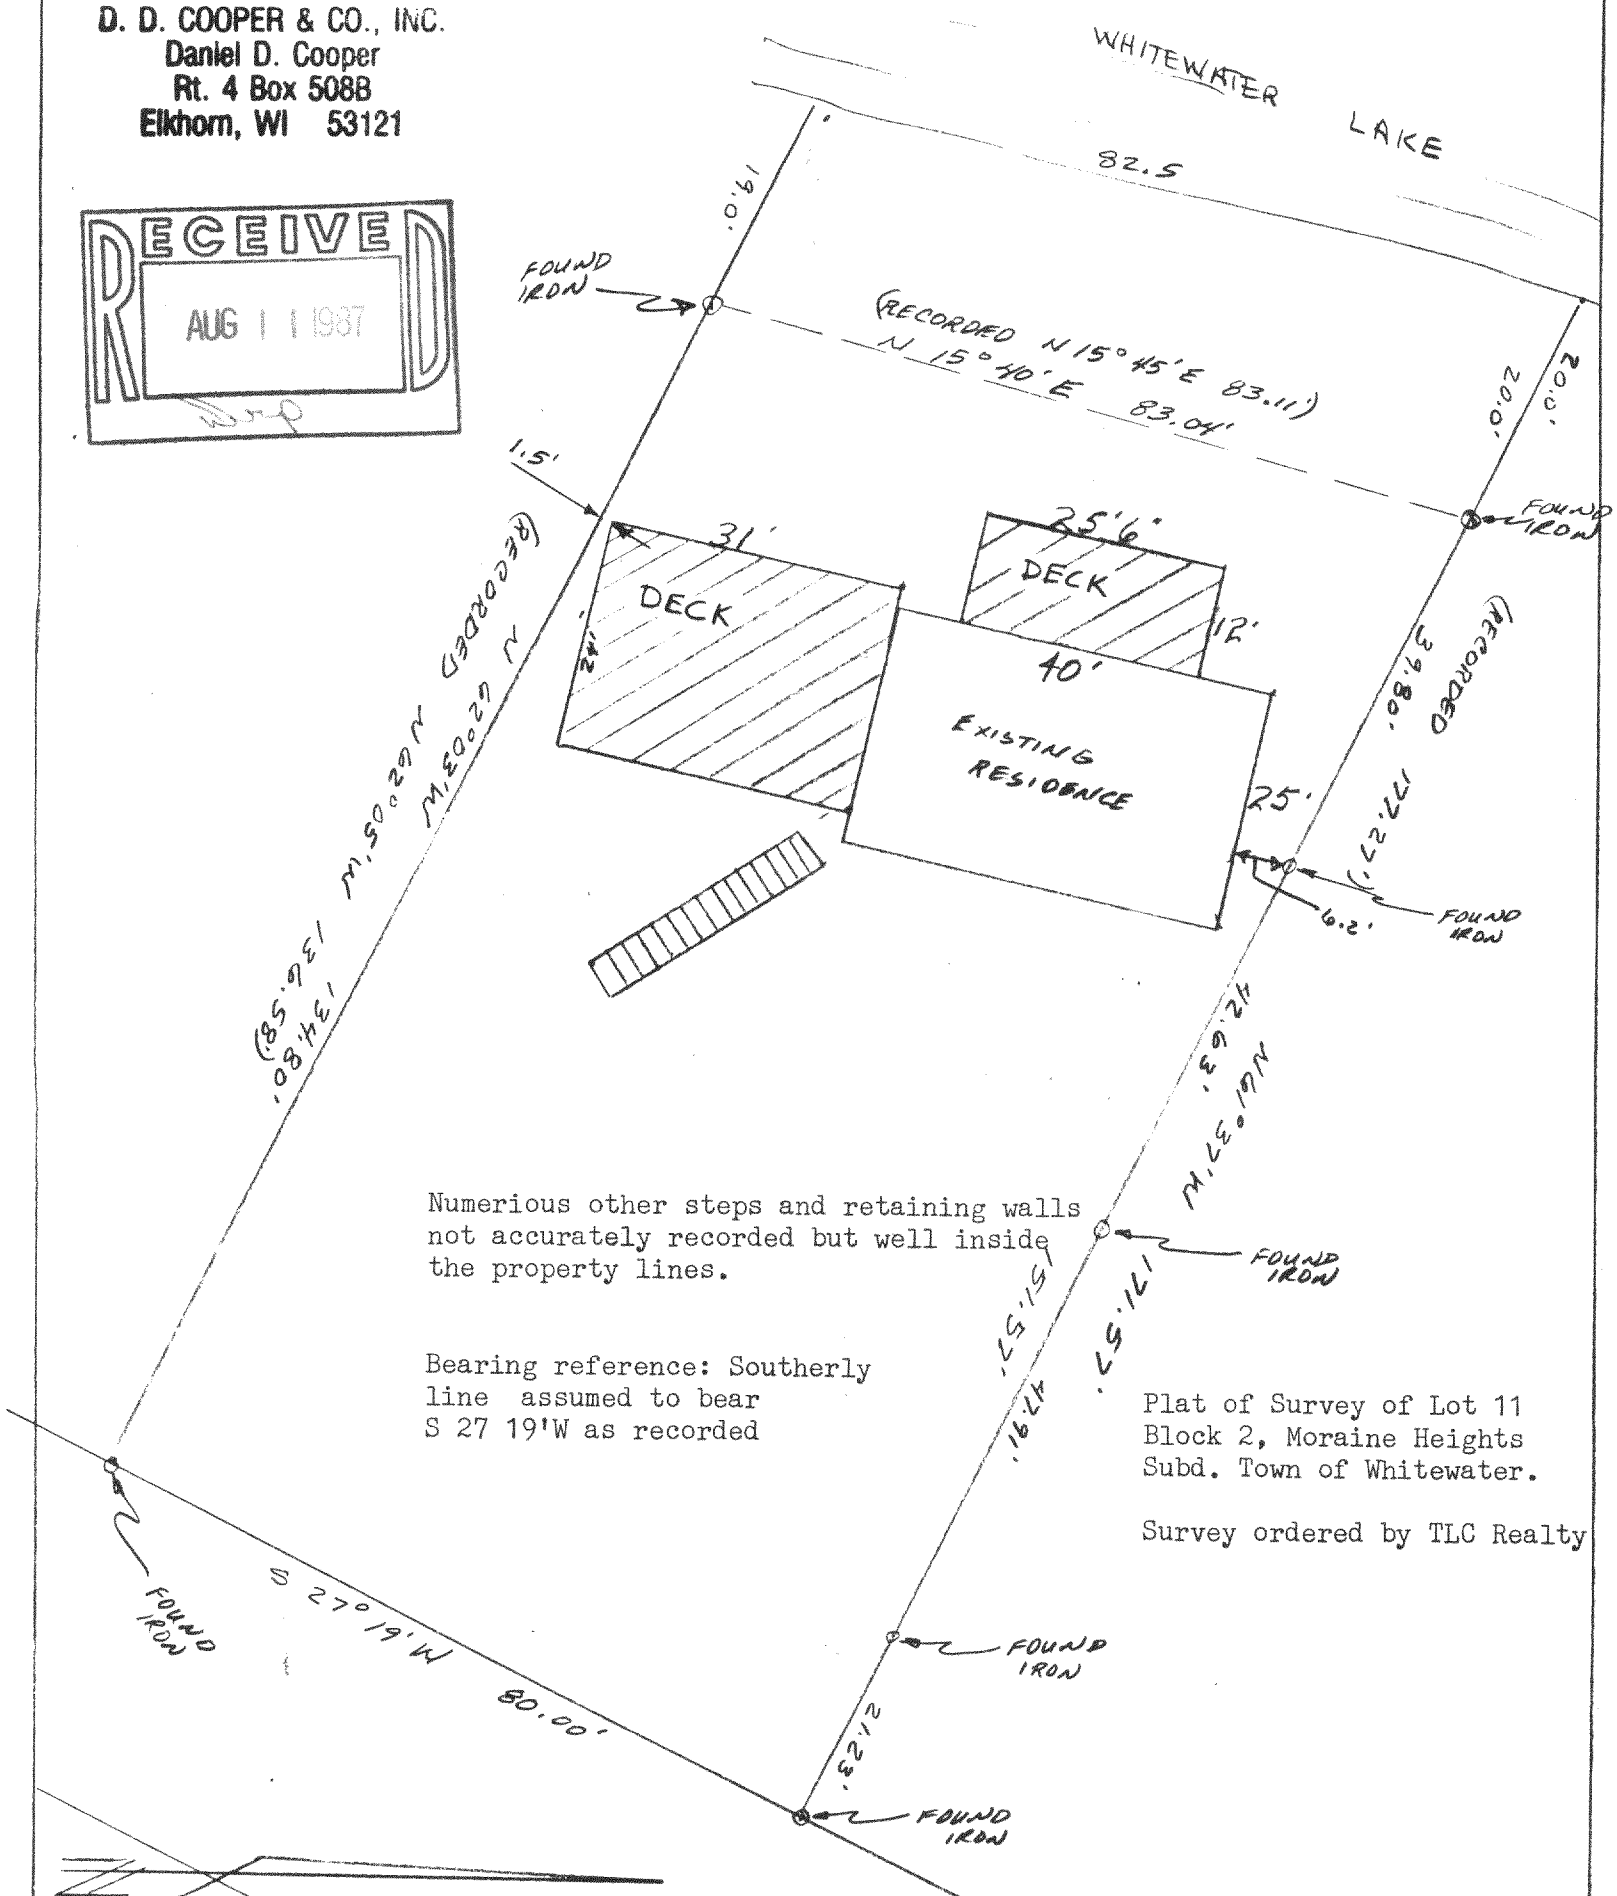

Numerious other steps and retaining walls not accurately recorded but well inside the property lines.

Bearing reference: Southerly line assumed to bear S 27 19'W as recorded

Plat of Survey of Lot 11 Block 2, Moraine Heights Subd. Town of Whitewater.

Survey ordered by TLC Realty

I hereby certify that I have surveyed the property described hereon and that the above is a true and accurate representation thereof to the best of my professional knowledge and belief.

Dated this 21 day of July 1987

Daniel D. Cooper, RLS No. S-1464

WISCONSIN
DANIEL D. COOPER
S-1464
WIS.
LAND SURVEYOR

DMH-HS

DRAWING NO. 3009

415-274