
D. Cooper & CO., INC
Rt 4 Box 508B * Elkhorn WI 53121

Lot line adjustment

Part of Lot 9, Block 1, of Moraine Park Subdivision, being located in Section 34, T4N, R15E, Walworth County, Wisconsin and more particularly described as follows: Beginning at an iron pipe on the Northerly line of said lot 9 which is located S70 54'E 66.30 feet from the Northwest corner of said lot 9; thence S67 55'E 67 feet more or less to the shore of Whitewater Lake; thence Northeasterly 3.7 feet along the shore to the Northerly line of said lot 9; thence N70 54'W 67.12 feet more or less along the Northerly line of said lot 9 to the point of beginning.

Bearing reference: Northerly line of Lot 9 assumed to bear N70 54'W

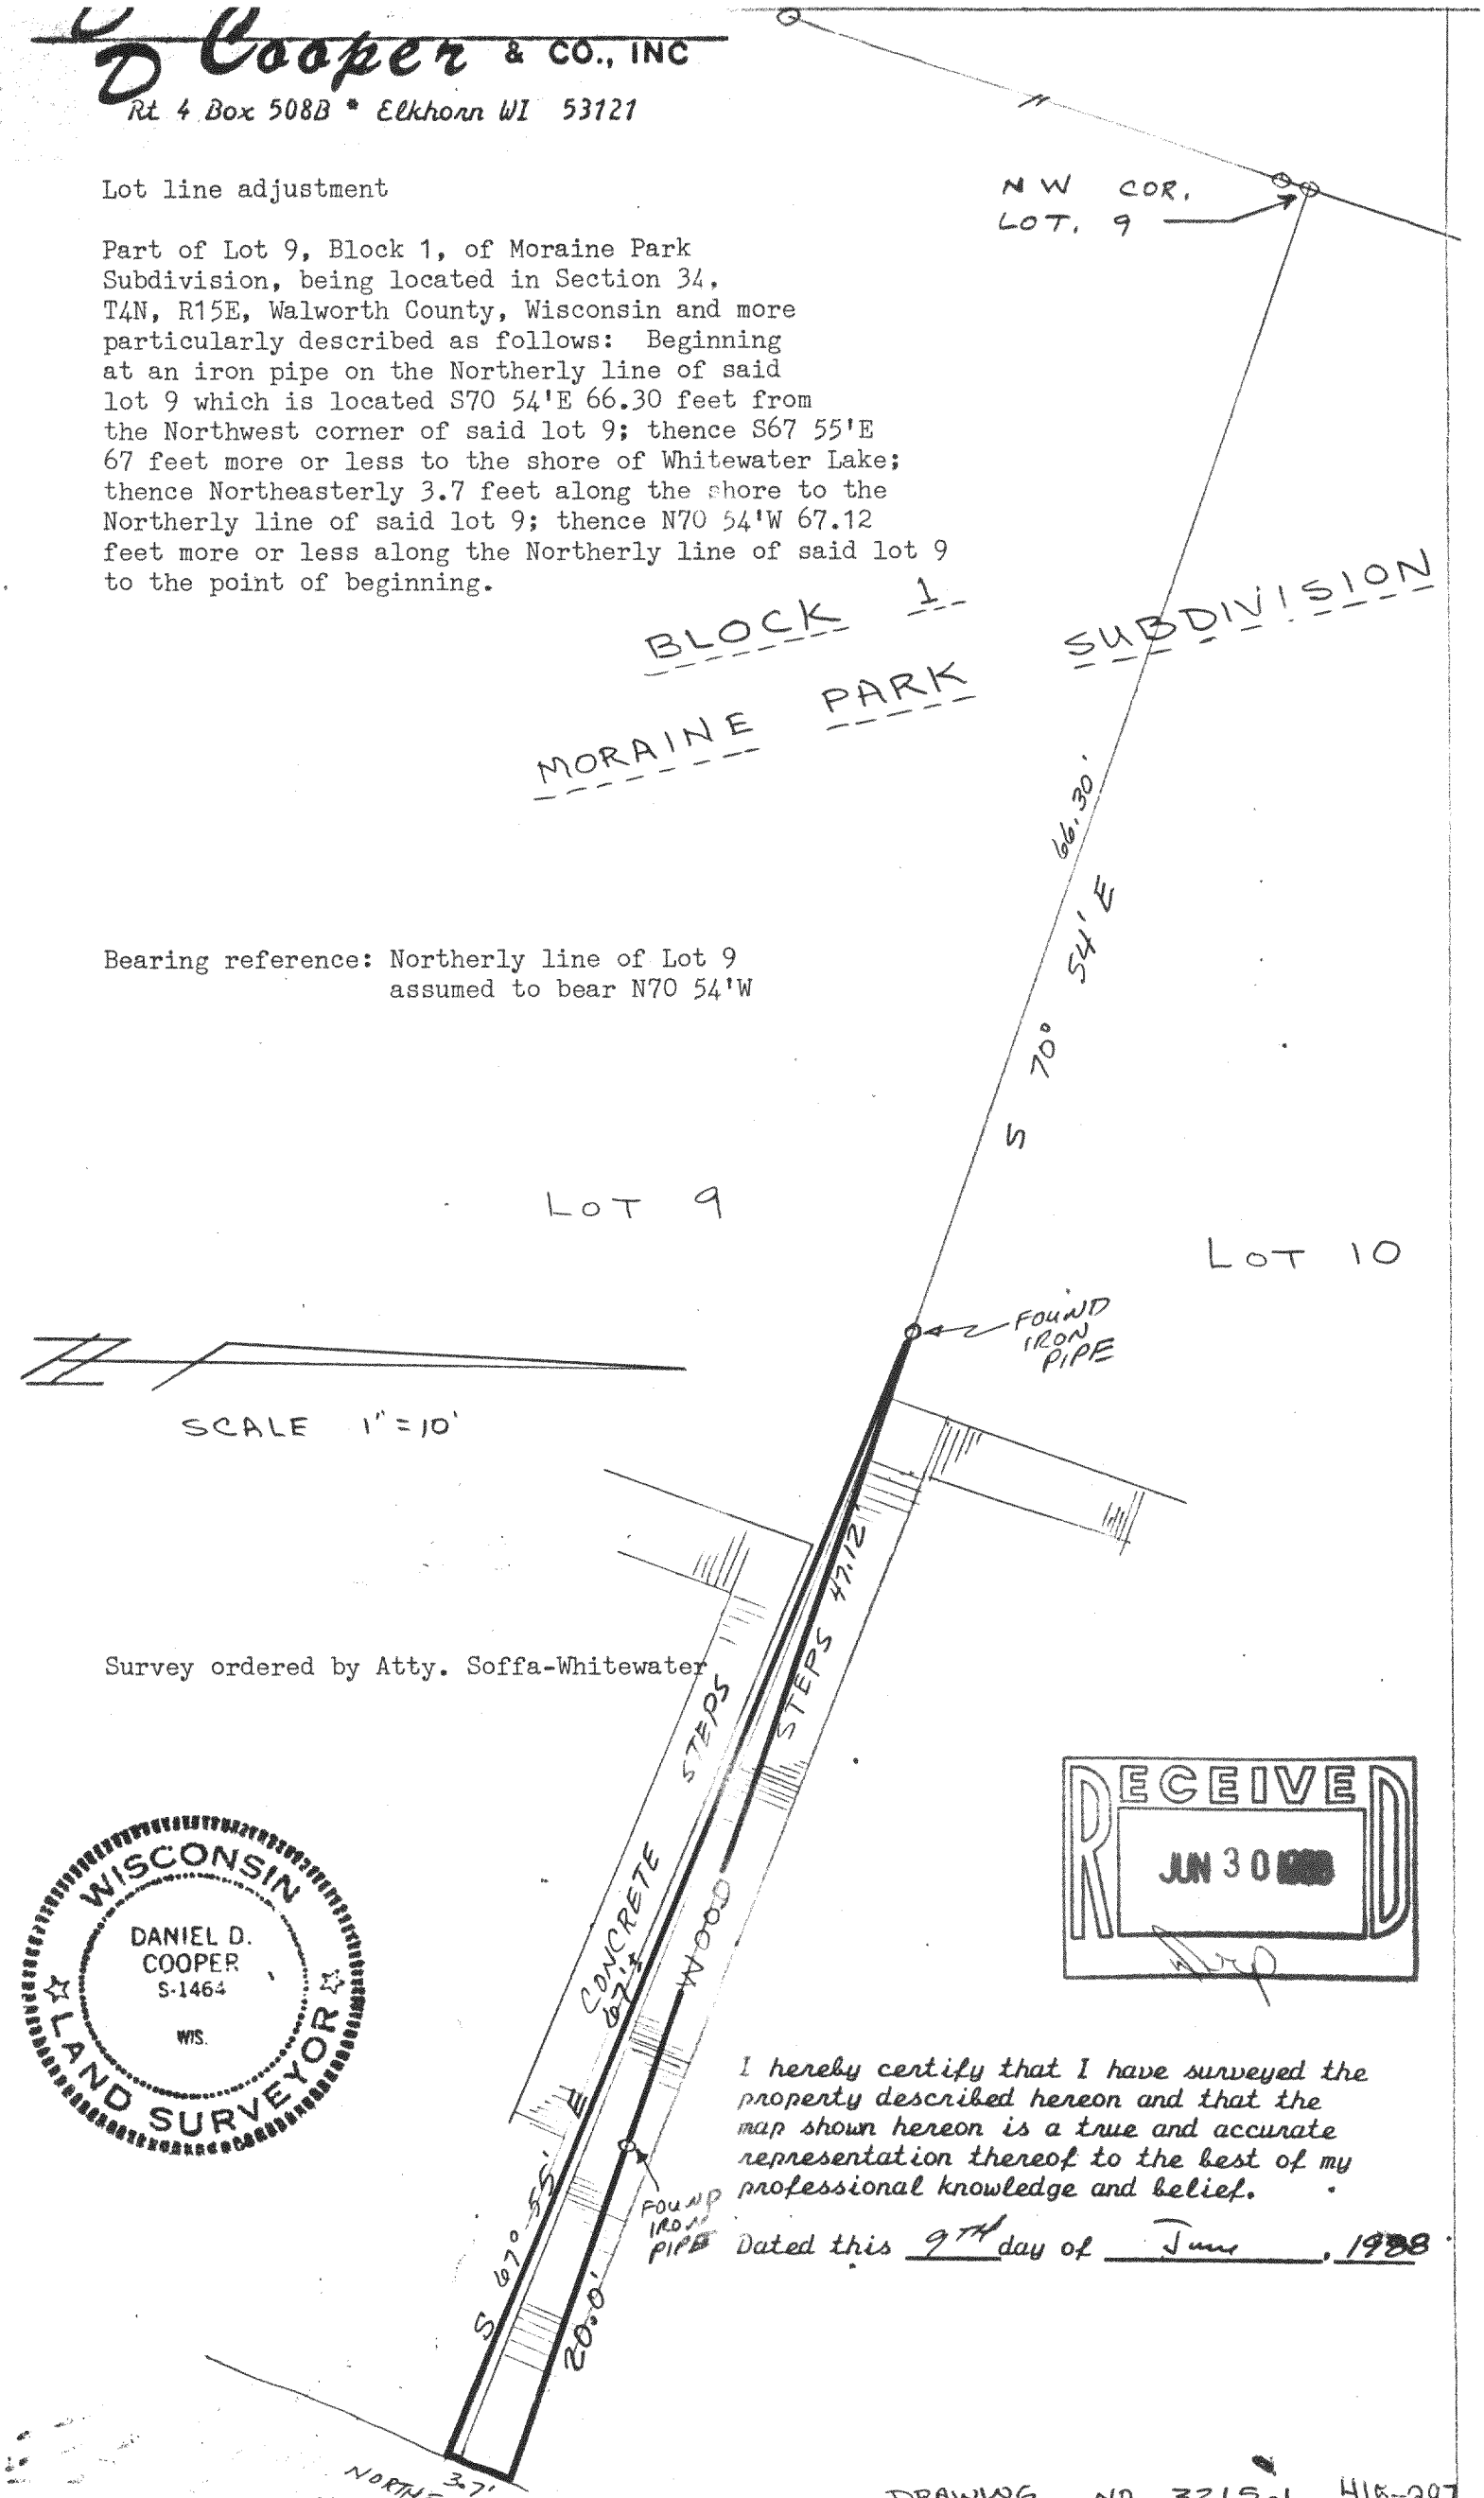

Survey ordered by Atty. Soffa-Whitewater

WISCONSIN
DANIEL D. COOPER
S-1464
WIS.
LAND SURVEYOR

RECEIVED
JUN 30 [redacted]

I hereby certify that I have surveyed the property described hereon and that the map shown hereon is a true and accurate representation thereof to the best of my professional knowledge and belief.

Dated this 9TH day of June, 1988.

DRAWING NO. 3215.1 415-297