

SHAGBARK ROAD

556° 39' 00" W 153.90'

N 61° 36' 30" E 144.82'
(REC. N 61° 34' E 144.80')


S 29° 26' 00" E 250.40'
(REC. S 29° 24' 00" E 250.44')

Plat of Survey of Lot 7 of Scattered Oaks Subdivision
being located in the Town of Whitewater, Walworth county,
Wisconsin.

Survey ordered by Century-21 Whitewater

Bearings referenced to Original Plat

Scale 1"=1'

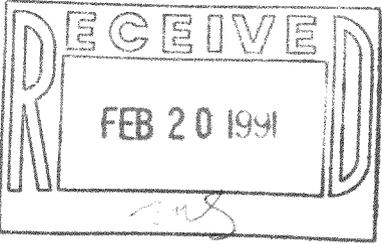

LOT 8

LOT 7

EXISTING RESIDENCE

WELL

SEPTIC VENT

DRIVEWAY EASEMENT
ARC = 87.2 R = 130'

N 78° 20' E 29.86'

S 82° 27' E 85.60'

A driveway easement located on Lot 8 of Scattered Oaks, a subdivision located in the Southwest 1/4 of Section 36, and the Southeast 1/4 of Section 35 all in Town 4 North, Range 15 East, Walworth County, Wisconsin; the centerline of said easement being more particularly described as follows:

Commencing at an iron rod marking the most Westerly corner of said Lot 8; thence South 27° 32' East, 164.3 feet along the line between said Lot 8 and Lot 7 of Scattered Oaks to the point of beginning of said centerline; thence North 78° 20' East, 39.8 feet; thence Easterly 87.2 feet along the arc of a curve to the right having a radius of 130 feet and chord South 82° 27' East, 85.6 feet to the end of said centerline in the Northwestern right-of-way line of Deep Pond Road.

I hereby certify that I have surveyed the property described hereon and that the map shown hereon is a true and accurate representation thereof to the best of my professional knowledge and belief.

Dated this 25 day of July, 1990

Daniel D. Cooper, RLS No. S-1464

TAX KEY #

DSO - 7

DRAWING NO. 3602 415-319

ORIGINAL COPY ONLY IF SEALED IN RED INK

D Cooper & CO., INC
Rt 4 Box 508B * Elkhorn WI 53121

Reduced