
RICE

LAKE

E= 105.00'

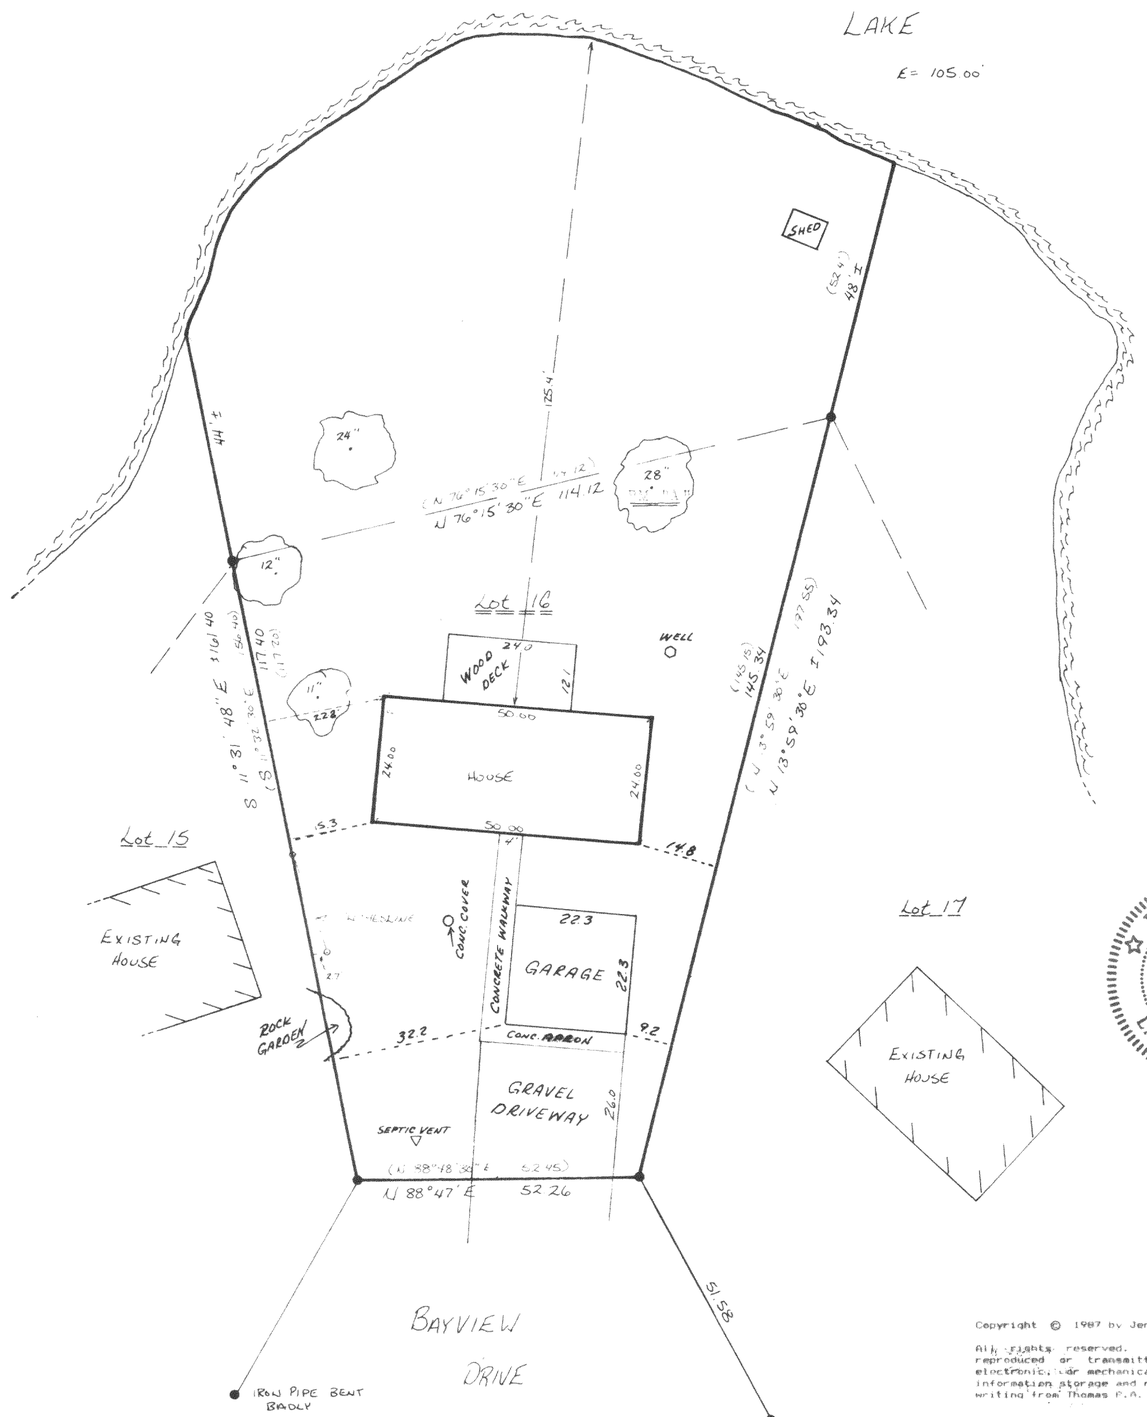

Lot 17

EXISTING HOUSE

Plat Of Survey

Lot 16, Block 2, in the Sub division, located in the Southeast 1/4 of Section 35, the Southwest 1/4 of Section 36, and the Northeast 1/4 of Section 34, Town 4 North, Range 15 East, Town of Whitewater, Walworth County, Wisconsin.

Surveyed for: Ingalls, Bob
5824 Mon Ilora Dr.
Greendale, WI. 53129

Surveyed by: Jensen Surveying & Mapping S.C.
45 S. Wisconsin St. P.O. Box 492
Elkhorn, Wisconsin. 53121

Mapping date: April 5, 1967.

House staked and elevations taken: April 5, 1967.

REVISED: 8-19-93

FOR CENTURY 21 REALTY

Elevations at entrance house corners.

1. = 111.1
2. = 111.1
3. = 111.1
4. = 111.2

SCALE: 1"=20'

LEGEND

- = Found iron pipe
- = Set spike.
- = Set wood stake.--- 5' Offset
- ( ) Record or dimension.

Elevations referenced to the water level of Pine Lake on April 5, 1967. Assumed as 100.00'.

Benchmark "A"-- Railroad spike set in the East face of a 28" tree.
Elevation = 111.00

Bearings referenced to the Subdivision Plat.

Point Pal

RECEIVED
JAN 17 1994
dg

WISCONSIN
THOMAS P.A. JENSEN
S-1084
Elkhorn, WI
LAND SURVEYOR

I, Thomas P.A. Jensen, Wisconsin Registered Land Surveyor, do hereby certify that this survey was performed by me, or under my direction, in full compliance with the owner's/agent's instructions and Chapter A-E 5 of the Wisconsin Administrative Code "Minimum Standards For Property Surveys"; and that this map is an accurate representation thereof to the best of my knowledge and belief.

Thomas P.A. Jensen R.L.S-1084
Jensen Surveying & Mapping S.C.

Copyright © 1987 by Jensen Surveying & Mapping S.C.

All rights reserved. No part of this survey plat may be reproduced or transmitted in any form by any means - graphic, electronic, or mechanical, including photocopying, tracing, or information storage and retrieval systems - without permission in writing from Thomas P.A. Jensen, Jensen Surveying & Mapping S.C.

DLS-19

415-411

1987.020 X
1993.089